



BENJAMIN THOMPSON & ASSOCIATES, INC.
ARCHITECTURE, PLANNING, AND URBANISM
ONE STORY STREET
CAMBRIDGE, MA 02138
(617) 876-4900 FAX (617) 861-9212, 868-0028

Cosentini Consulting Engineers
44 Brattle Street
Cambridge, Massachusetts 02138
(617) 876-3830 FAX (617) 876-6647

LeMessurier Consultants
1033 Massachusetts Avenue
Cambridge, Massachusetts 02138
(617) 868-1200 FAX (617) 861-7520

RENOVATIONS TO 51 BRATTLE STREET

#220-77


RECORD SET 15 FEB. 91

REVISION	DATE	DESCRIPTION
23	JAN 91	REAR PERIMETER REV.


SITE DETAILS COURTYD./REARYD.

SCALE	DATE	JOB NO.
1/2" = 1'-0"	17 AUG 90	8912.00


D1.2

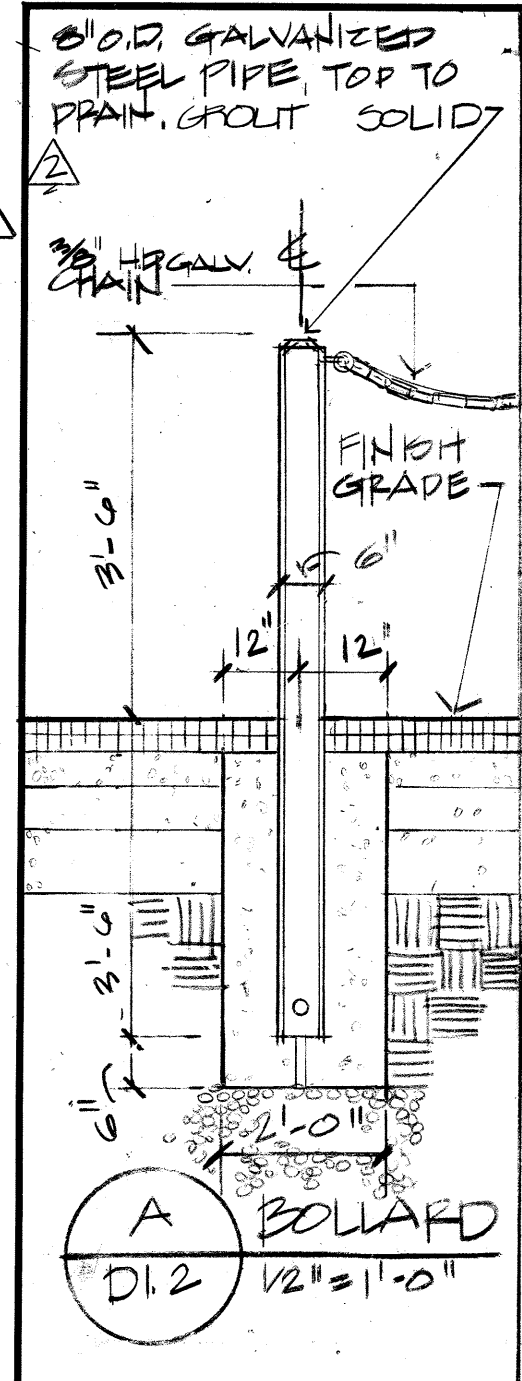


A BOLLARD
D1.2 1/2" = 1'-0"

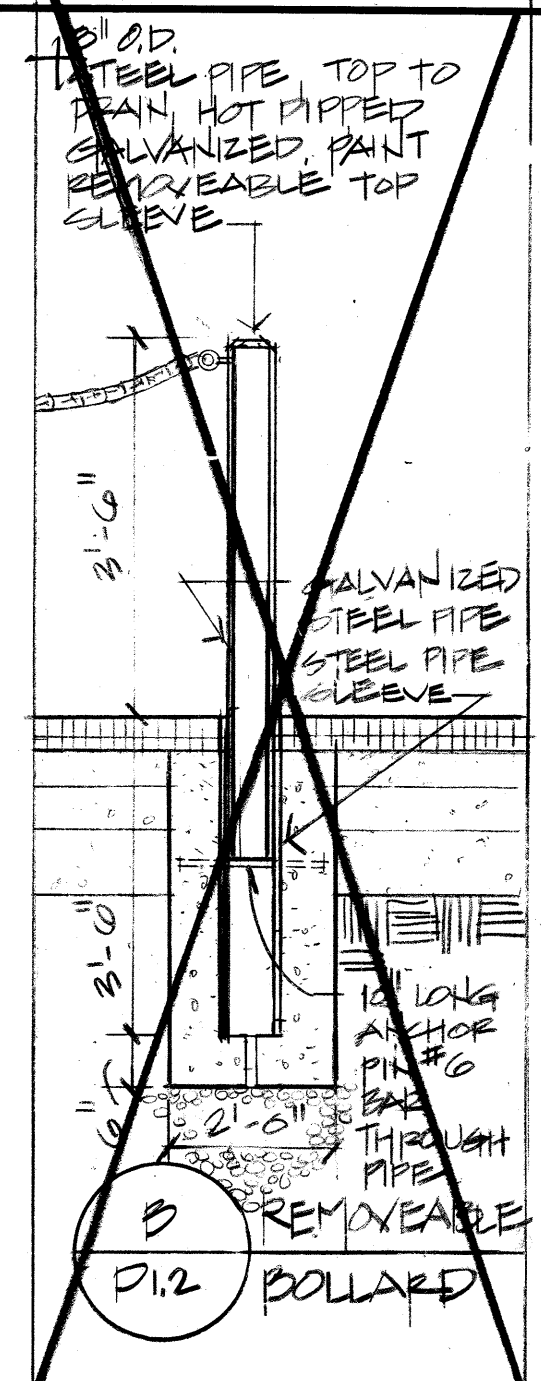


B REMOVEABLE BOLLARD
D1.2 1/2" = 1'-0"

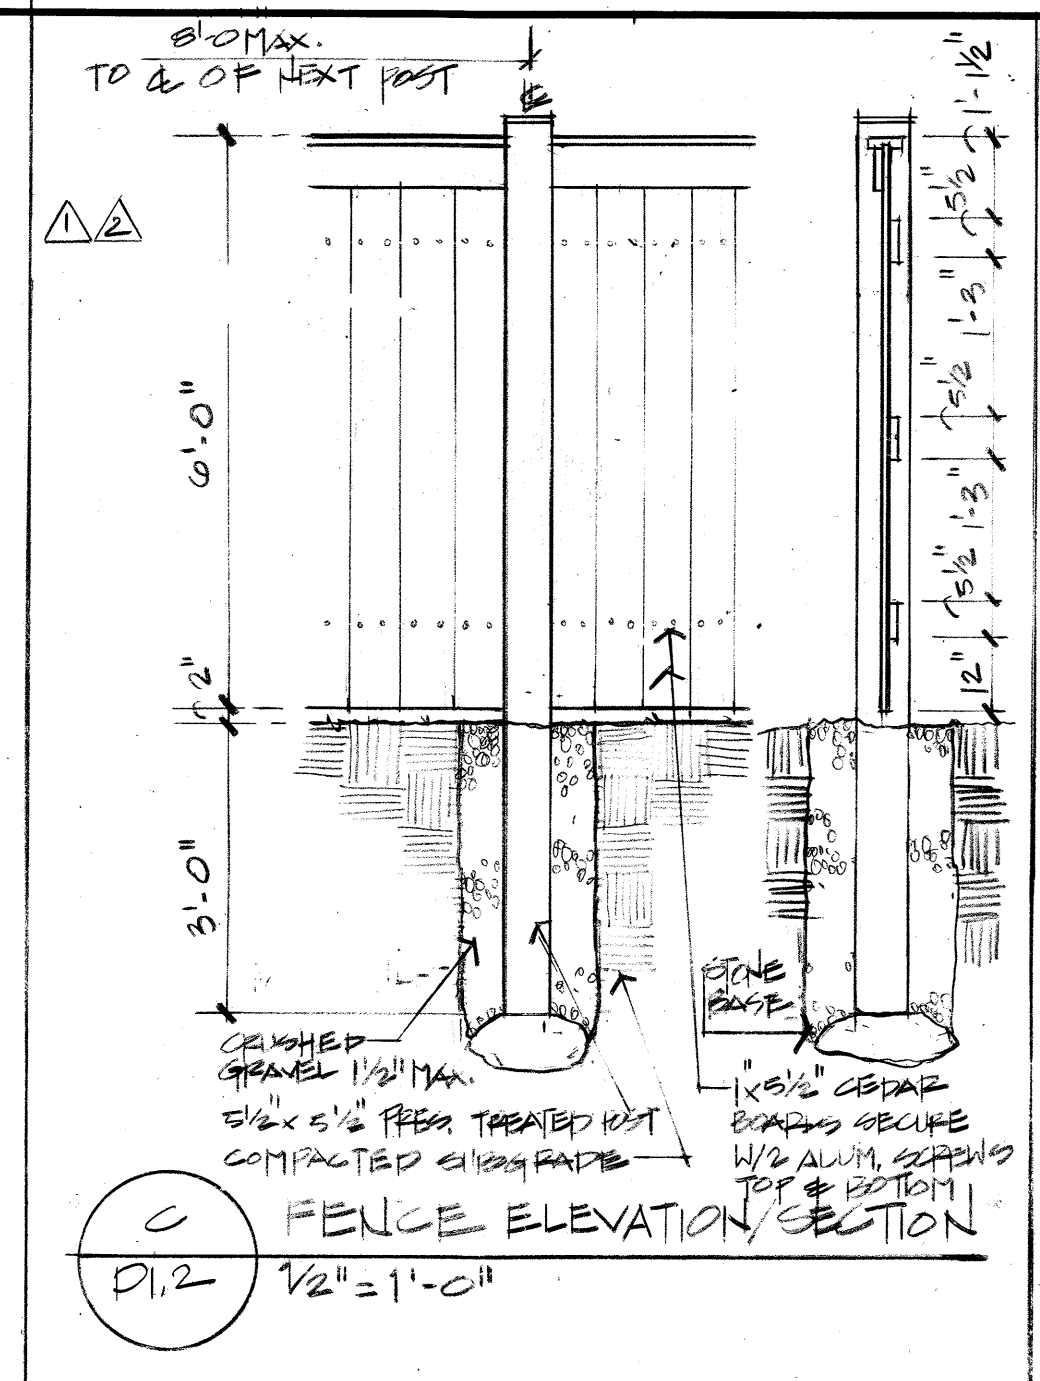


C FENCE ELEVATION/SECTION
D1.2 1/2" = 1'-0"

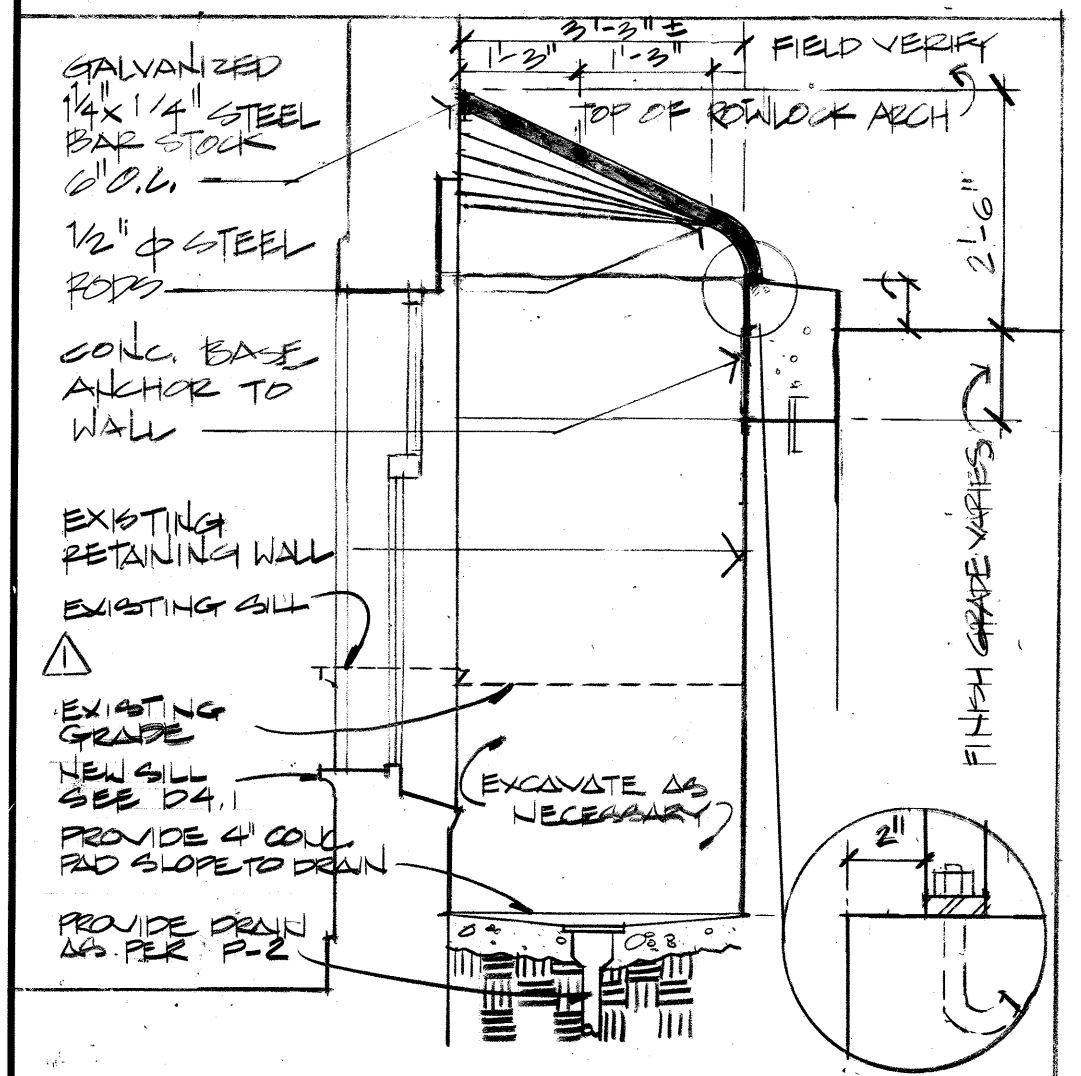

D SECTION @ WINDOW
D1.2 1/2" = 1'-0"

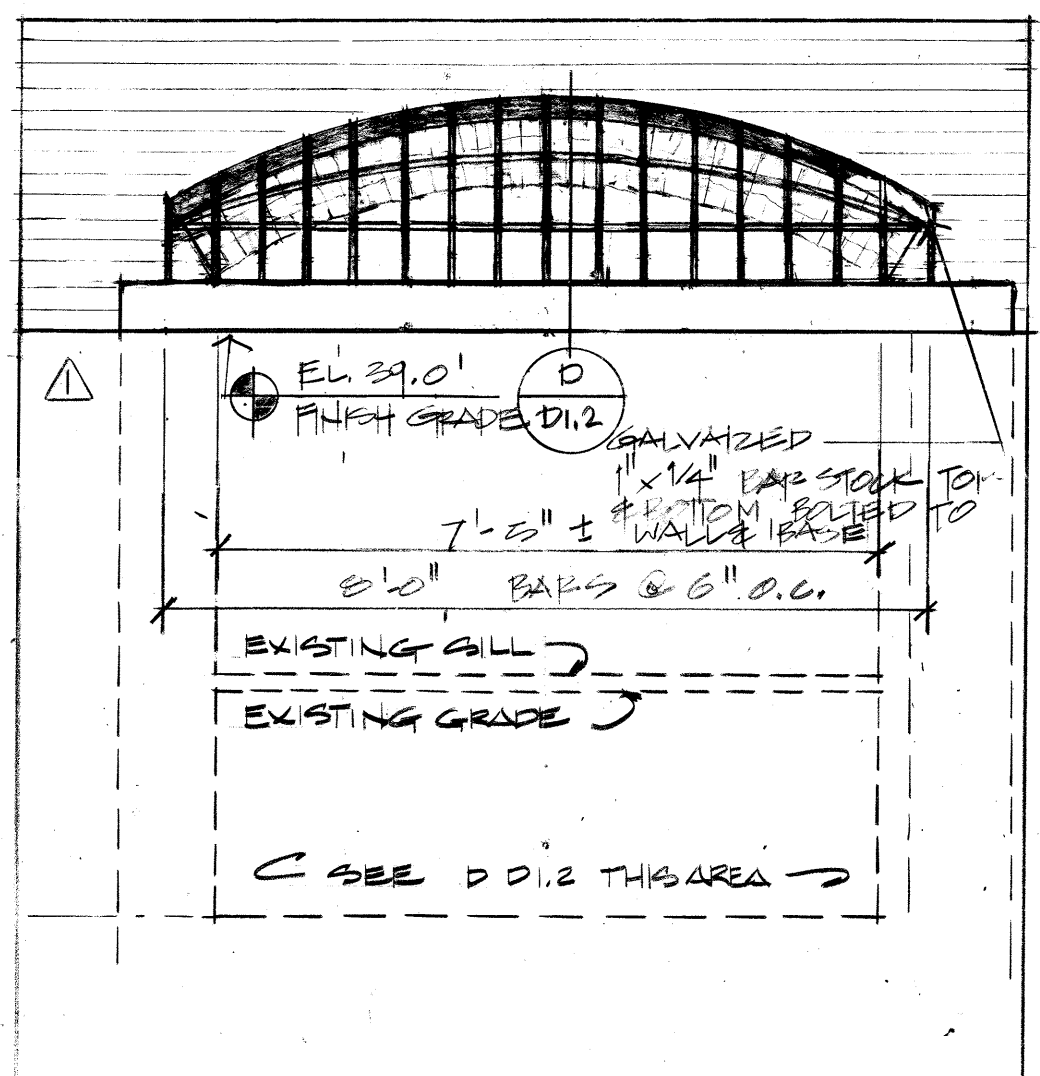

E WINDOW GRATE ELEVATION
D1.2 1/2" = 1'-0"

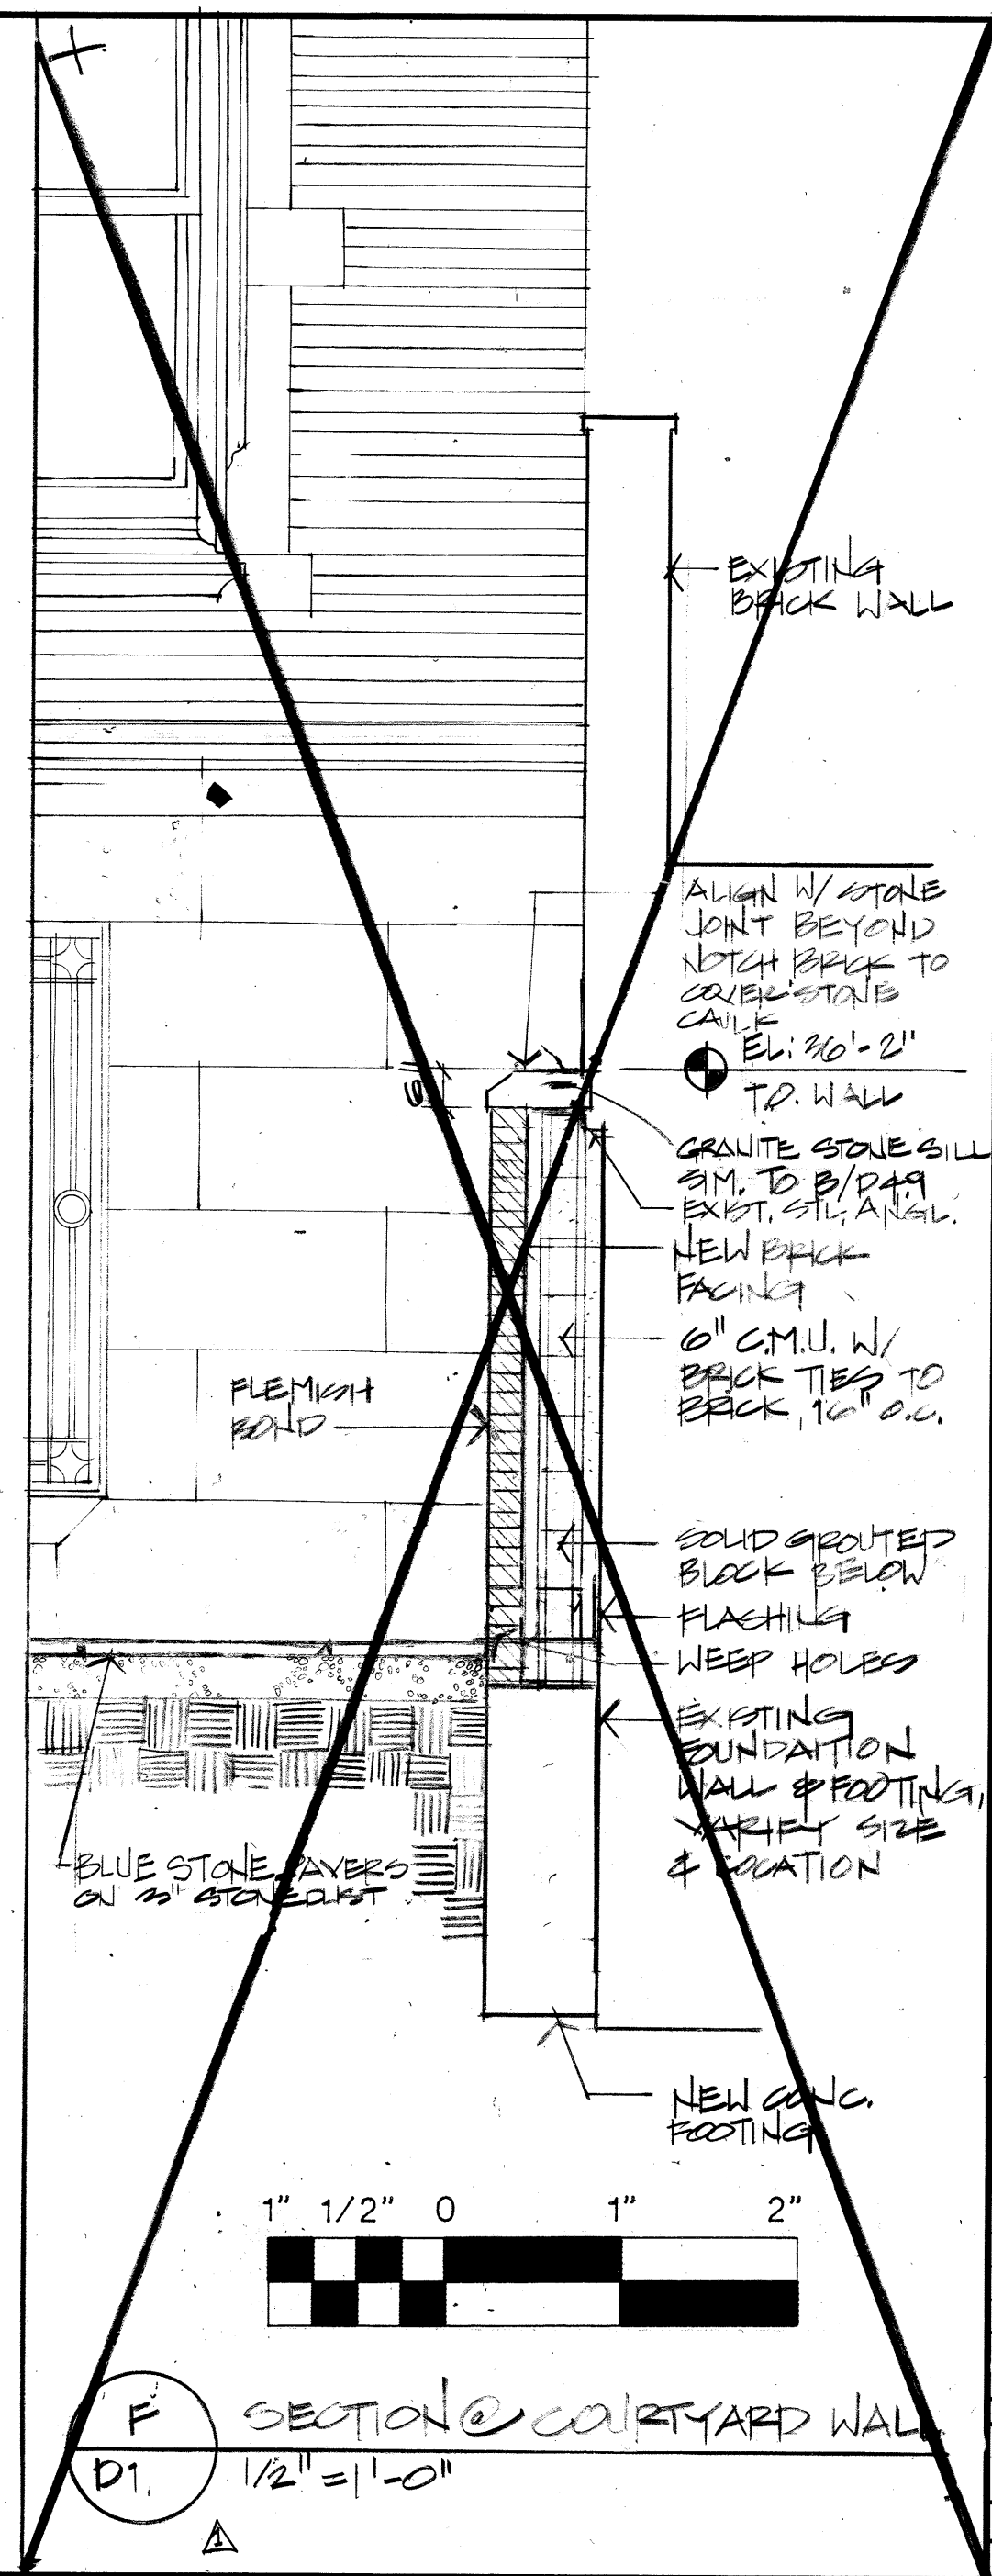

F SECTION @ COURTYARD WALL
D1.2 1/2" = 1'-0"

