






BENJAMIN THOMPSON & ASSOCIATES, INC.
ARCHITECTURE, PLANNING, AND URBANISM
ONE STORY STREET
CAMBRIDGE, MA 02138
(617) 876-4800 FAX (617) 876-0000

Cosentini Consulting Engineers
44 Brattle Street
Cambridge, Massachusetts 02138
(617) 876-3830 FAX (617) 876-6847

LeMessurier Consultants
1033 Massachusetts Avenue
Cambridge, Massachusetts 02138
(617) 866-1200 FAX (617) 861-7520

RENOVATIONS
TO
51 BRATTLE STREET

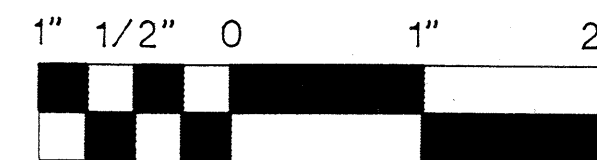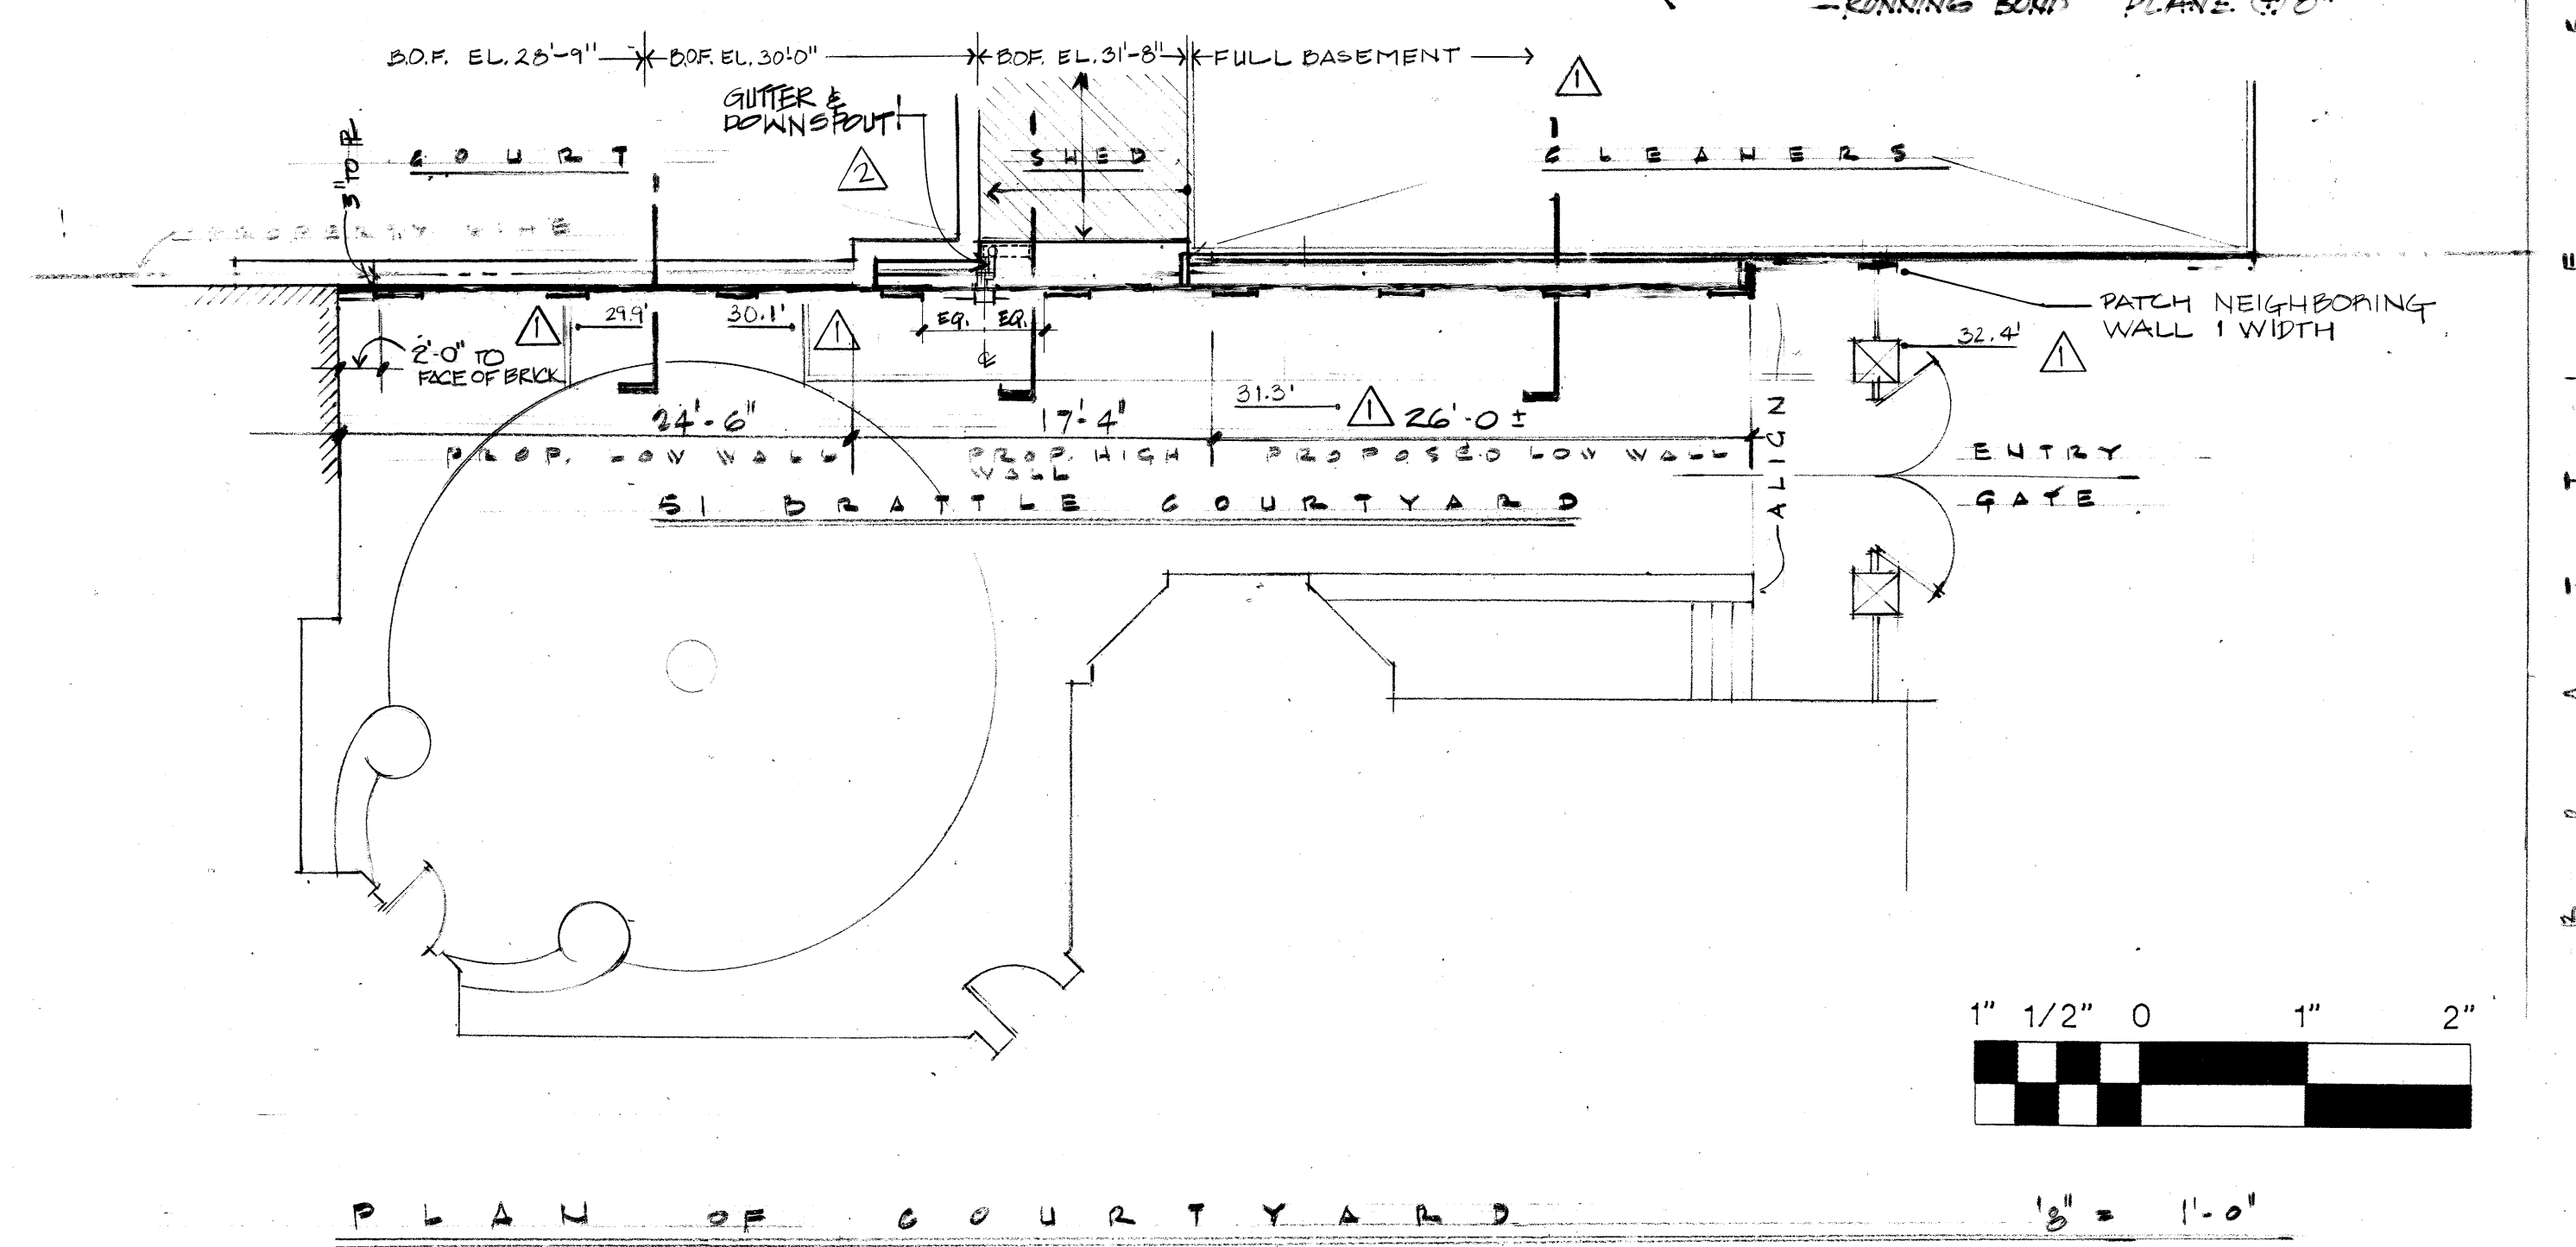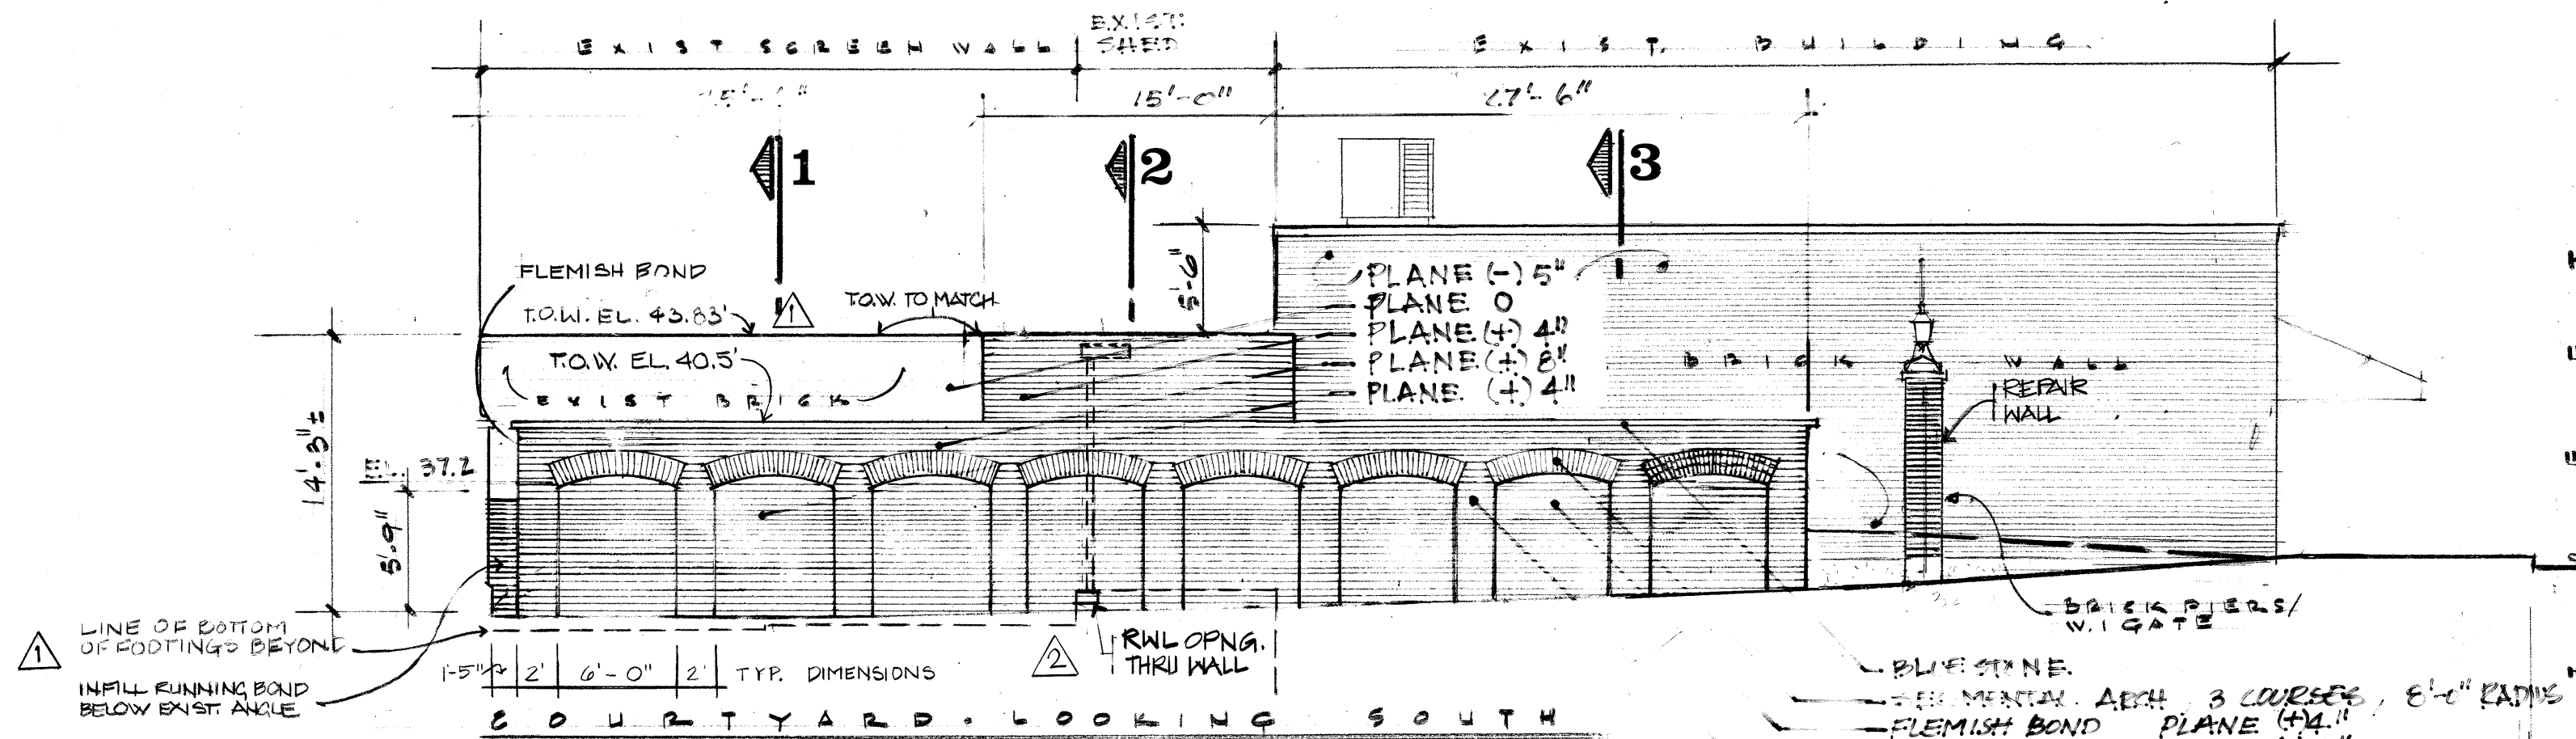

1/8" = 1'-0"

#220-79

RECORD SET 15 FEB. 91

20 MAR. 91 RHL REVISION
4 JAN. 91 CONST. REVISION

REVISION	DATE	DESCRIPTION
20 MAR. 91	RHL	REVISION
4 JAN. 91	CONST.	REVISION

COURTYARD
WALL TREATMENT

D1.5

1220-80