




BENJAMIN THOMPSON & ASSOCIATES, INC.
ARCHITECTURE, PLANNING, AND URBANISM
ONE STORY STREET
CAMBRIDGE, MA 02138
(617) 878-4800 FAX (617) 861-0811, 868-6626


Cosentini Consulting Engineers
44 Brattle Street
Cambridge, Massachusetts 02138
(617) 878-3830 FAX (617) 878-6647

LeMessurier Consultants
1033 Massachusetts Avenue
Cambridge, Massachusetts 02138
(617) 868-1200 FAX (617) 861-7820

RENOVATIONS TO 51 BRATTLE STREET

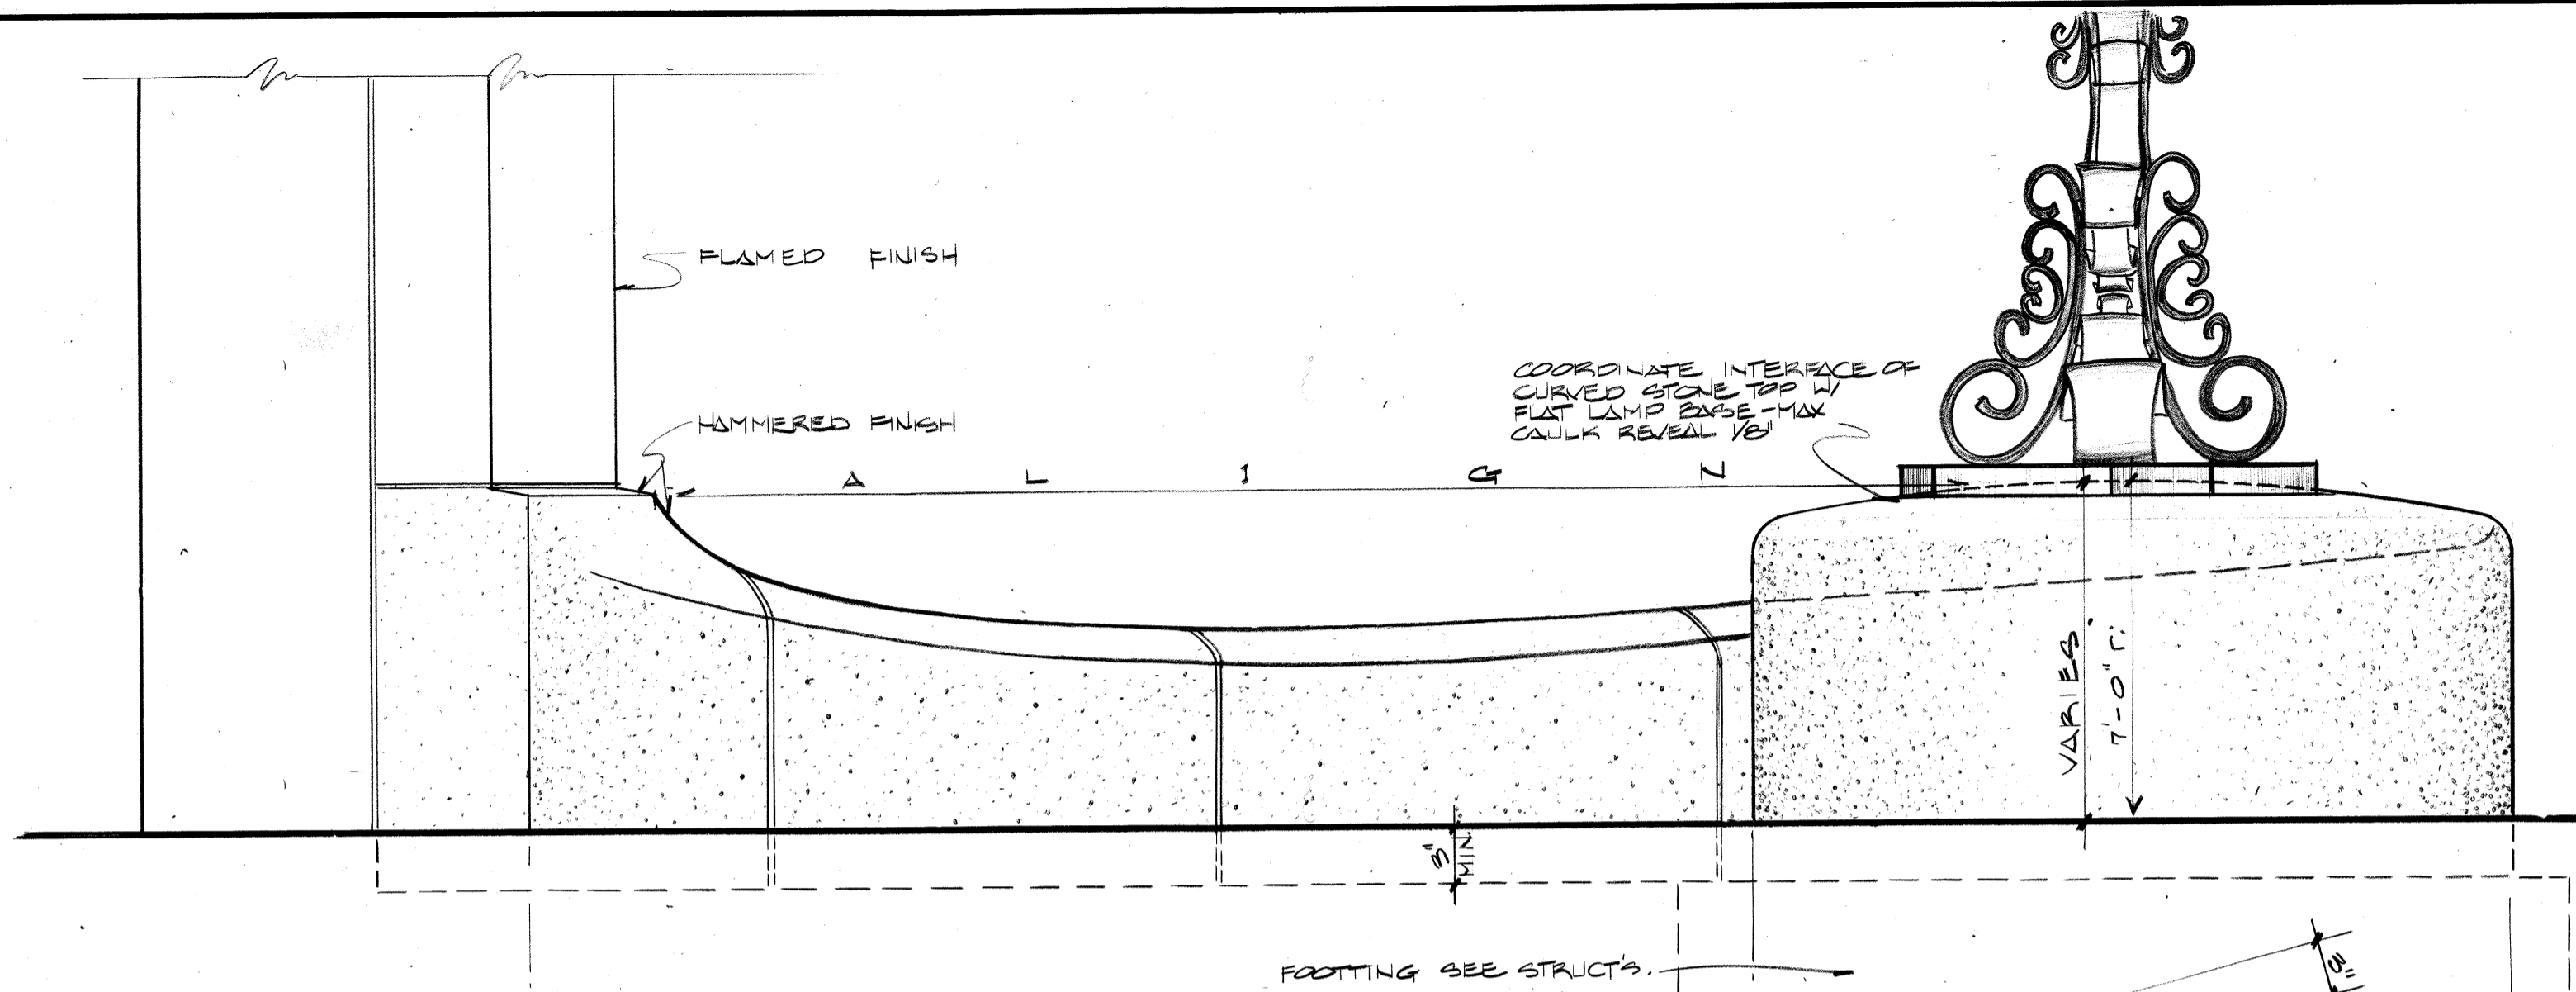

A GRANITE SITE HALF-WALL ELEVATIONS
D4.9 1/2" = 1'-0"

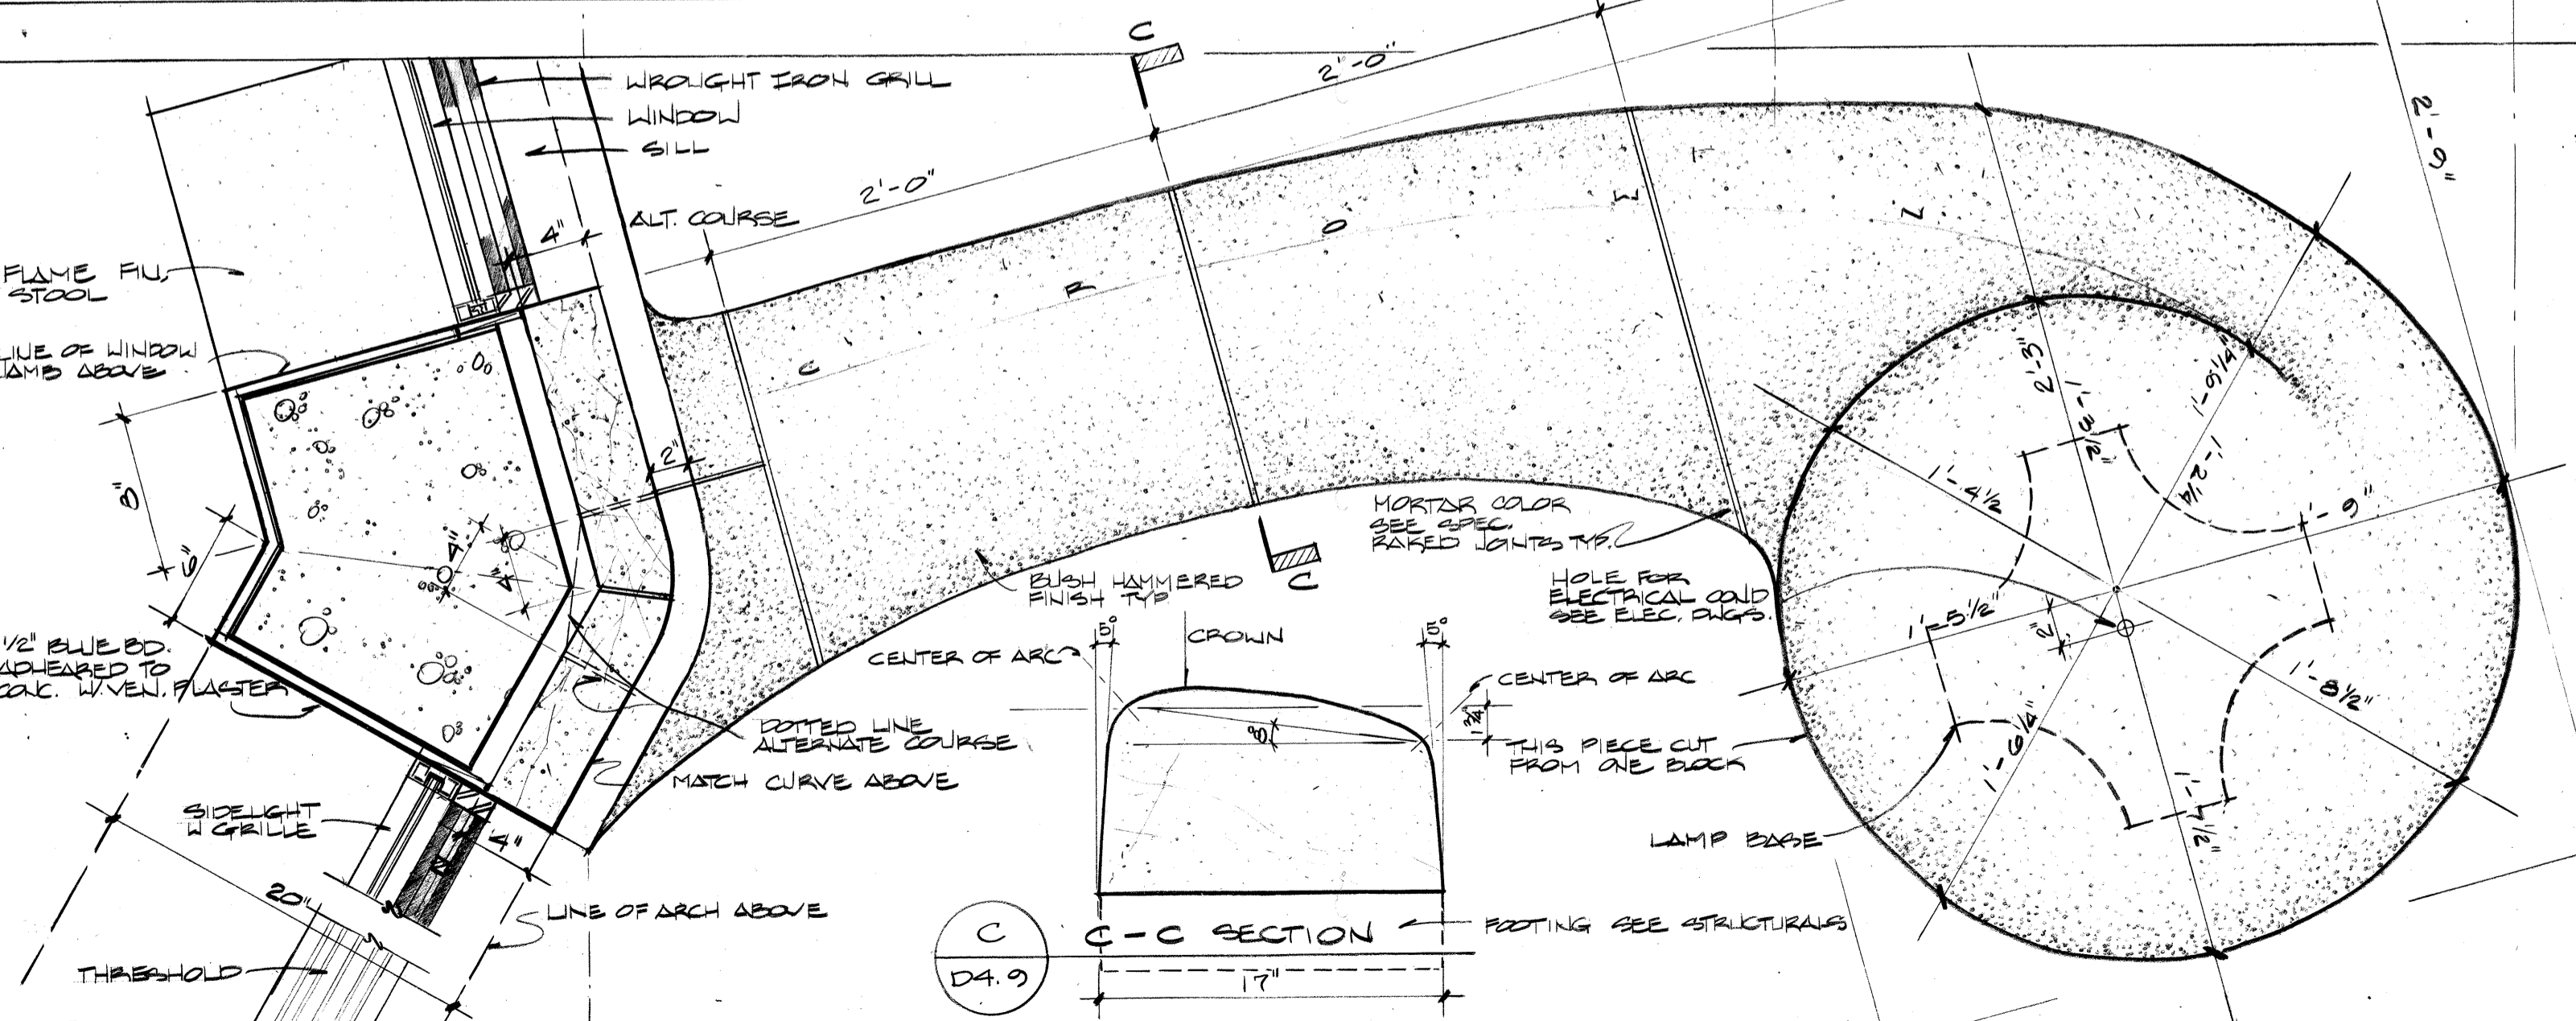

B GRANITE SITE HALF-WALL PLAN
D4.8 1/2" = 1'-0"

C C-C SECTION
D4.9 FOOTING SEE STRUCTURALS

#220-95

1/2" 0 1" 2



RECORD SET 15 FEB. 91

| REVISION | DATE | DESCRIPTION |
|----------|------|-------------|
| | | |
| | | |
| | | |
| | | |

GRANITE DETAILS
SITE HALF WALLS

| | | | |
|-----------------|---------------|----------|--|
| DATE 1/25/90 | CHECKED CE | APPROVED | |
| | | | |

JOB NO. 8912.00

D4.8