

BENJAMIN THOMPSON & ASSOCIATES, INC. ARCHITECTURE, PLANNING, AND URBANISM ONE STORY STREET CAMBRIDGE, MA 02188 (617) 876-4800 FAX (617) 861-9283, 866-9025

Cosentini Consulting Engineers 100 State Street Cambridge, Massachusetts 02138 (617) 876-3830 FAX (617) 876-8647

LeMessurier Consultants 1033 Massachusetts Avenue Cambridge, Massachusetts 02138 (617) 868-1200 FAX (617) 661-7520

RENOVATIONS TO 51 BRATTLE STREET

KEY:

- 2 HR. WALL
- NEW MASONRY INFILL


RECORD SET 15 FEB. 91

ADJ. SHELVING AND Misc. PREVISIONS
FIELD INSTRUCTION N° 3
FIELD INSTRUCTION N° 2
FIELD INSTRUCTION N° 1
DESCRIPTION

SEVENTH LEVEL PLAN	
CHECKED	APPROVED
DATE	JOB NO.
17 AUG 90	8912.00
SCALE	
1/4" = 1'-0"	
DRAWN	MWR

A2.7

220-136

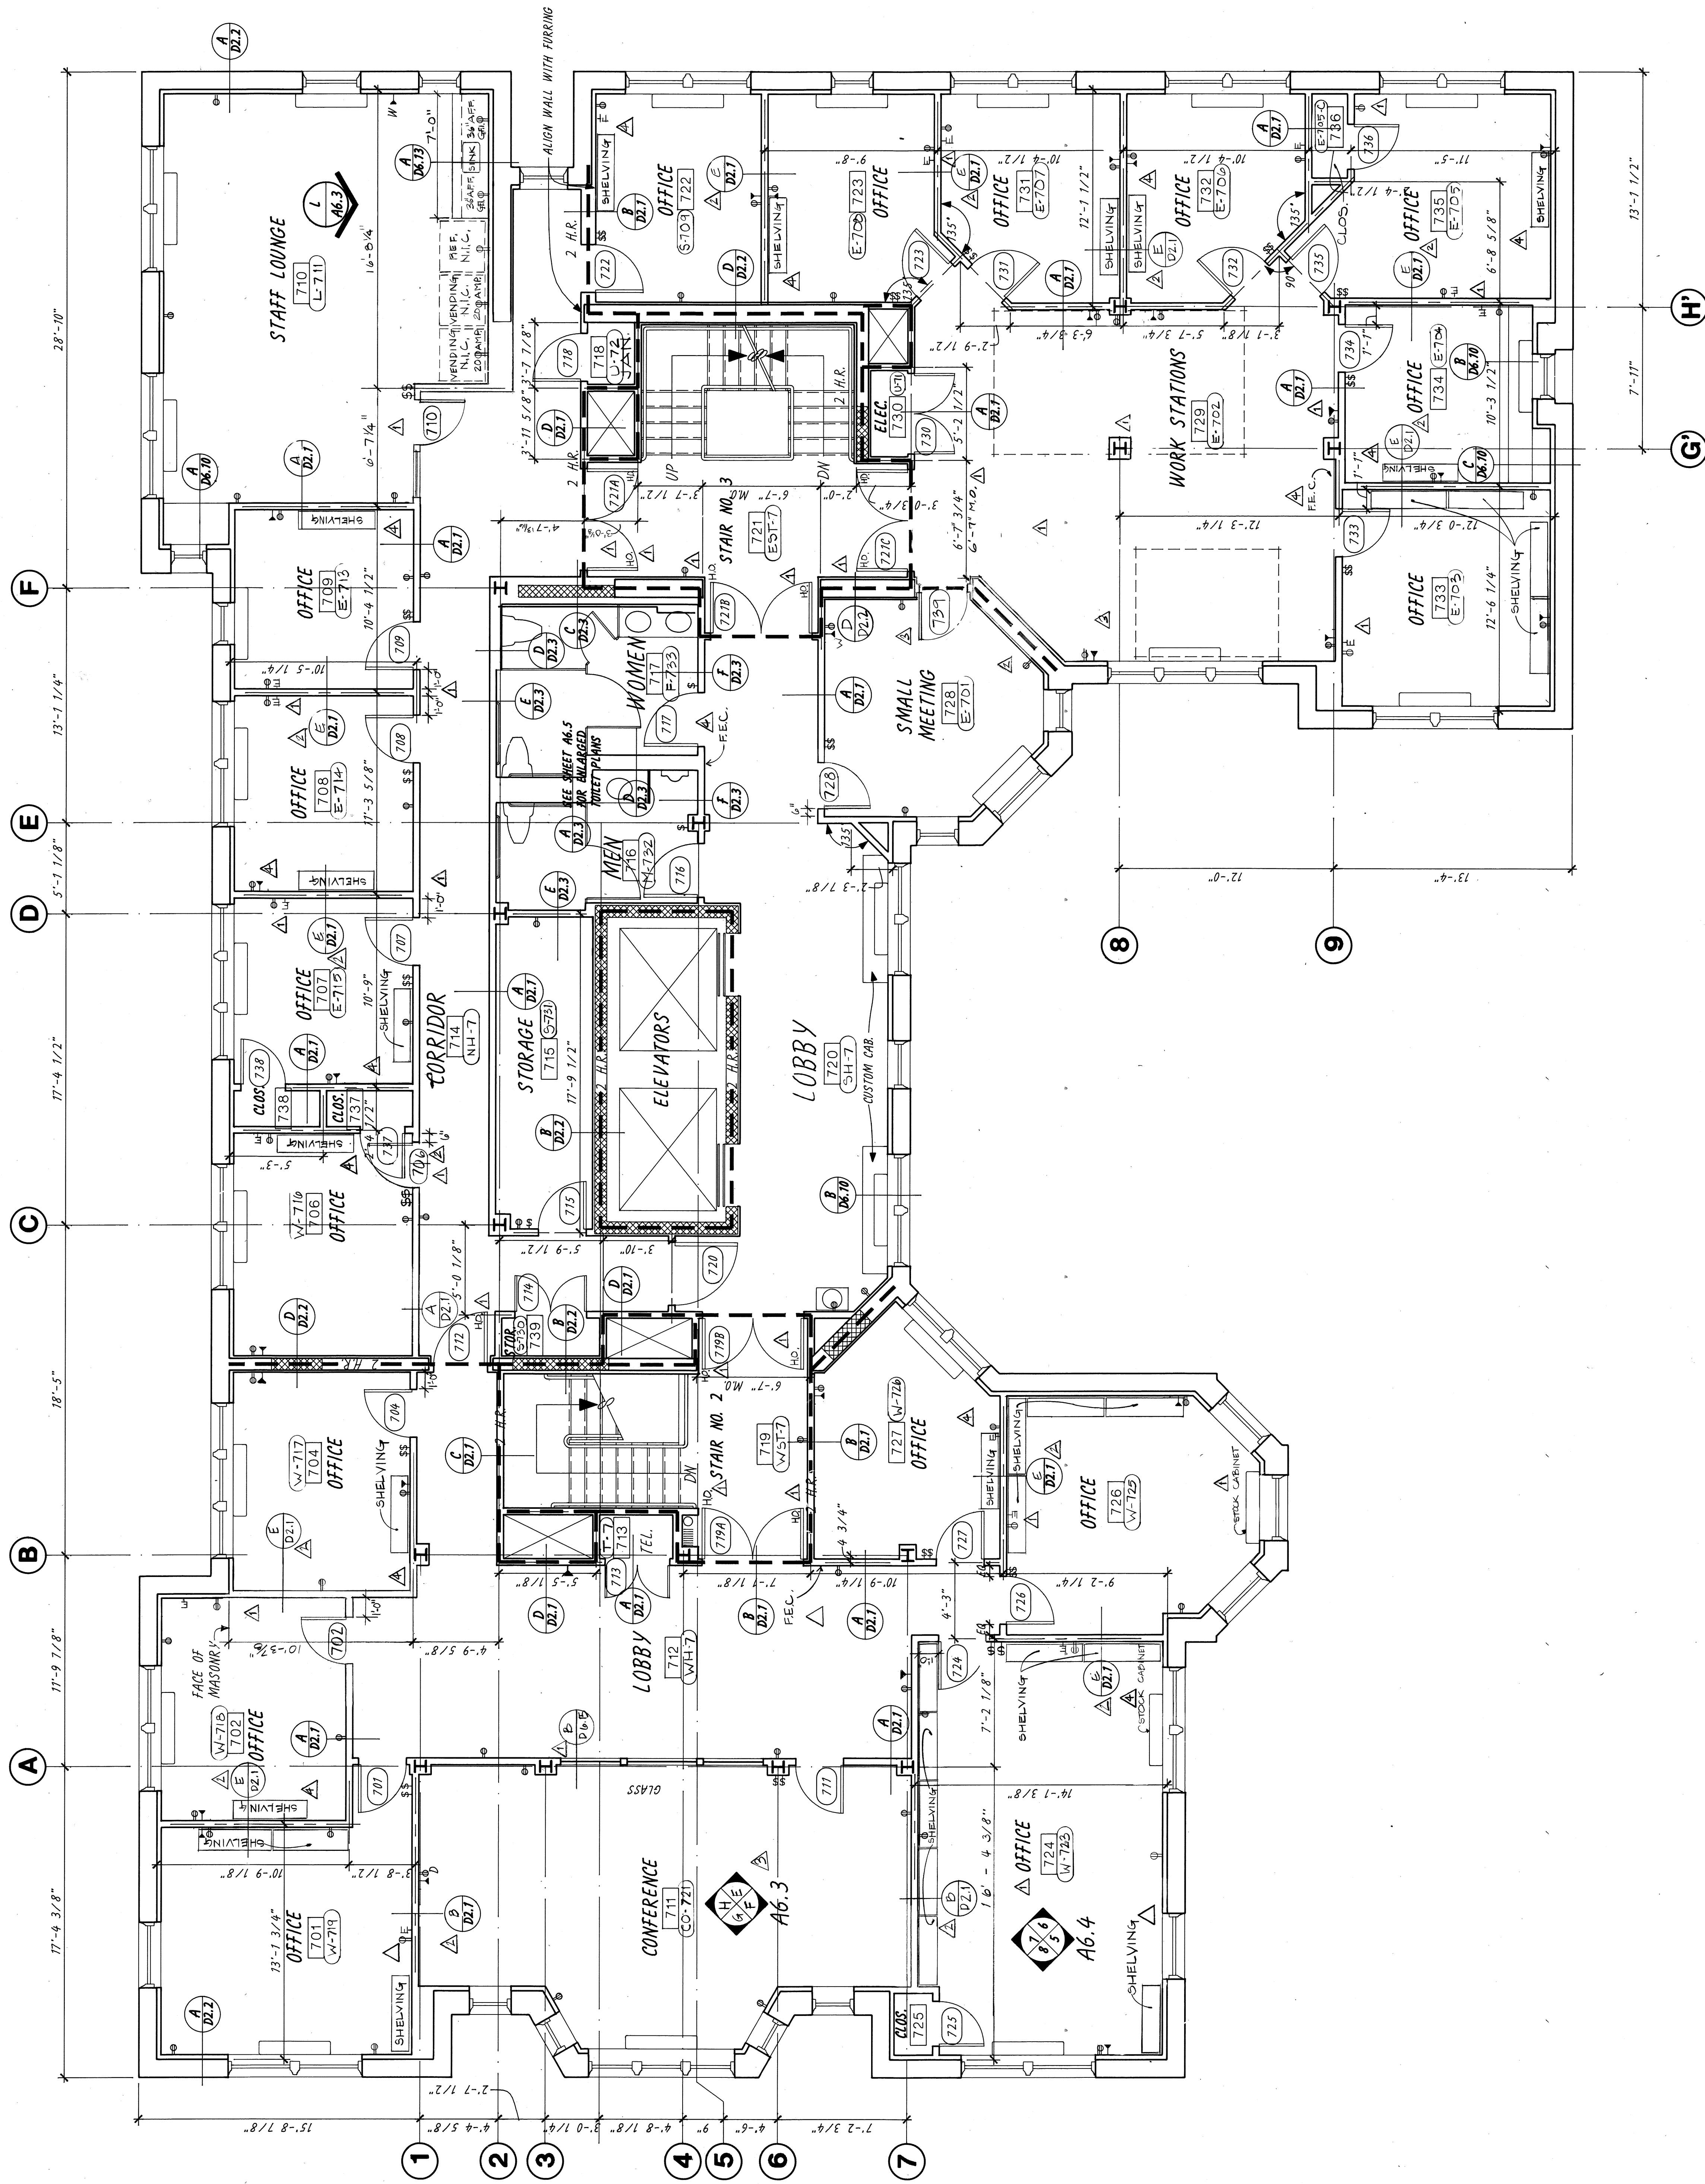

SEVENTH LEVEL

