
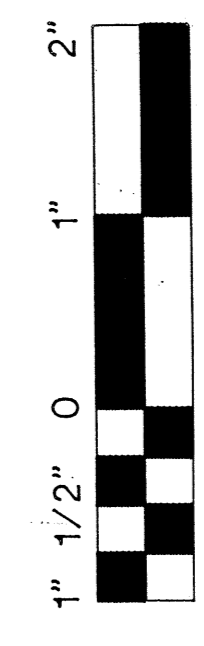
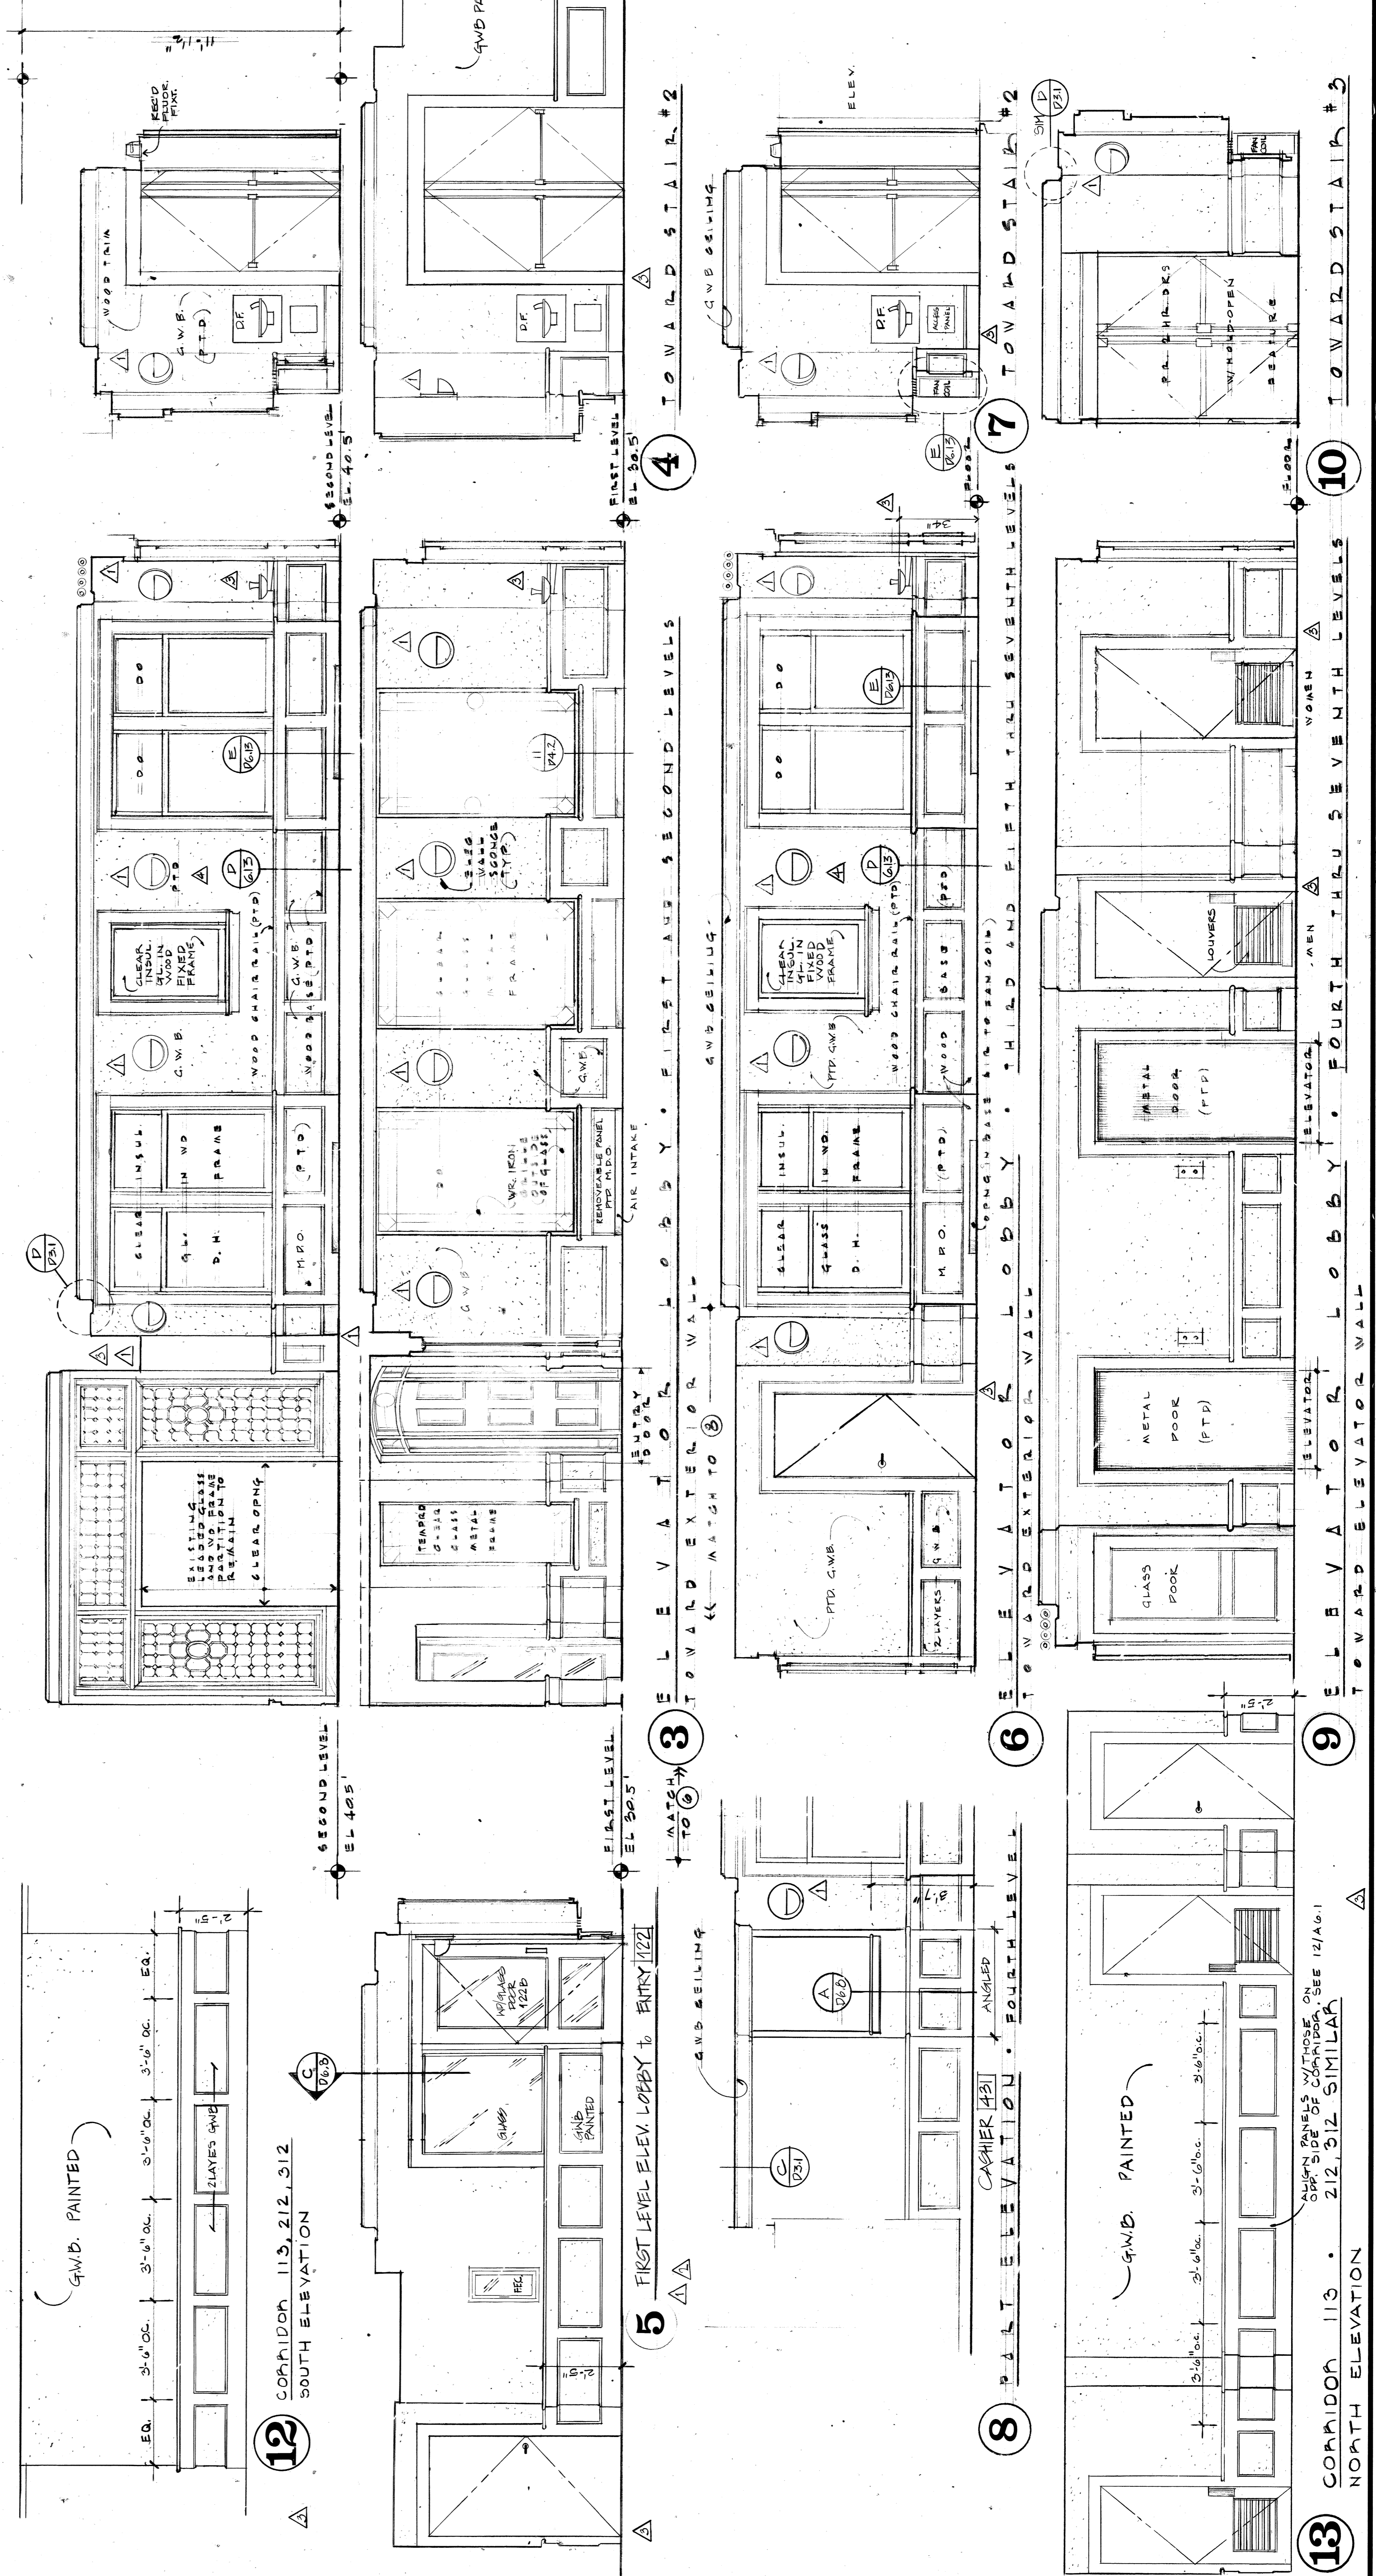


RENOVATIONS TO 51 BRATTLE STREET

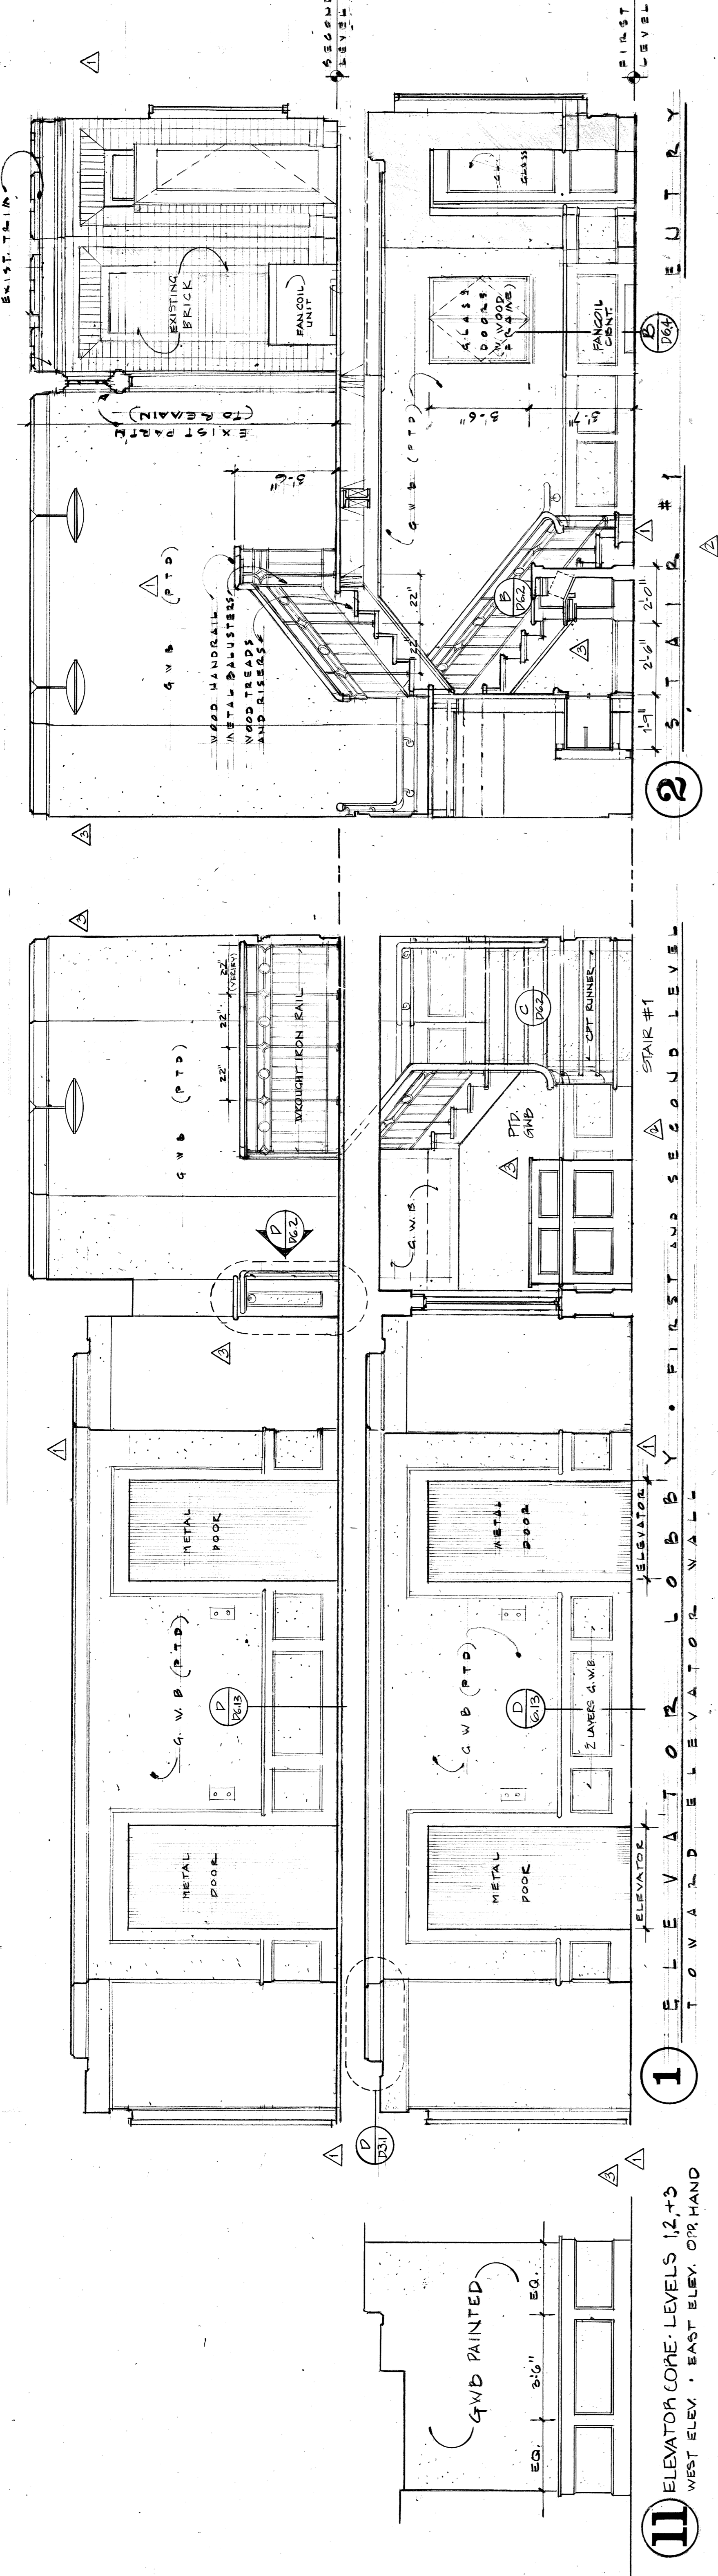

REVISION	DATE	DESCRIPTION
1		GENERAL CORRIDOR'S ELEVATIONS, MISC. REVISIONS
2		DOORWAY ELEVATION, SECURITY DOOR REMAINS
3		3RD FLOOR FIELD BULLETIN NO. 1

DRAWN	DATE	CHECKED	APPROVED
DETAILED	10/10		
SCALE	1" = 1'-0"		
JOB NO.	211.03		