


RENOVATIONS
TO
51 BRATTLE STREET

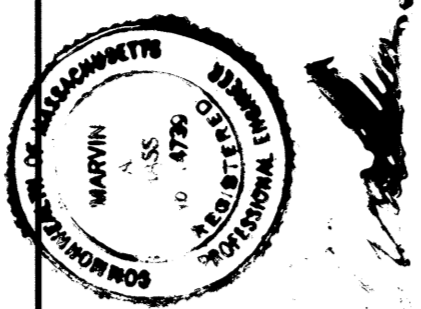

RECORD SET 15 SEPT. 1992

PART PLANS 2
& SECTIONS

REVISION	DATE	DESCRIPTION
△		
△		
△	10/24/90	D.C.E. REVISIONS
△	10/25/90	CLASSROOM OF THE FUTURE
△	10/25/90	COORDINATION REVISION
△	10/25/90	VALUE ENGINEERING

DRAWN	CHECKED	APPROVED
SCALE AS NOTED	DATE 8/11/92	JOB NO.

