


BENJAMIN THOMPSON & ASSOCIATES, INC. ARCHITECTURE, PLANNING, AND URBANISM ONE STORY STREET CAMBRIDGE, MA 02138 (617) 876-4900 FAX (617) 861-9813, 868-9023

Cosentini Consulting Engineers 44 Brattle Street Cambridge, Massachusetts 02138 (617) 876-3850 FAX (617) 876-6647

LeMessurier Consultants 1033 Massachusetts Avenue Cambridge, Massachusetts 02138 (617) 868-1200 FAX (617) 661-7520


RENOVATIONS TO 51 BRATTLE STREET

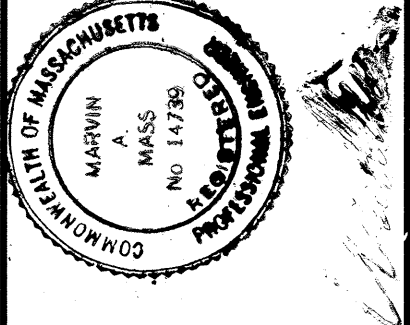

RECORD SET 15 SEPT. 1992

REVISION	DATE	DESCRIPTION
1	10/25/90	VALUE ENGINEERING
2	10/29/90	COORDINATION REVISION
3	11/29/90	CLASSROOM OF THE FUTURE
4	11/29/90	DCE REVISIONS
5	1/29/91	THELIMOSTAT LOCATIONS
6	1/10/91	ROOM NAME & NUMBER REVISIONS

SEVENTH LEVEL PLAN	
DRAWN	CHECKED
DATE	APPROVED
1/1/92	
SCALE 1/4" = 1'-0"	JOB NO. 8912.00
	M-15

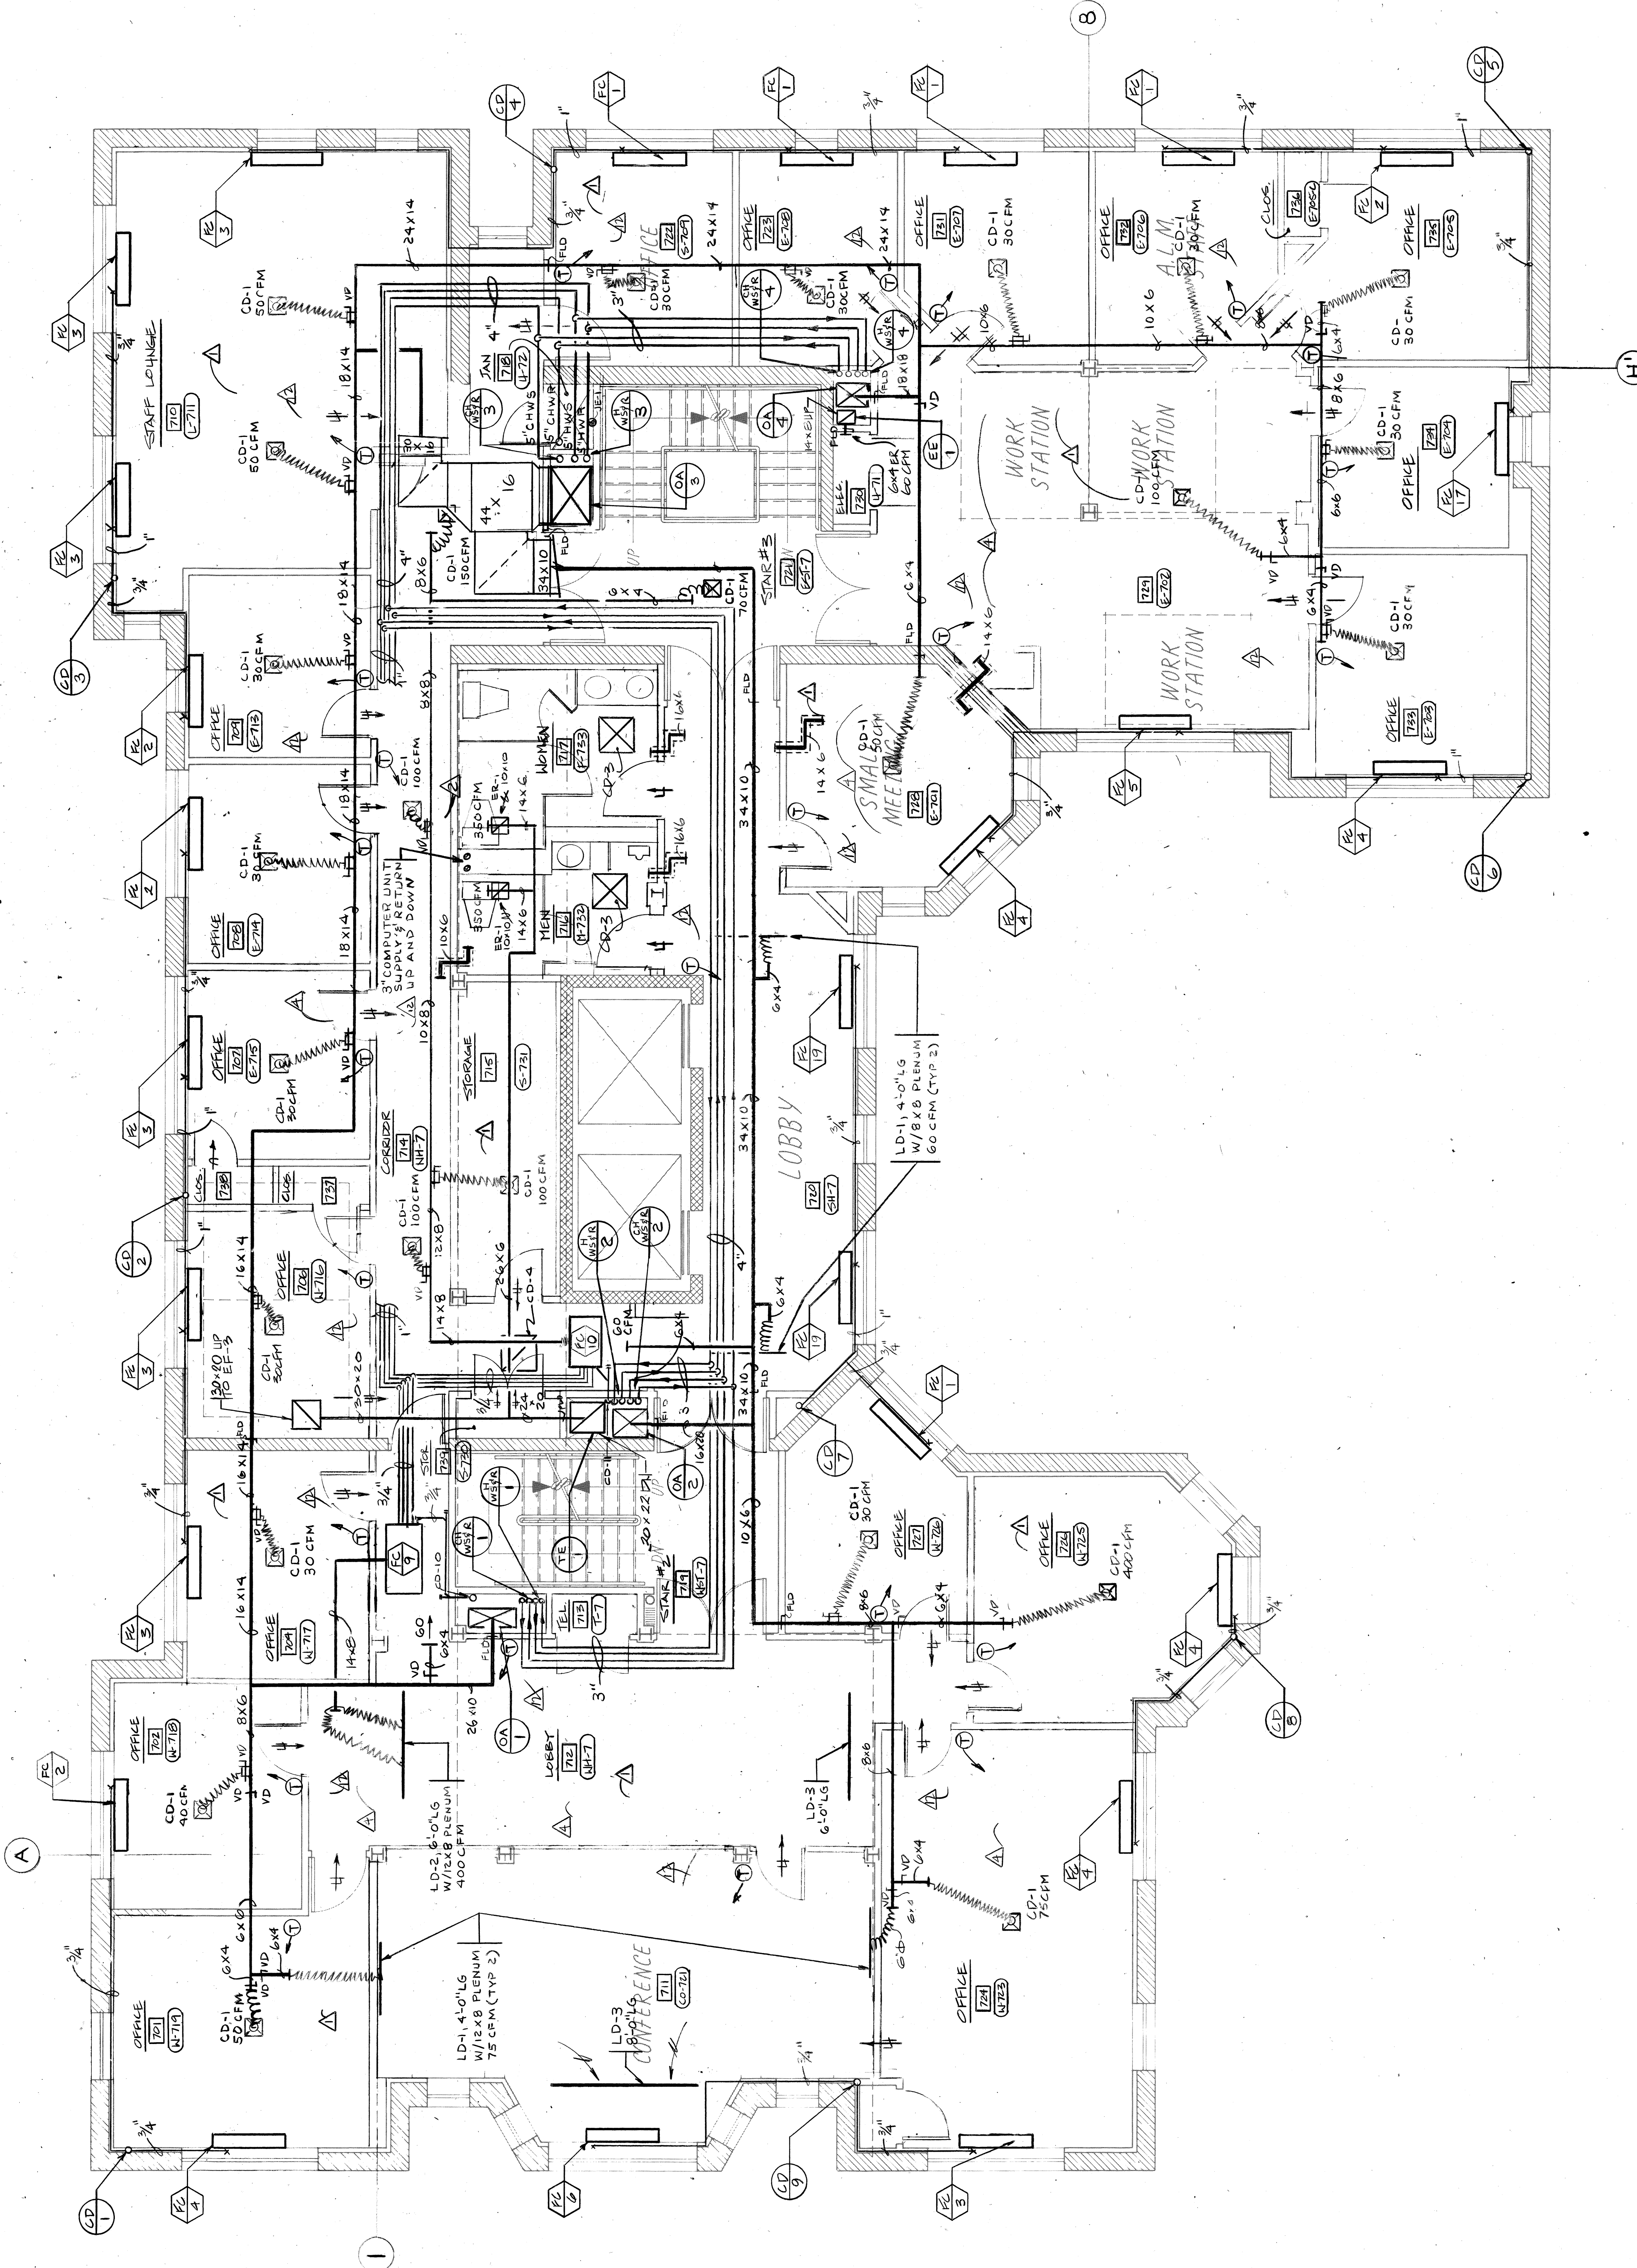

SEVENTH LEVEL

