

—HVAC—
—2ND FLOOR—

REV. NO.	DATE	DESCRIPTION	MADE BY
1	7/12/91	HVAC PIPING CHANGES	D.T.C.

MAURER AND SFORZA, INC.
 9 ERIE DR.
 NATTICK, MA. 01740
 508-655-6100
 MECHANICAL CONTRACTORS

DWG TITLE: 51 BRATTLE ST. HARVARD UNIVERSITY, CAMBRIDGE, MA.

DATE: 7/12/91
 SCALE: AS NOTED
 JOB NO: 12-17-90
 JOB NO FOR DRAWING: H-2

AGE NOTES:



- 2 DIFF. CD-1 HAS A 4" X 4" NECK, IS THIS ENOUGH FOR RED. CD-1?
- 3 LD-3 IS A LINEAR DIFF. BUT ON DWG 8-10 A SQUARE DIFF. IS SHOWN.

GENERAL NOTES:

- 1 FINISHED FLOOR - LOWER SIDE OF SLAB-10-10 8 1/4" 14-2" DIA. (TO UNLEVEL STRUCTURE)

DUCT ELEV. ABOVE FINISHED FLOOR

○ - ROOM NUMBER

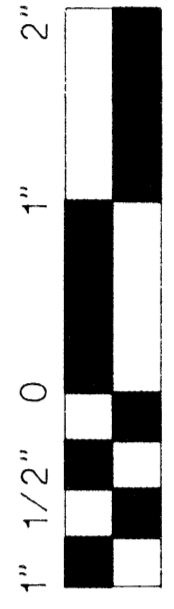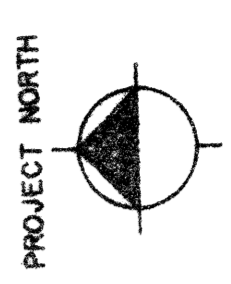


Maurer and Sforza, Inc.
 9 Erie Drive, Natick, MA 01740
 TEL: (508) 655-6100 FAX: (508) 655-9973

Record Drawings
 Date: 07-12-1991

DATE	REVISION	BY

PROJECT: 51 BRATTLE ST. HARVARD UNIVERSITY (RENOVATION)
 SUBJECT: Comfort Edge - Massachusetts
 DRAWN BY: D.A.B.
 SCALE: 1/4" = 1'-0"
 DATE: 12-17-90
 JOB NO FOR DRAWING: H-2

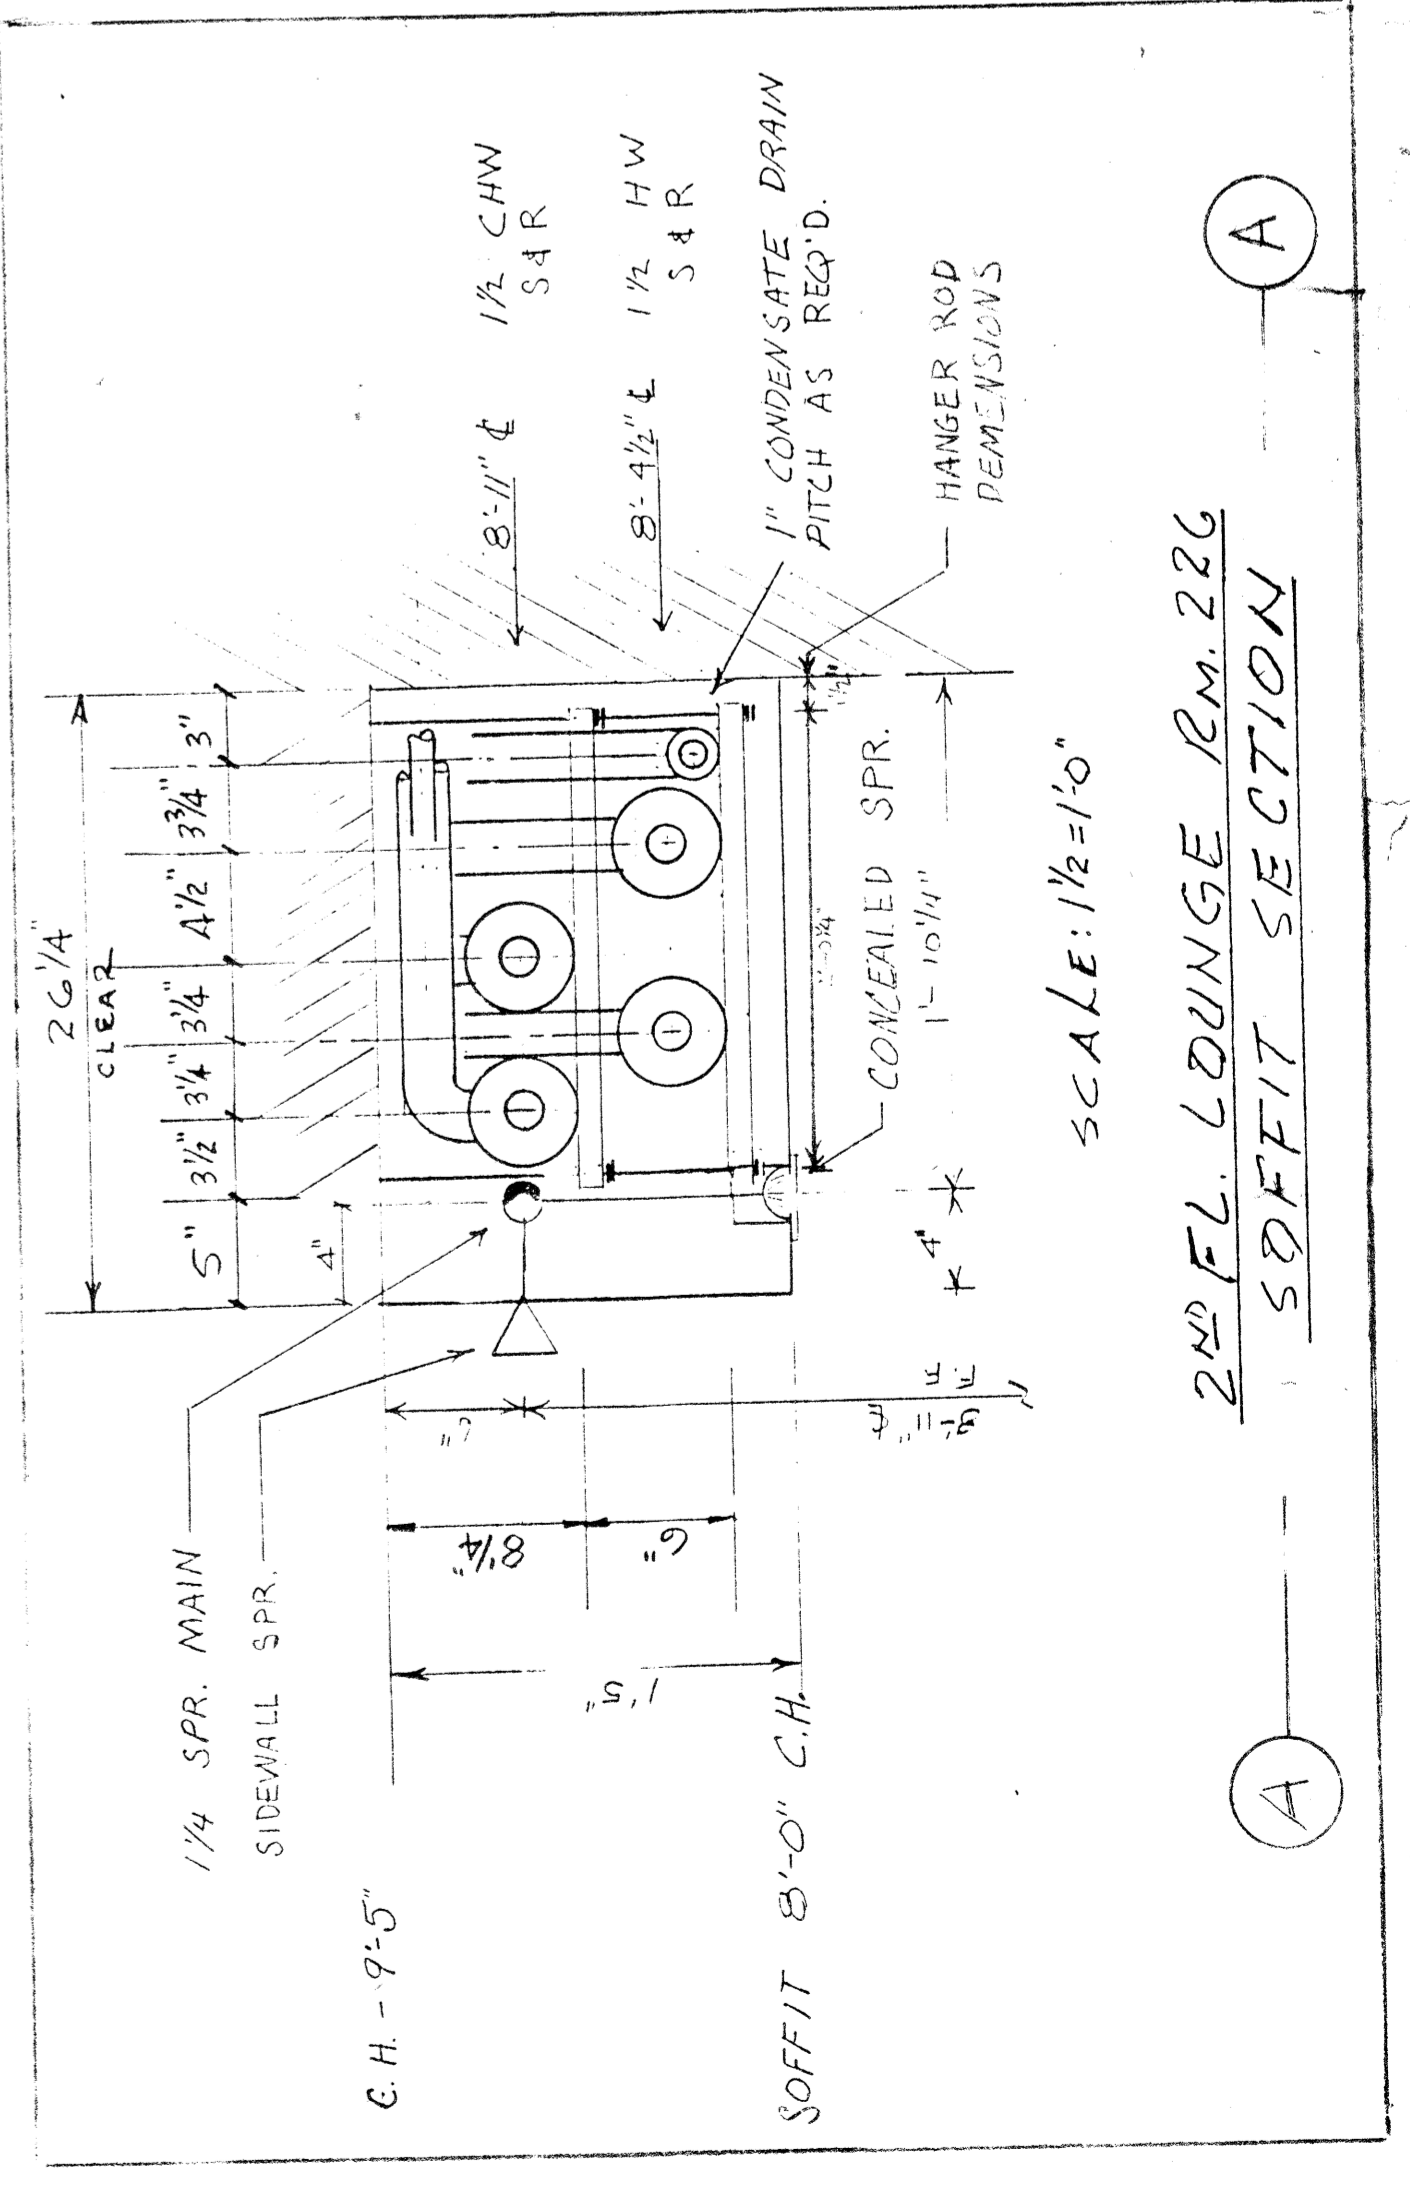

2ND FL LOUNGE RM. 226
 SOFFIT SECTION

SCALE: 1/4"=1'-0"