

HVAC

- 4TH FLOOR -

REV. NO.	DESCRIPTION	DATE	BY

MAURER AND SFORZA, INC.
 9 ERIE DR.
 NATICK, MA. 01770
 508-555-0100

MECHANICAL CONTRACTORS

DWG TITLE: 51 BRATTLE ST HARVARD UNIVERSITY CAMBRIDGE, MA.

DATE: 07/12/91

SCALE: 1/4" = 1'-0"

PROJECT: 51 BRATTLE ST HARVARD UNIVERSITY (RENOVATIONS)

SUBJECT: FOURTH FLOOR

DATE: 01-09-91 JOB NO: 108 DWG NO: H-4

AGE NOTES:

1. THESE LINE NUMBERS ARE NOT SHOWN ON THE CONTRACT DRS ARE THEY REQUIRED FOR THIS FINE MATED BULL.
2. THIS SPLIT IS NOT WISE ENOUGH FOR AN LENS AND SUE DUCT CAN THE SPLIT BE WIDENED?


GENERAL NOTES:

1. FINISHED FLOOR - UNDER SIDE OF SLUG-9-3 3/4" 14-2" DUE TO UNLEVEL STRUCTURE.



DUCT ELEV ABOVE FINISHED FLOOR

ROOM NUMBER

DATE	01-09-91	JOB NO	108	DWG NO	H-4
SCALE	1/4" = 1'-0"	SUBJECT	FOURTH FLOOR		
DRAWN BY	D.A.B.	PROJECT	51 BRATTLE ST HARVARD UNIVERSITY (RENOVATIONS)		
		SUBJECT	FOURTH FLOOR		
		PROJECT	51 BRATTLE ST HARVARD UNIVERSITY (RENOVATIONS)		

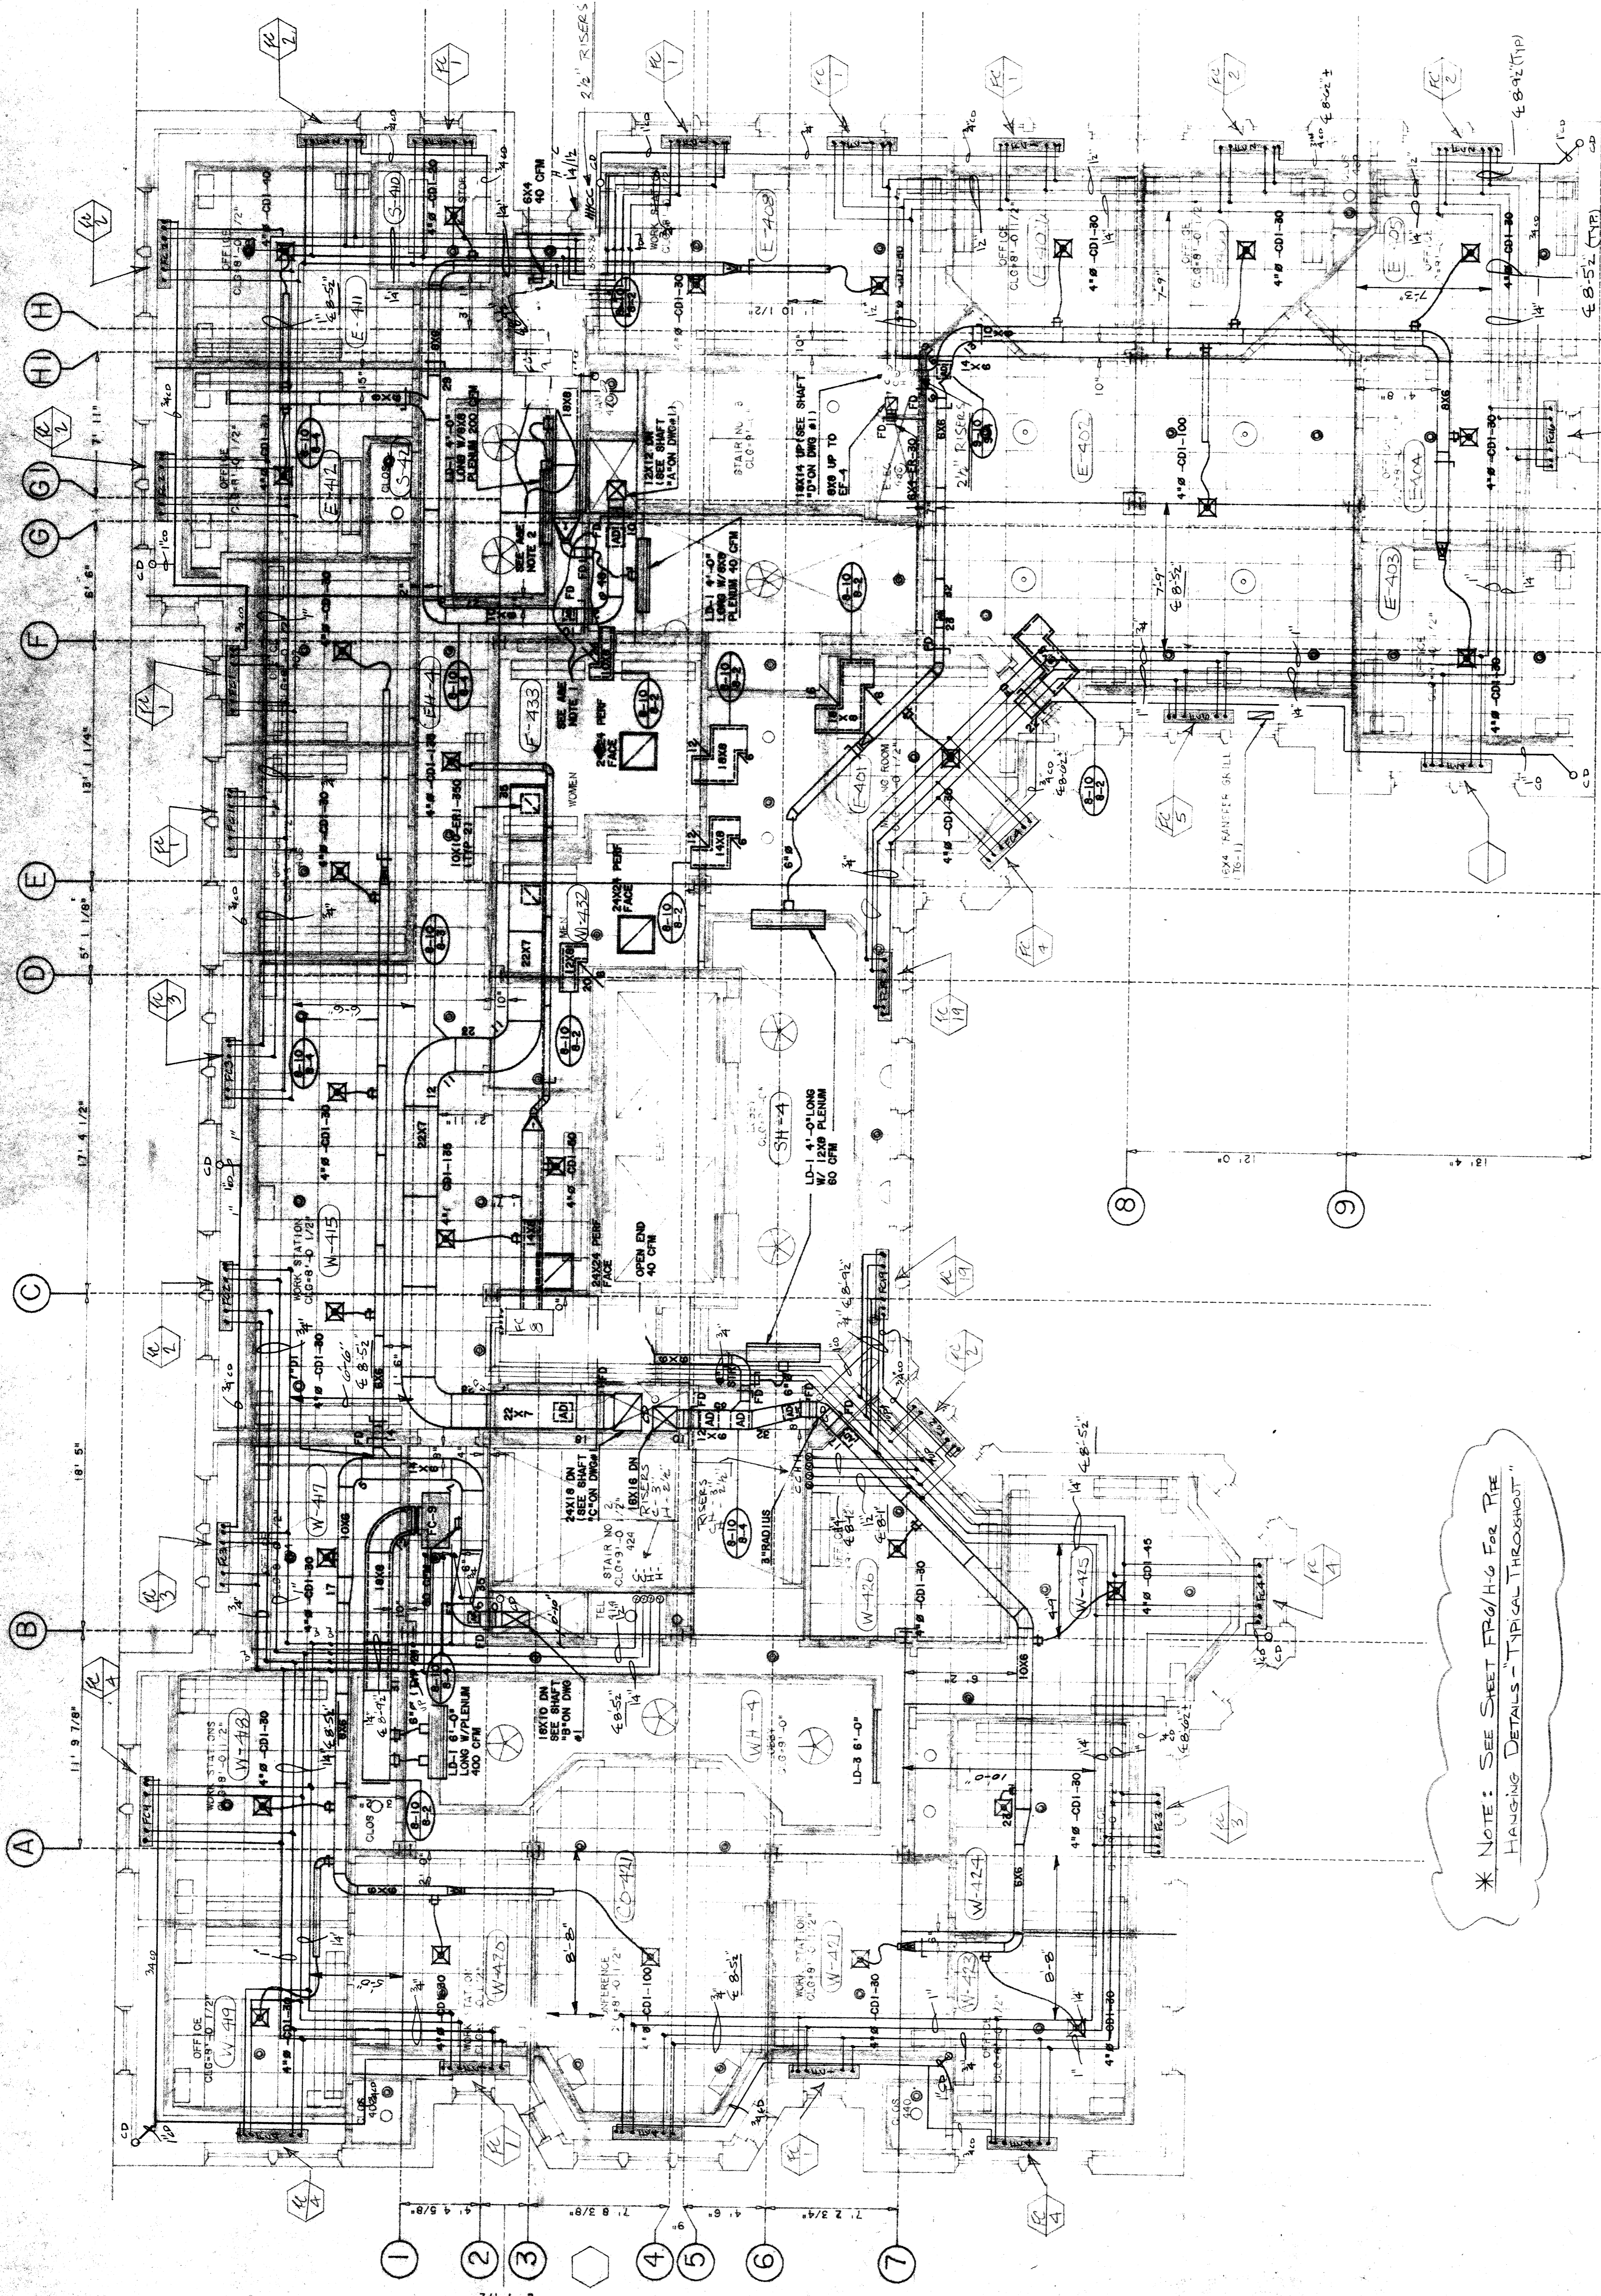

* NOTE: SEE SHEET FRG/HG FOR THE HANGING DETAILS - TYPICAL THROUGH *

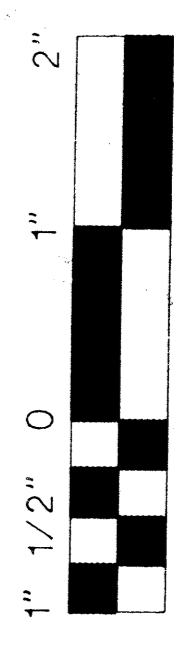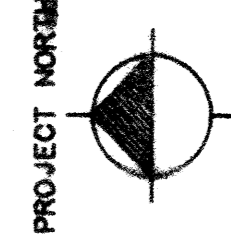

Maurer and Sforza, Inc.
 9 Erie Drive, Natick, MA 01770
 TEL: (508) 555-0100 FAX: (508) 555-0193

Record Drawings
 Date: 07-12-1991