
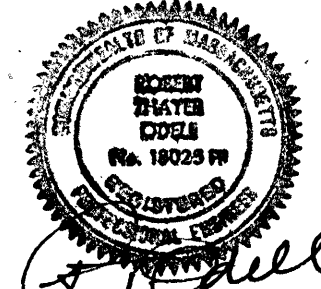




- ④ 1/16" CENTRAL "A" 1/2" ROYAL FLUSH CONCEALED W/ WHITE PLATE.
- ⑤ 1/16" CENTRAL "A" BRASS UPRIGHT (SEE PLAN FOR HIGH DEGREE HEADS)
- ⑩ 1/16" CENTRAL "H" 1/2" HORIZONTAL SIDEWALL CHROME W/ PLATE.
- ① 1/16" CENTRAL "H" 1/2" EXTENDED COVERAGE HORIZONTAL SIDEWALL CHROME W/ PLATE.

GENERAL NOTE:
 ALL 9'-0" CEILING HAVE BEEN LOWERED TO 8'-10 1/4" AS PER ARCH. 2-25-91.
 ALL SPRINKLER PIPING RUNNING AT 9'-2 1/2" FIN. FLOOR & UNLESS NOTED.

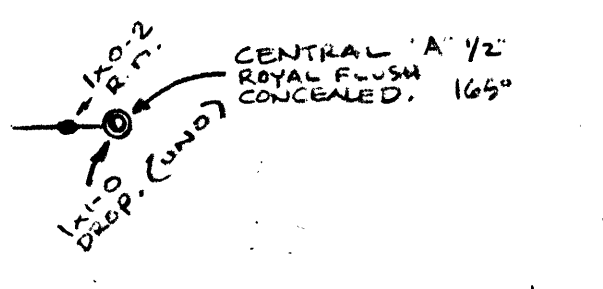


- FIRE PROTECTION -
- 2ND FLOOR -


1	7-29-91	CHANGED ROOM NUMBERS.	
REV. NO.	DATE	DESCRIPTION	MADE BY
MAURER AND SFORZA, INC. 9 ERIC DR. NATICK, MA. 01760 508-655-6100 MECHANICAL CONTRACTORS			
DWG. TITLE: 51 BRATTLE ST. HARVARD UNIVERSITY CAMBRIDGE, MA.			
DATE:	FEB 27 1991	DWG. NO.:	FR2
SCALE:	AS NOTED	MADE BY:	DM
JOB NO.:	645	CHECK BY:	
		APPROVED BY:	

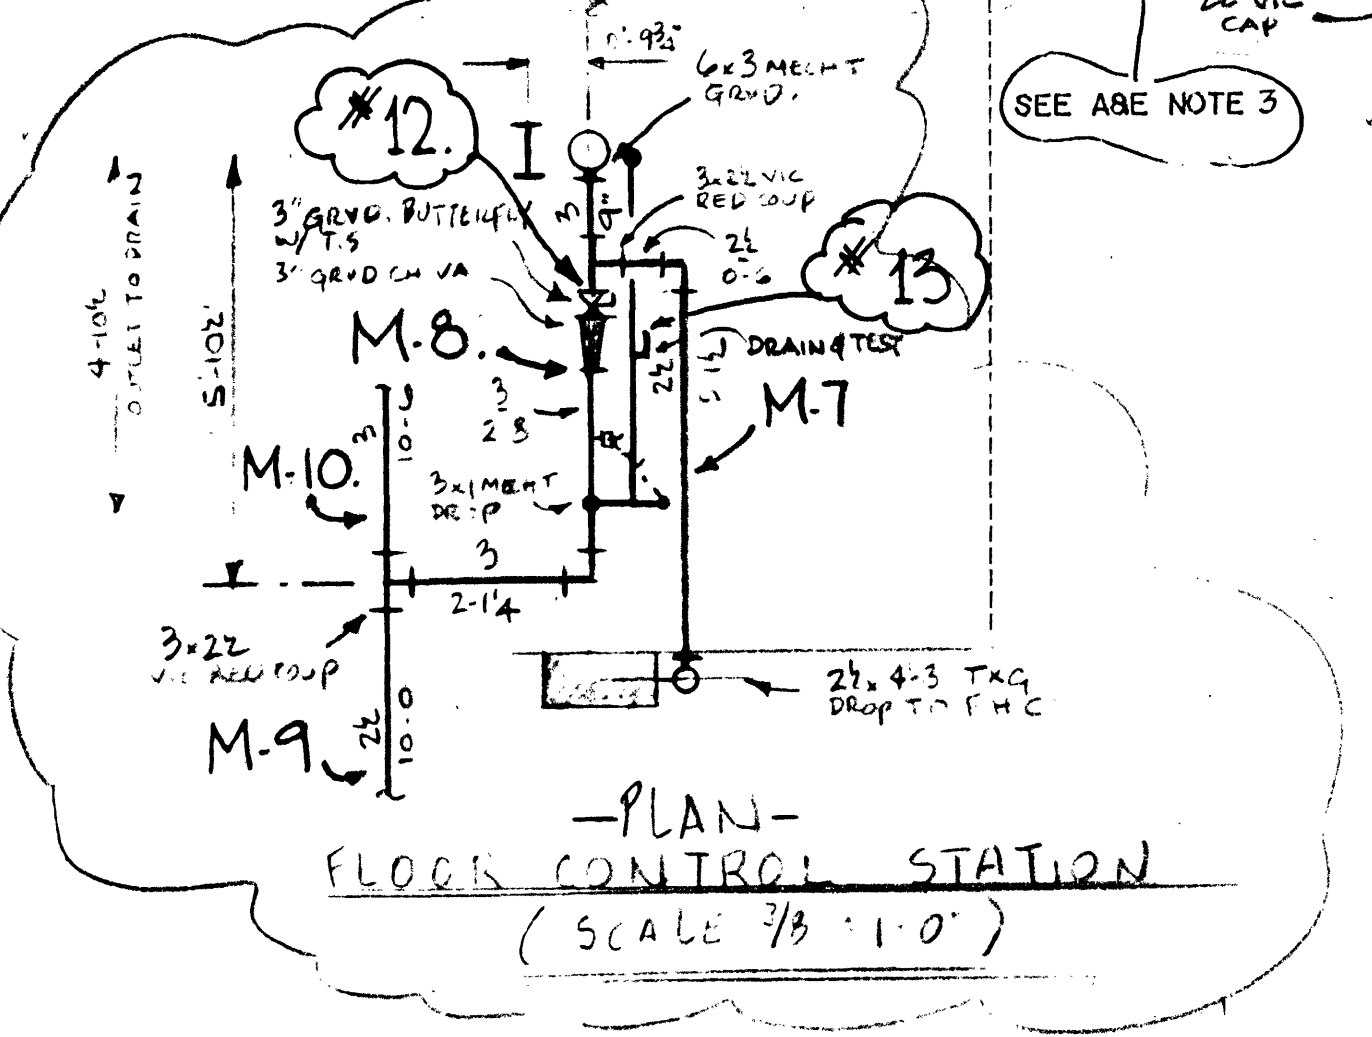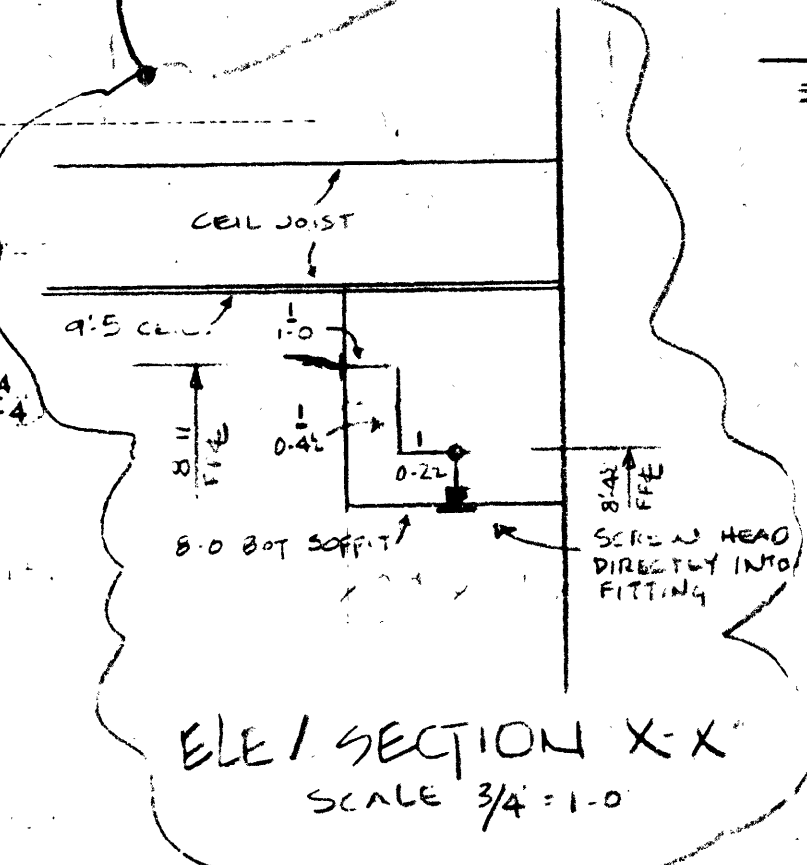

RECORD DRAWING
MAURER & SFORZA

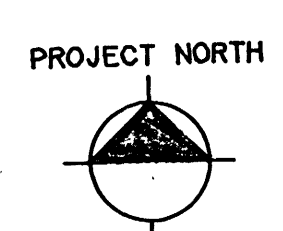

DATE: _____

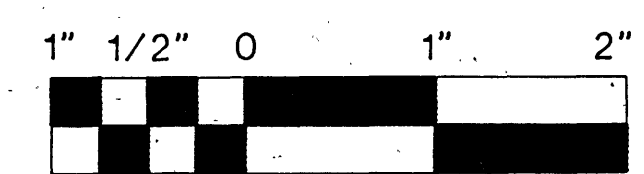

DATE	REVISION	BY

GENERAL NOTES:
 1 FINISHED FLOOR - UNDER SIDE OF SLAB-10'-10 3/4" (+-2" DUE TO UNLEVEL STRUCTURE)

200-249 ✓
 PROJECT
 51 BRATTLE ST
 HARVARD UNIVERSITY
 (RENOVATIONS)
 Cambridge, Massachusetts
 SUBJECT
 SECOND FLOOR