



7/0 RELIABLE 1/2" CONCRETE
 W/WHITE PLATE
 1/2" x 1/2" x 1/2" (SEE SPEC)

- FIRE PROTECTION -
- 4TH FLOOR -


1	7-29	CHANGED ROOM NUMBERS	
REV NO.	DATE	DESCRIPTION	MADE BY
MAURER AND SFORZA, INC. 9 ERIE DR. NATICK, MA. 01760 508-655-6100 MECHANICAL CONTRACTORS			
DWG TITLE: 51 BRATTLE ST HARVARD UNIVERSITY CAMBRIDGE, MA.			
DATE: FEB 5, 1991	DWG NO.:	MADE BY: BM	
SCALE: AS NOTED	FR 4	CHKD BY:	
JOB NO: 645		APPROV BY:	

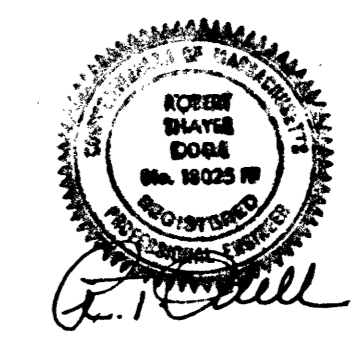

RECORD DRAWING
MAURER & SFORZA

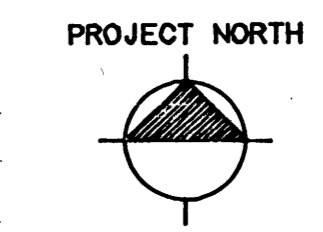

DATE: July 2, 1991

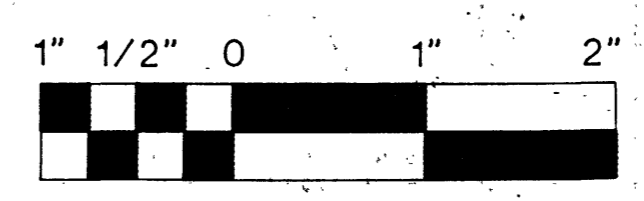

DATE	REVISION	BY

GENERAL NOTES:
 1 FINISHED FLOOR - UNDER SIDE OF SLAB-9'-8 3/4" (4'-2" DUE TO UNLEVEL STRUCTURE)

#200-251
 PROJECT
 51 BRATTLE ST
 HARVARD UNIVERSITY
 (RENOVATIONS)
 Cambridge, Massachusetts
 SUBJECT
 FOURTH FLOOR