


**BENJAMIN THOMPSON & ASSOCIATES, INC.**  
 ARCHITECTURE, PLANNING, AND URBANISM  
 ONE STONEY STREET  
 CAMBRIDGE, MASSACHUSETTS 02138  
 (617) 876-3830 FAX (617) 876-6847

**RENOVATIONS TO 51 BRATTLE STREET**

**Cosentini Consulting Engineers**  
 44 Brattle Street  
 Cambridge, Massachusetts 02138  
 (617) 876-3830 FAX (617) 876-6847

**LeMessurier Consultants**  
 1033 Massachusetts Avenue  
 Cambridge, Massachusetts 02138  
 (617) 868-1200 FAX (617) 861-7520

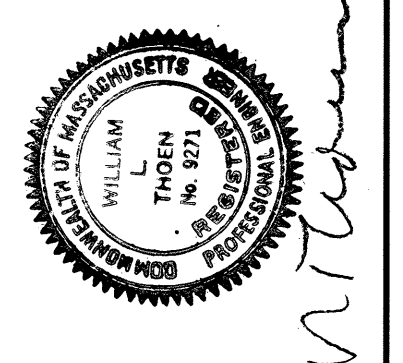

*W. Thompson*















**RECORD SET 15 SEPT. 1992**

REVISION	DATE	DESCRIPTION
7-16-90		ISSUED FOR CONSTRUCTION

**STEEL SCHEDULES AND DETAILS**

DRAWN	CHECKED	APPROVED
EHS	SKH	JAC
SCALE	DATE	JOB NO.
1 1/2" = 1'-0"	8-20-90	

**S-4**

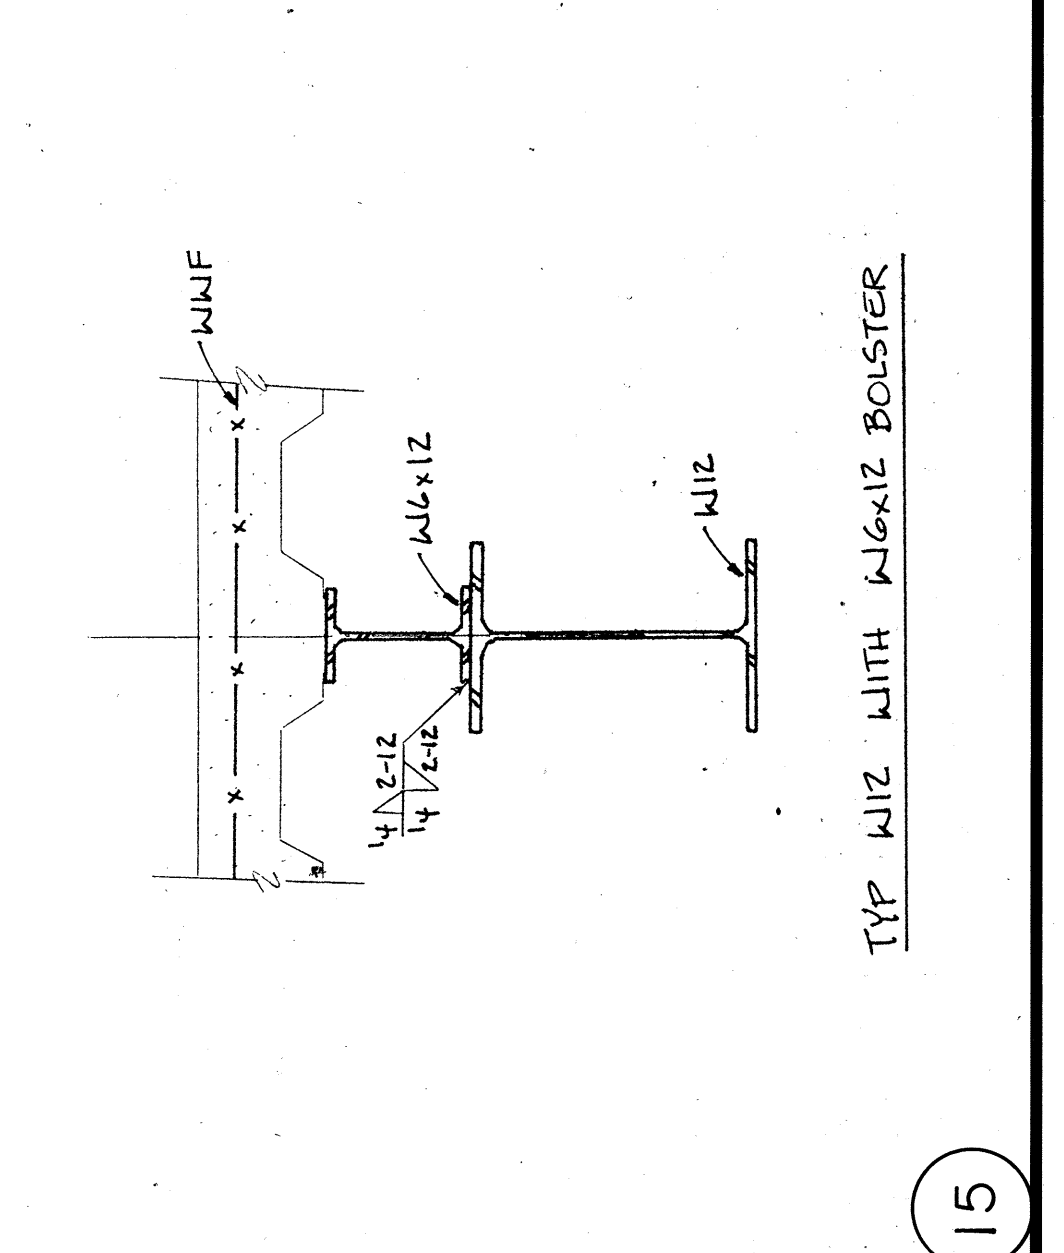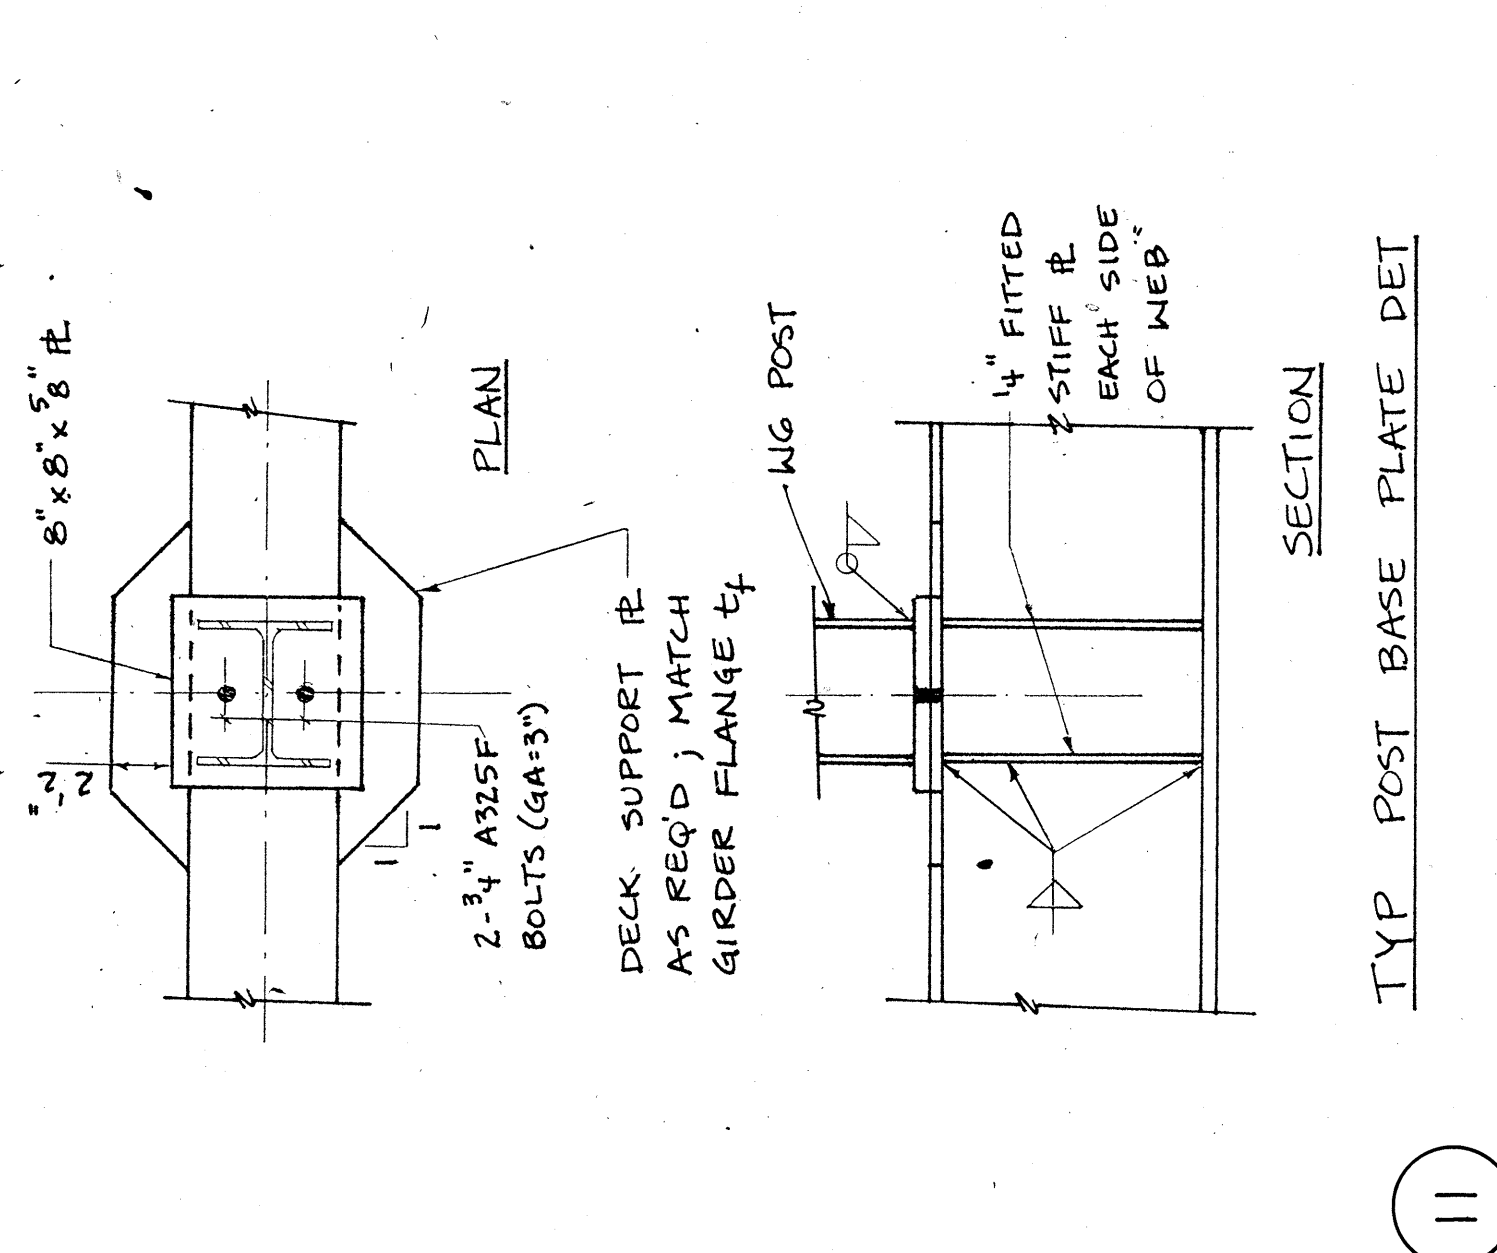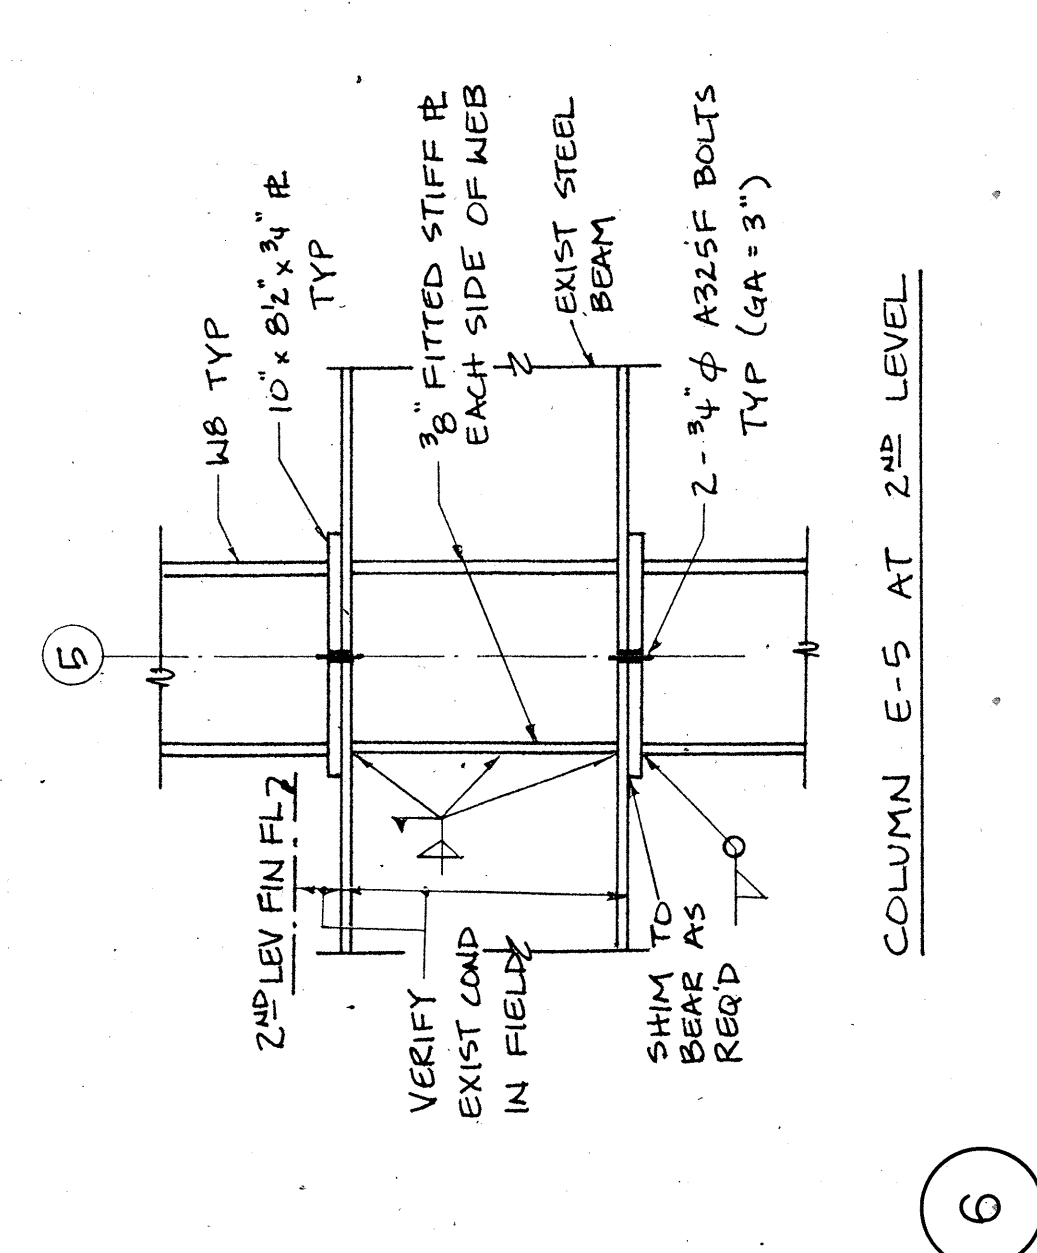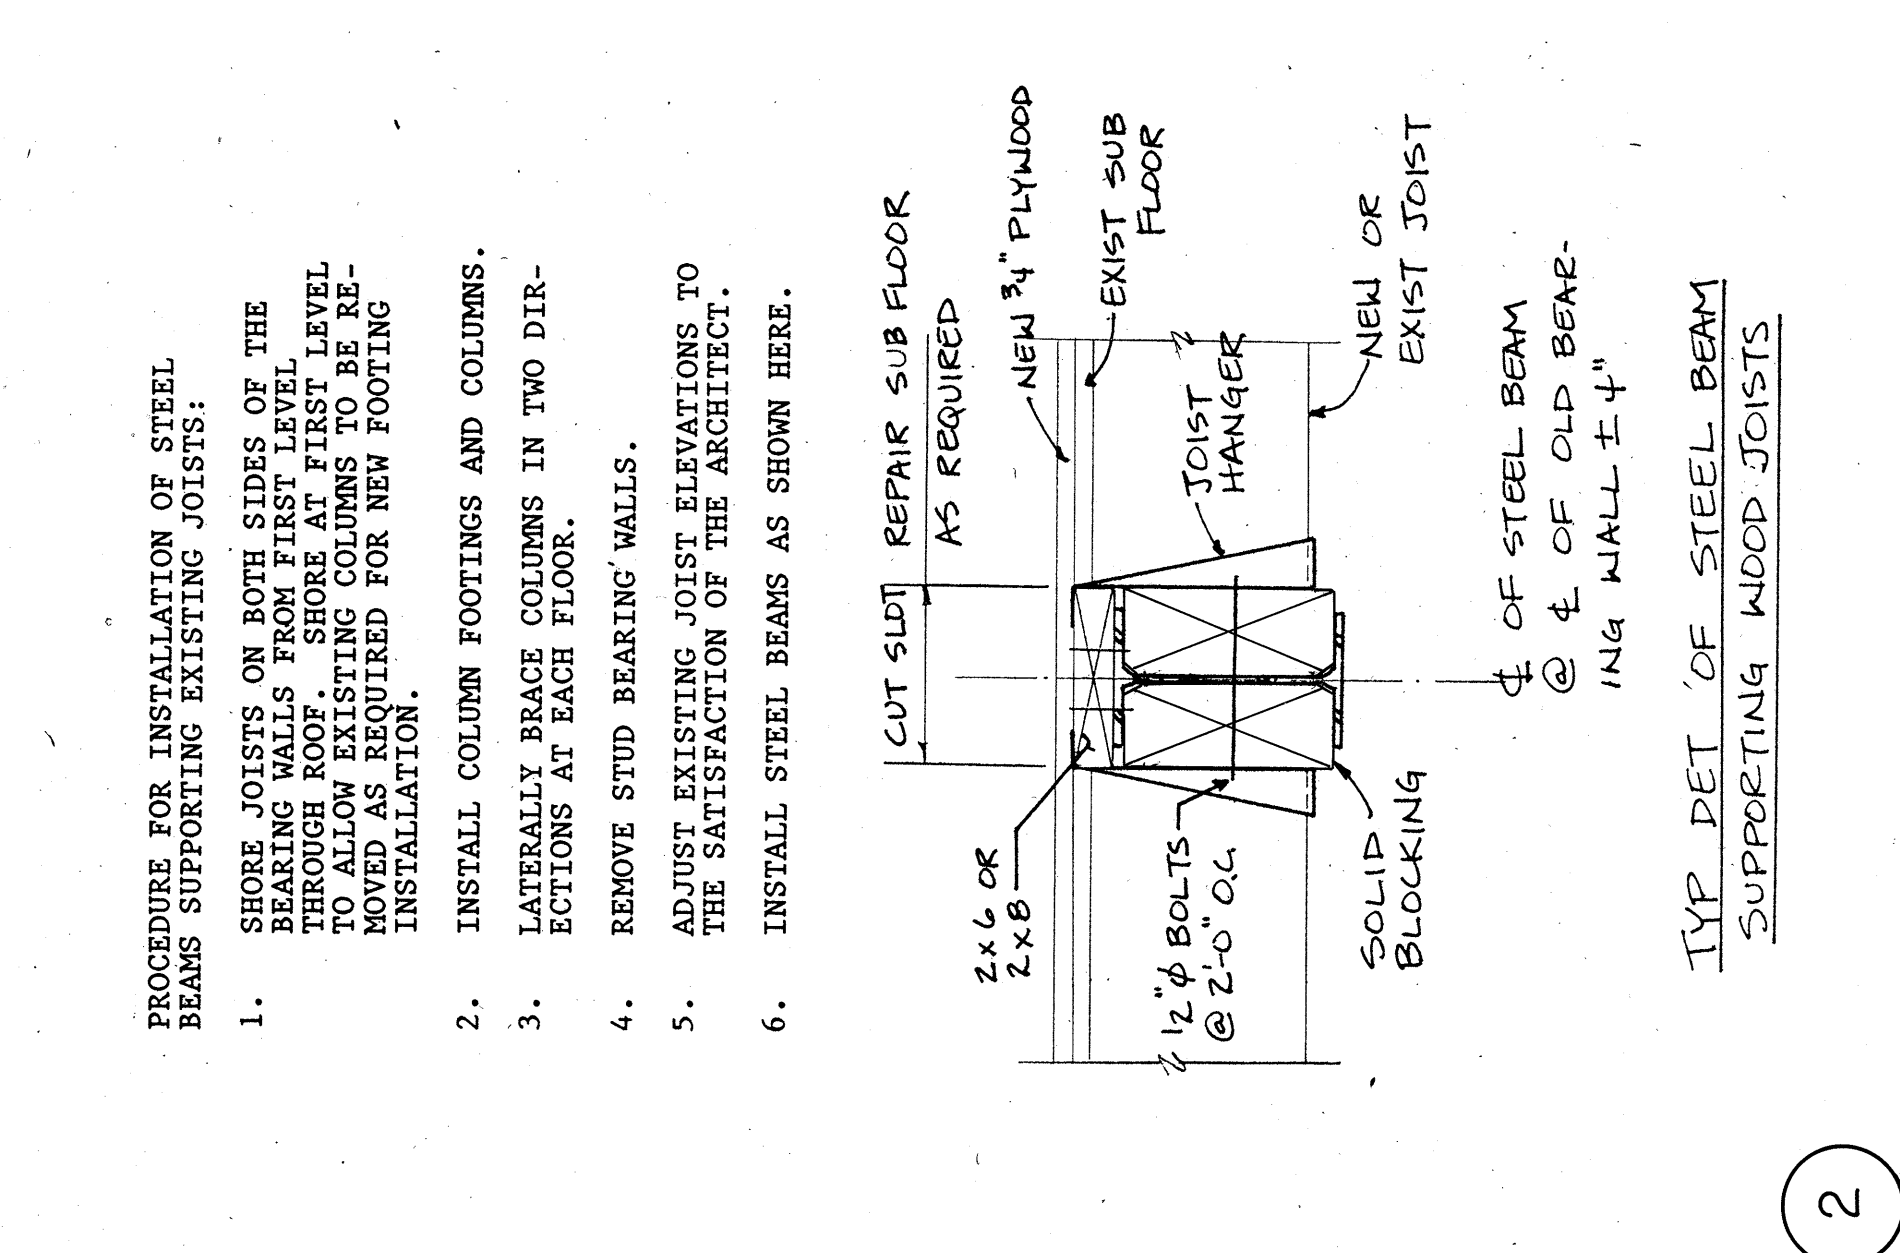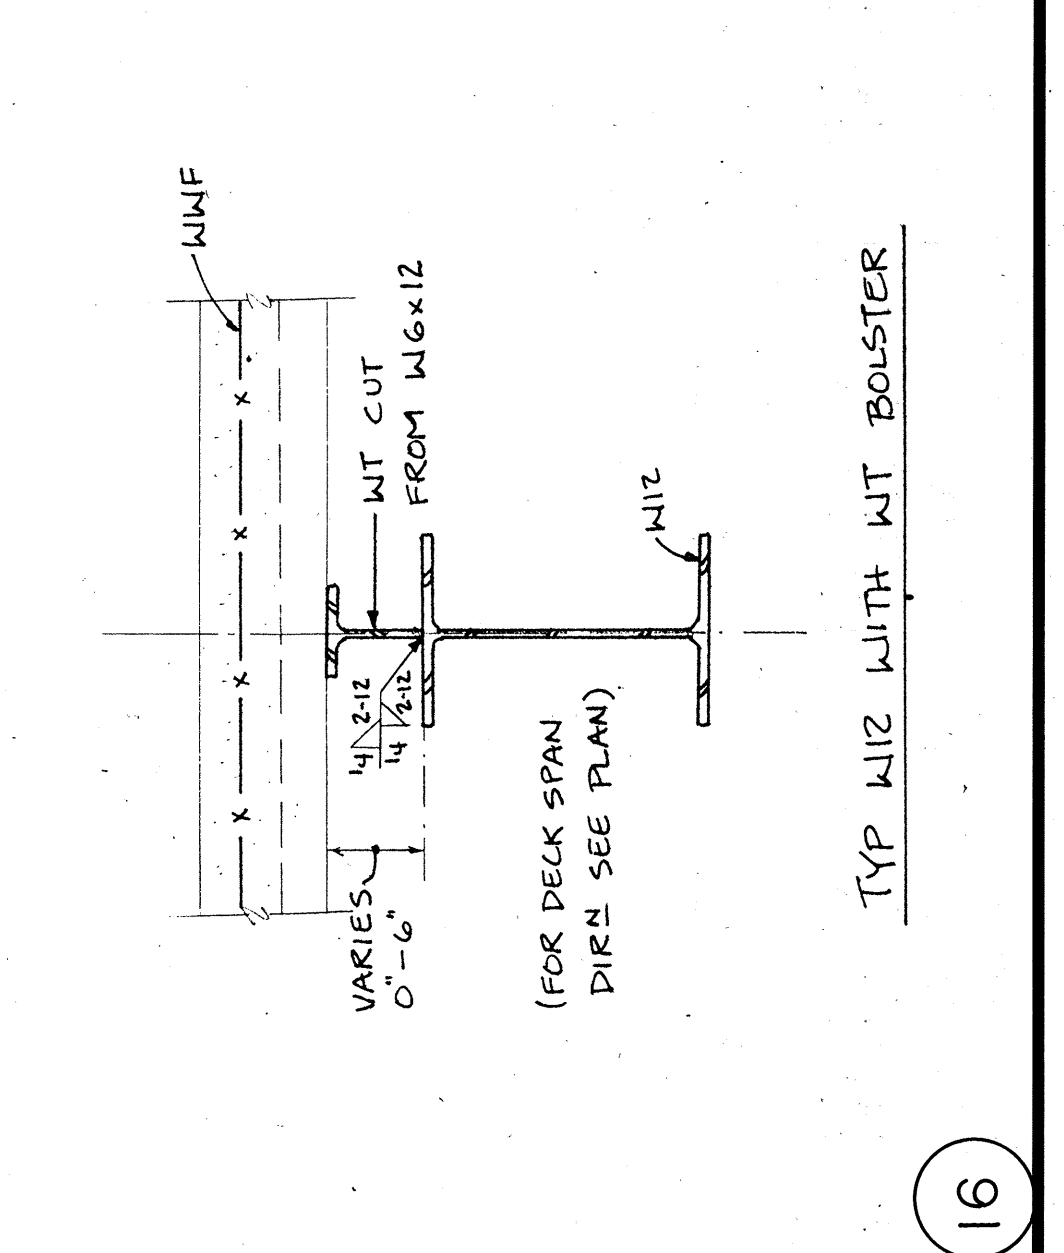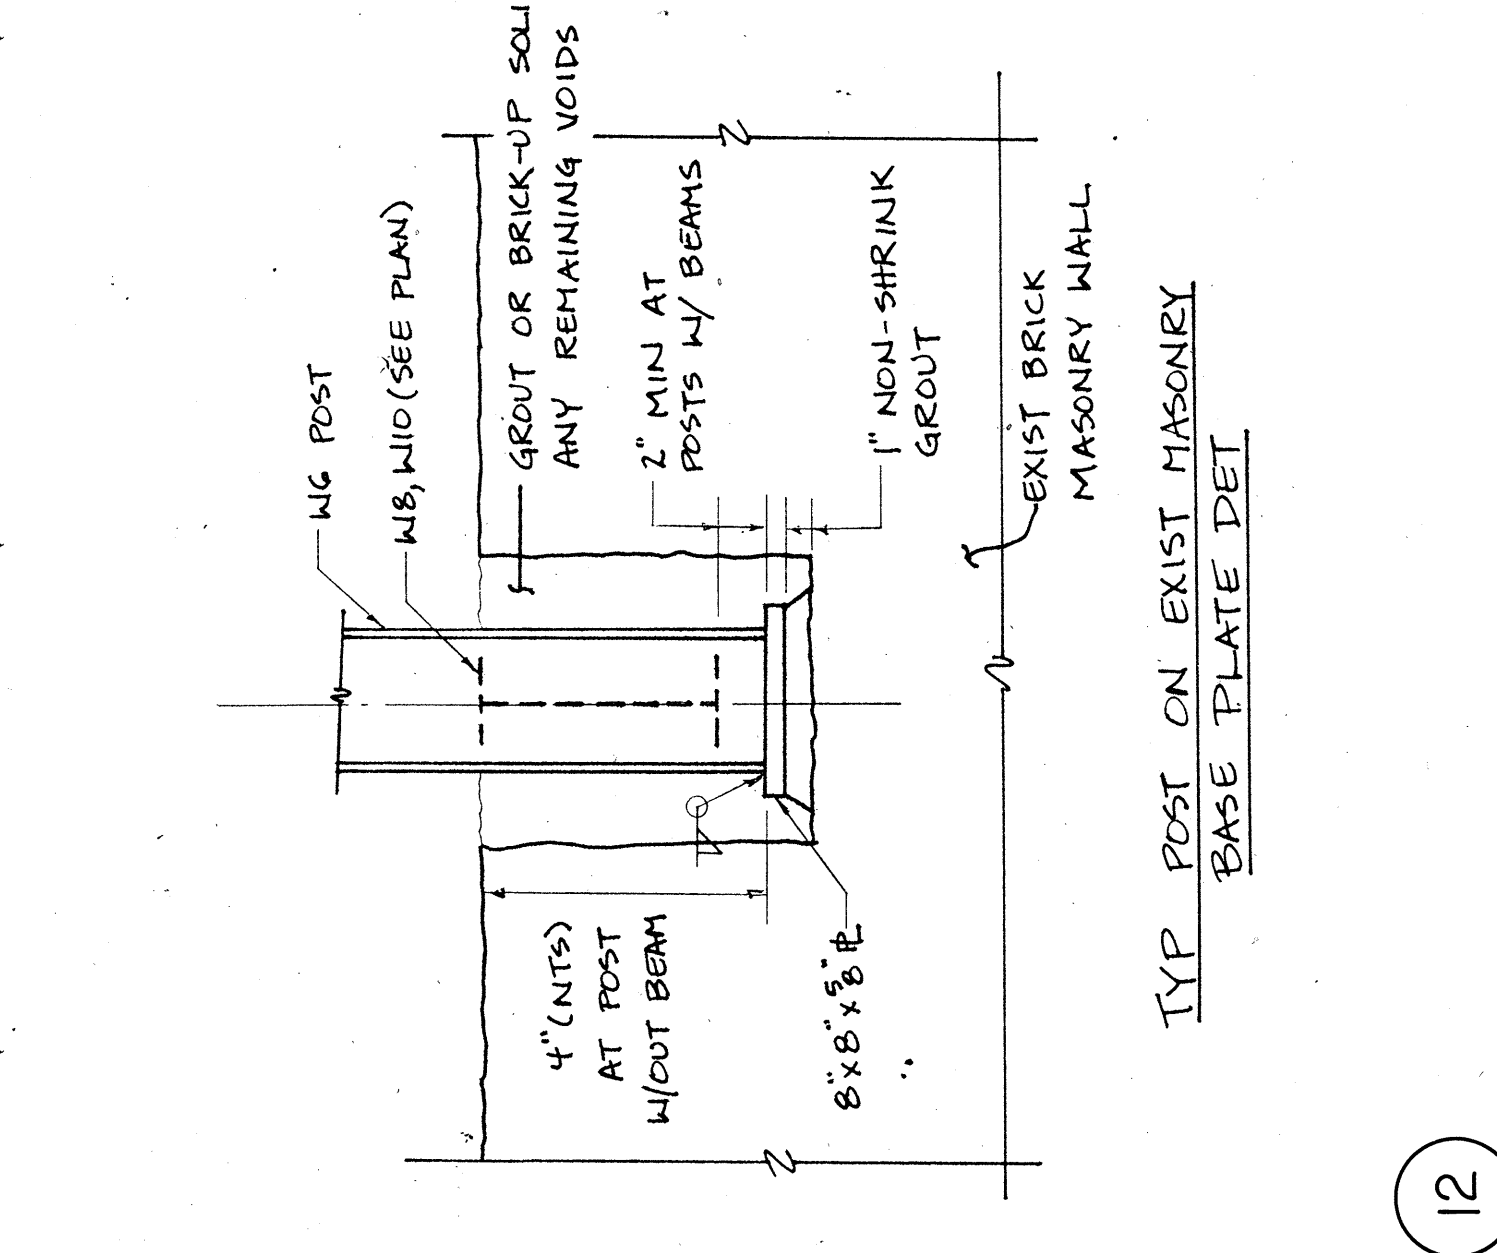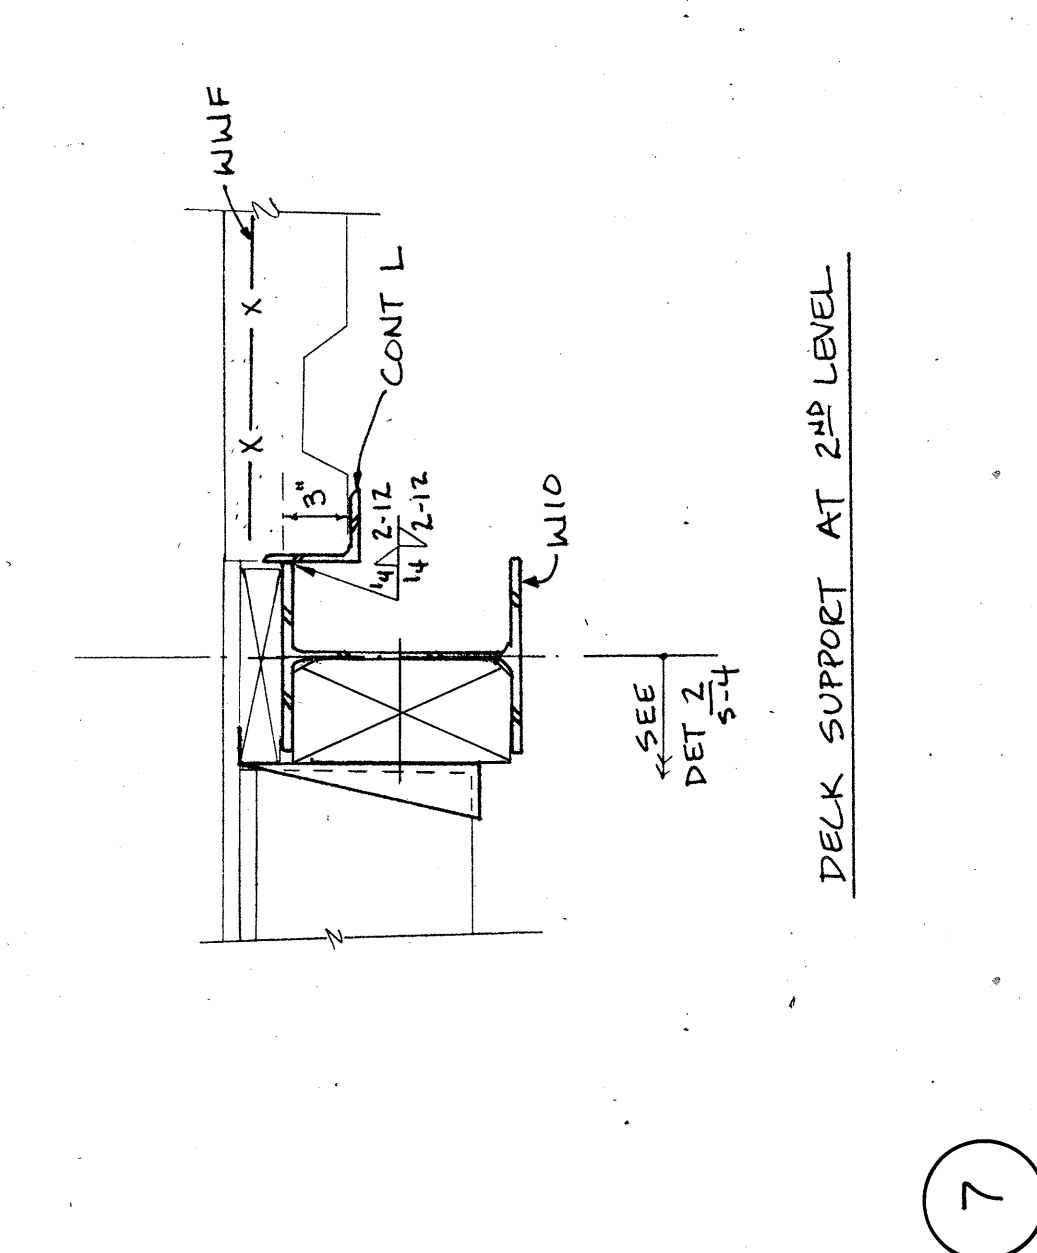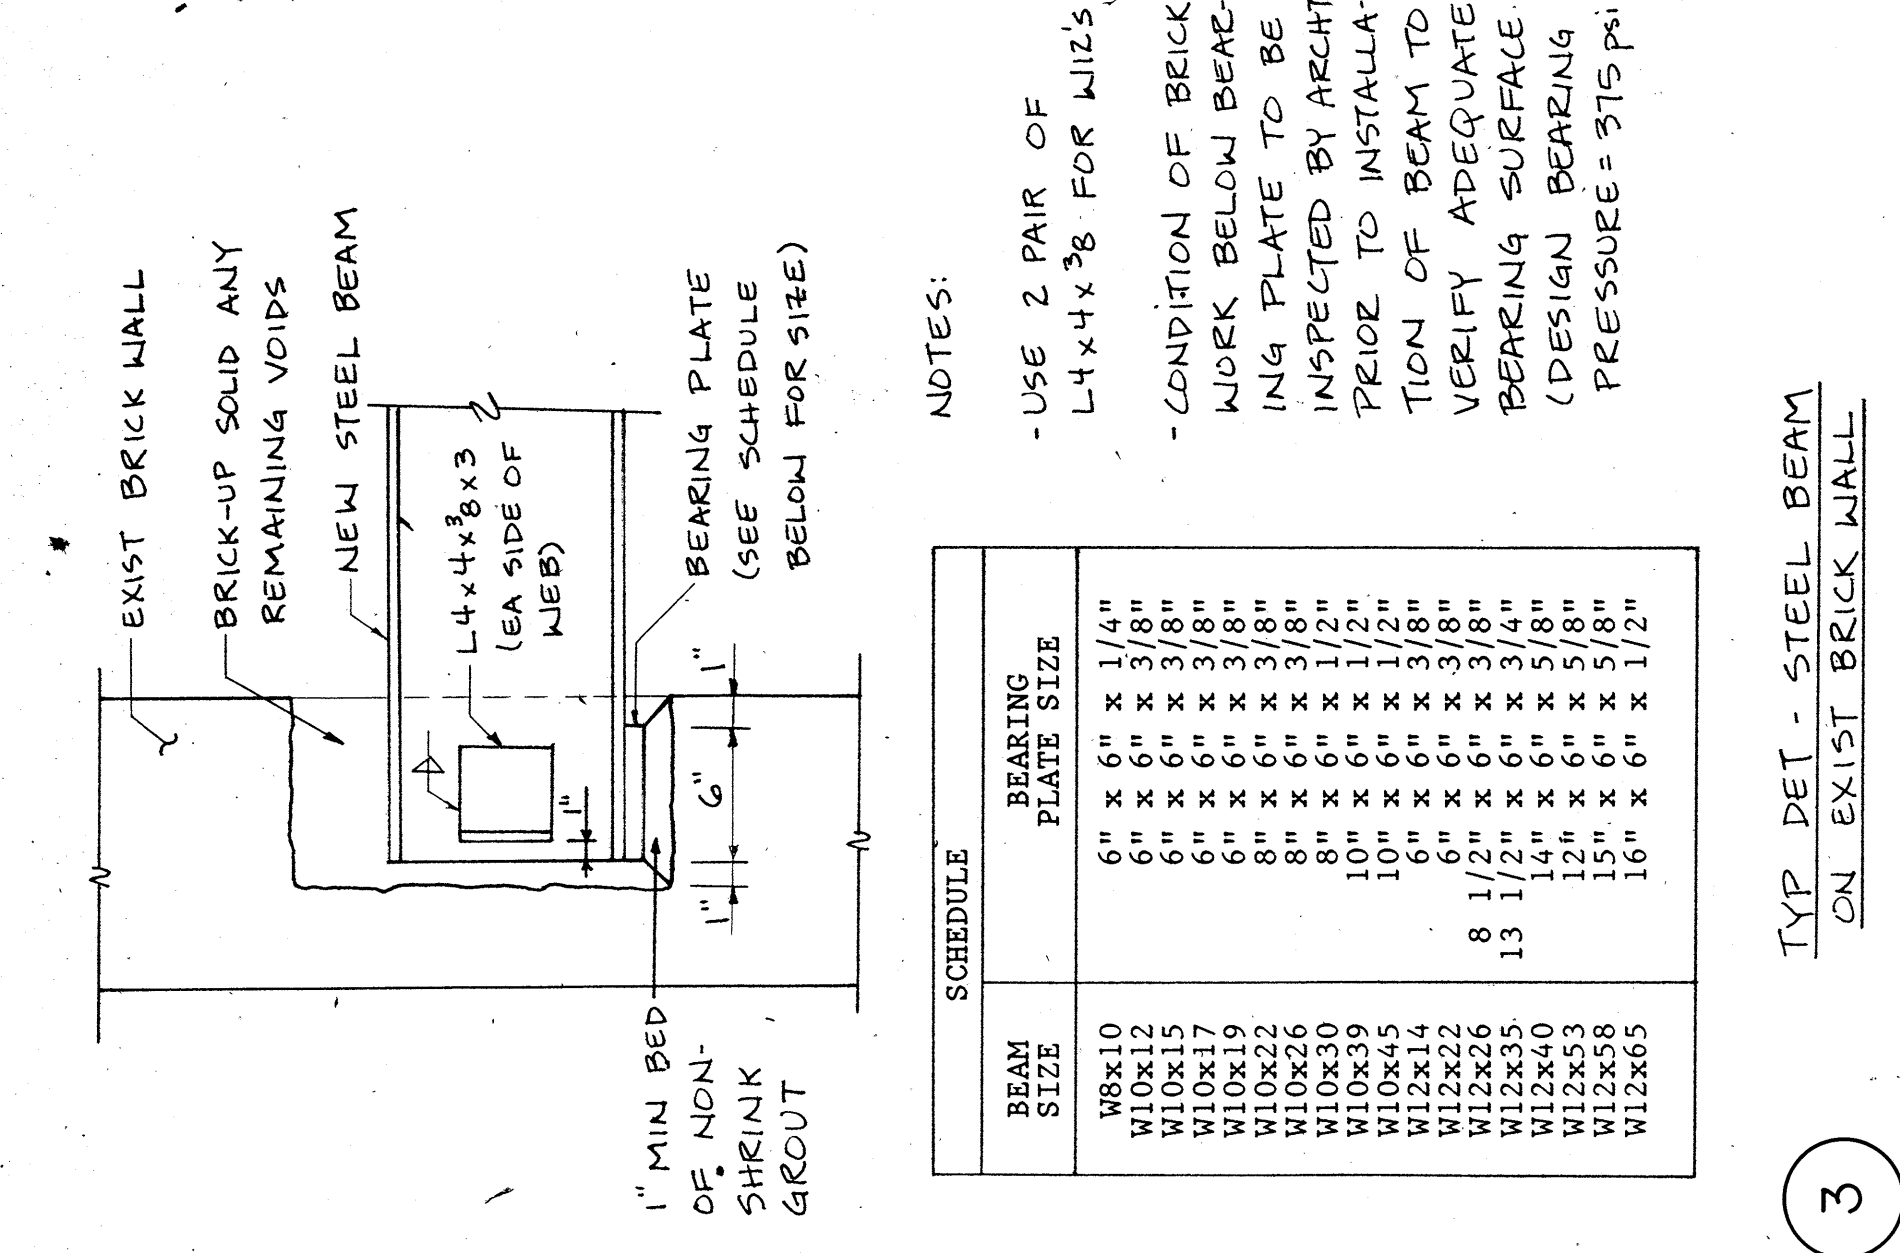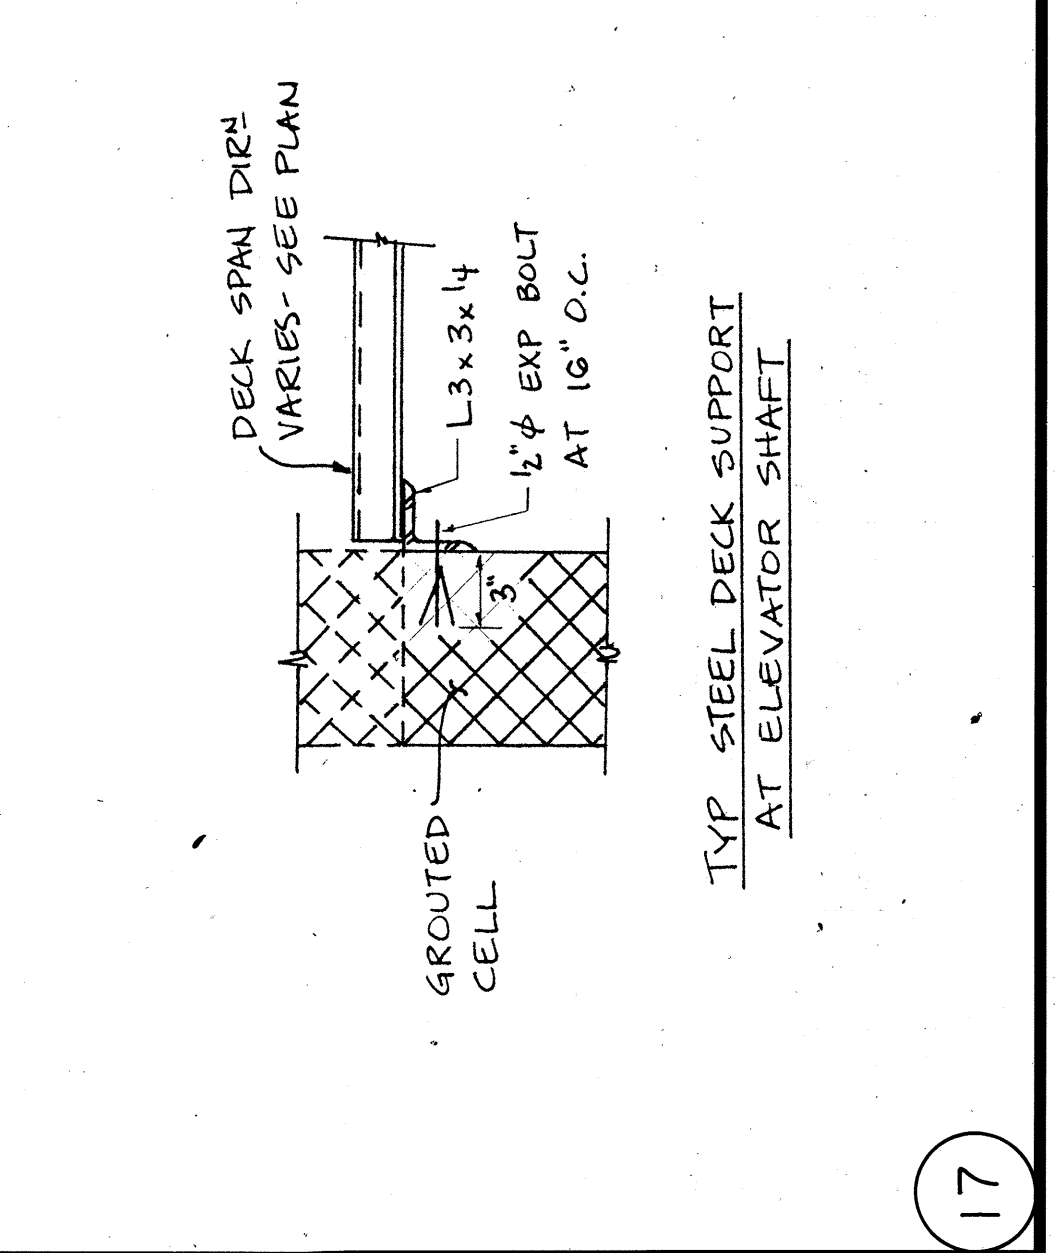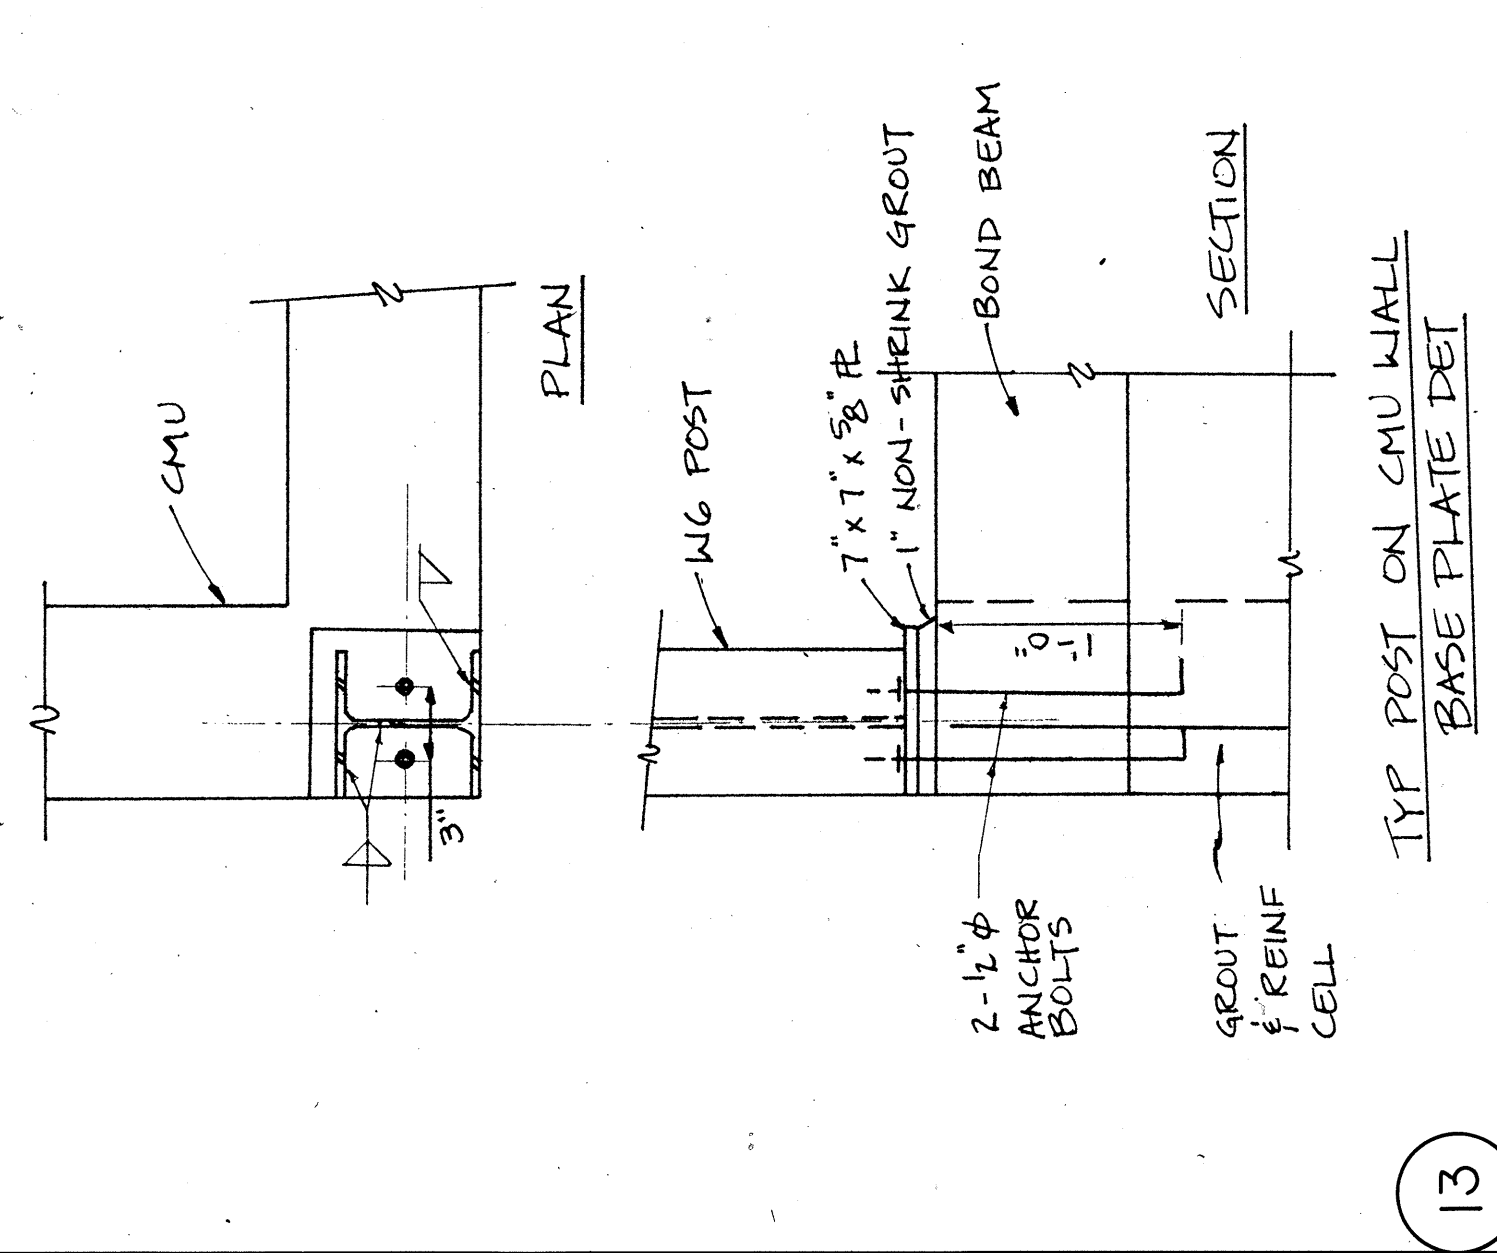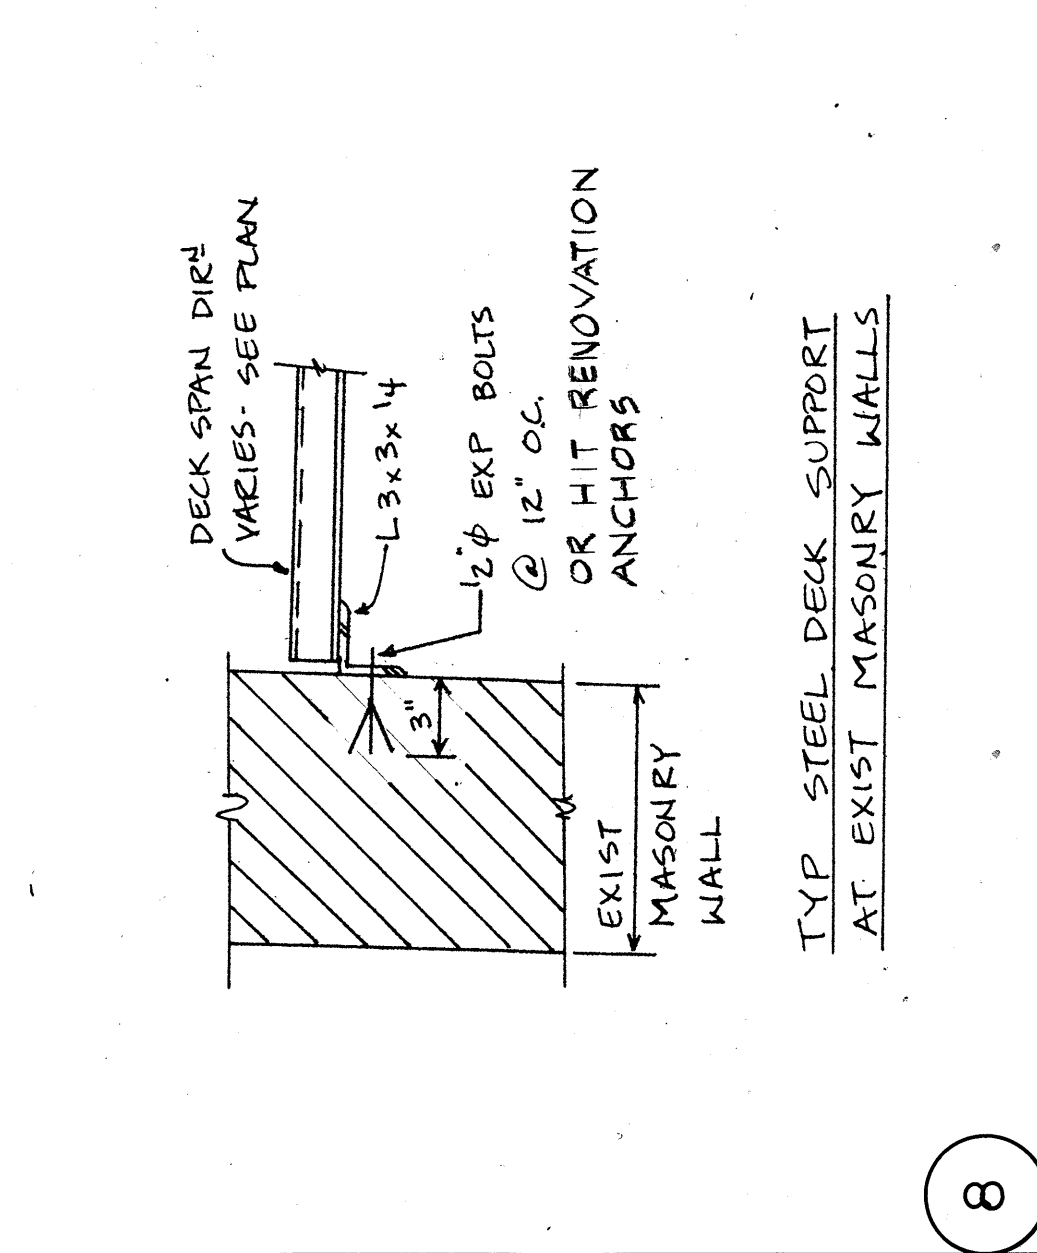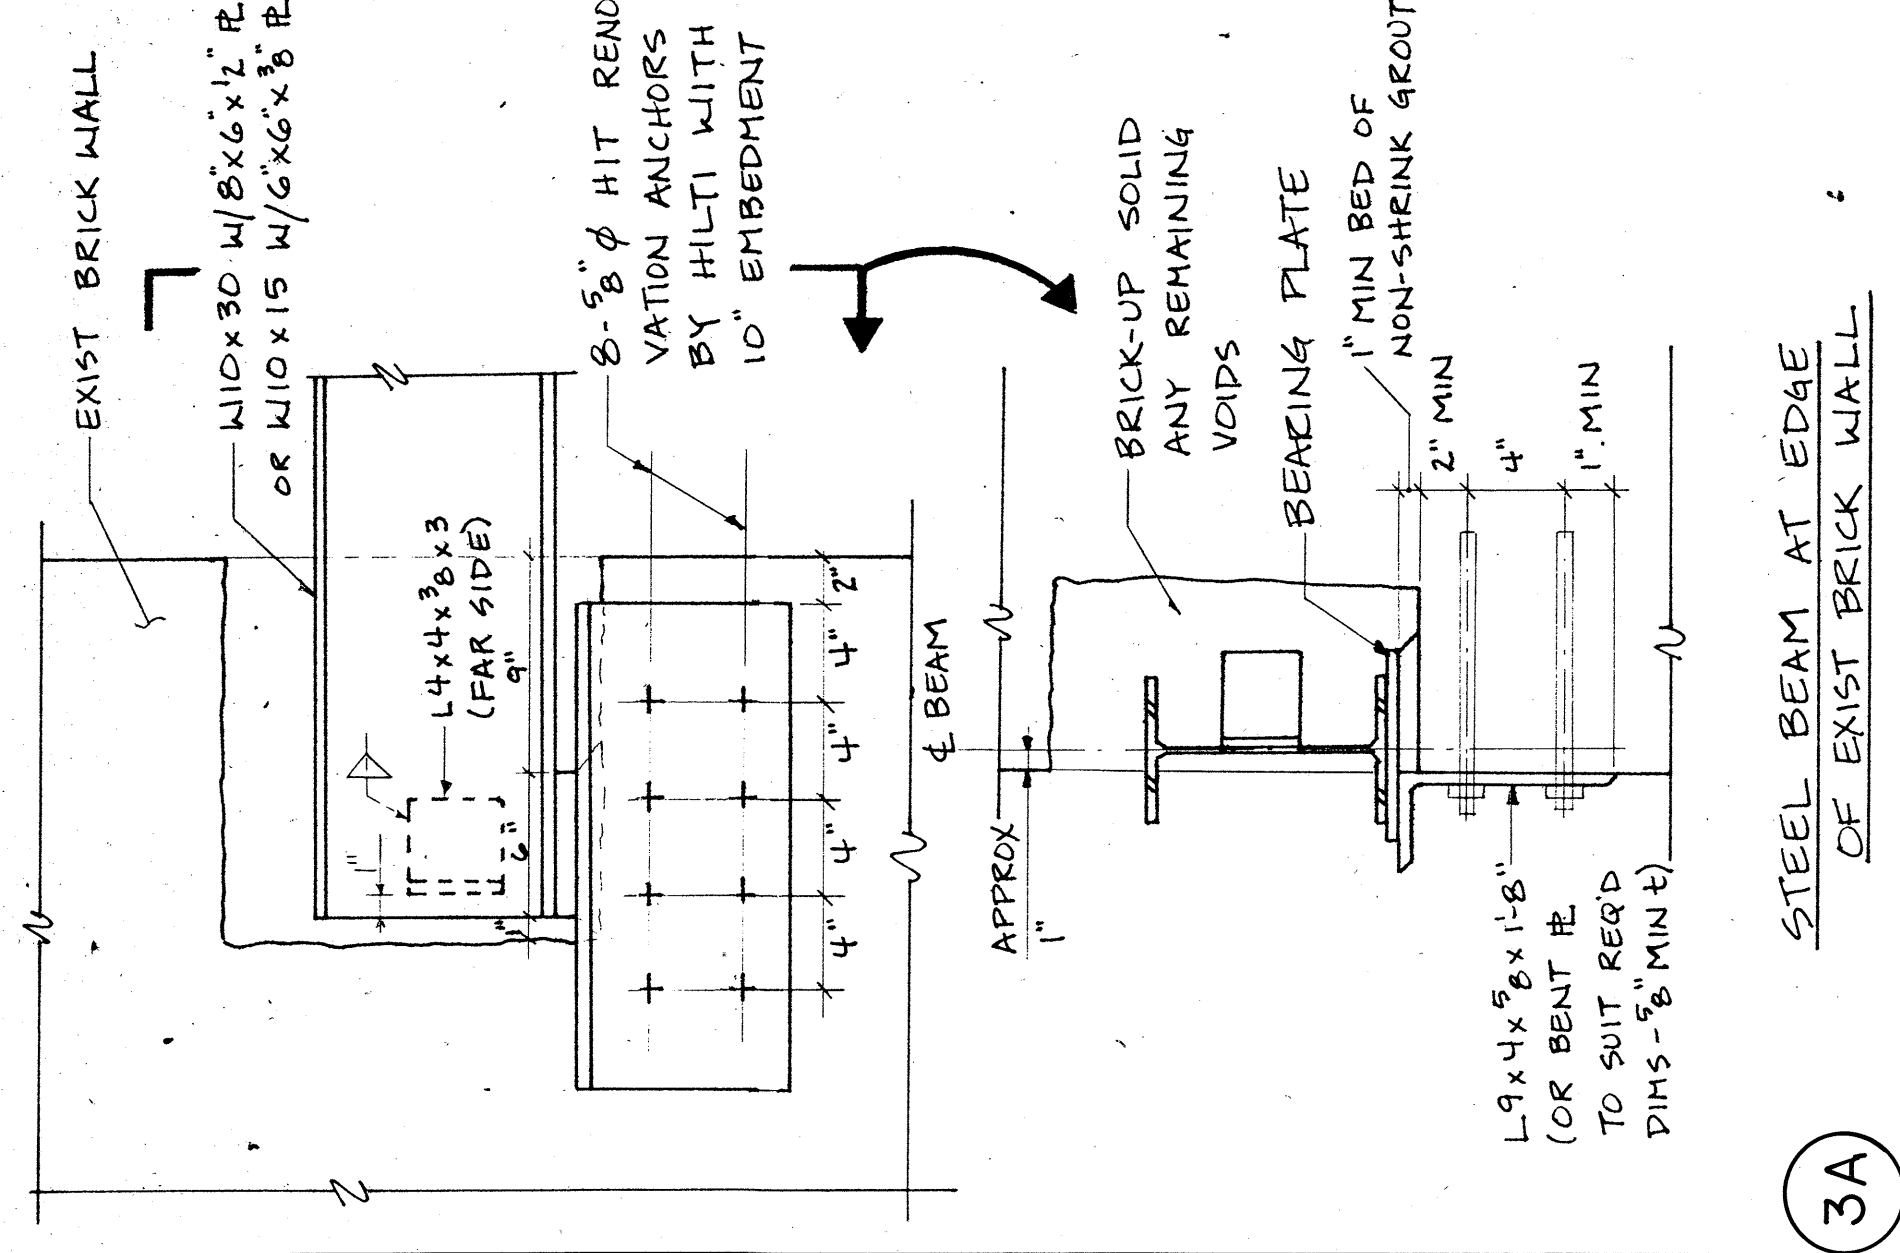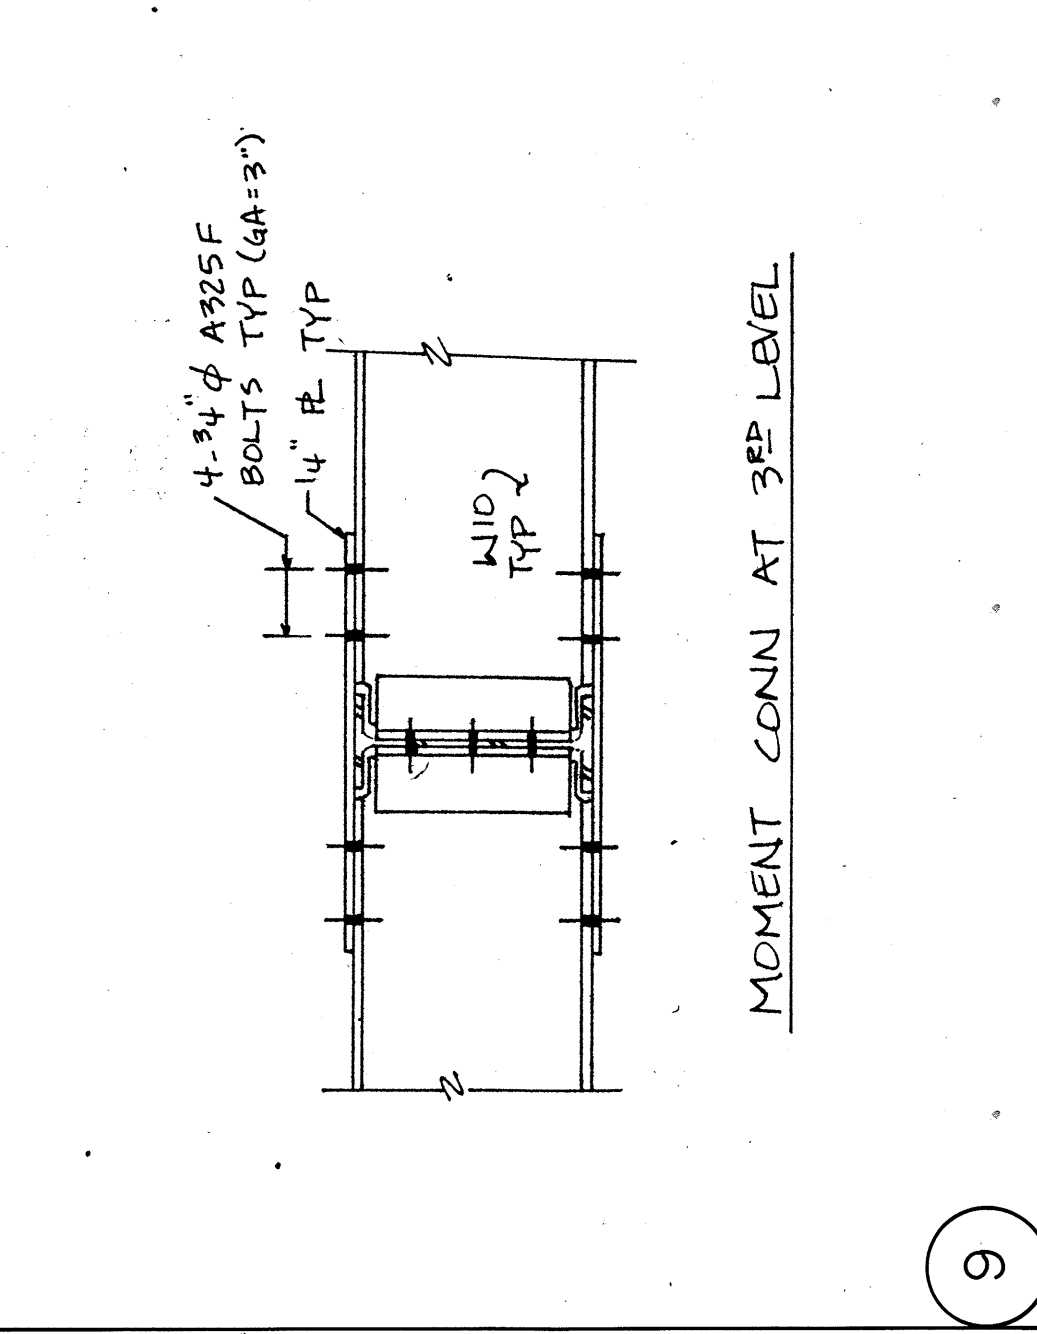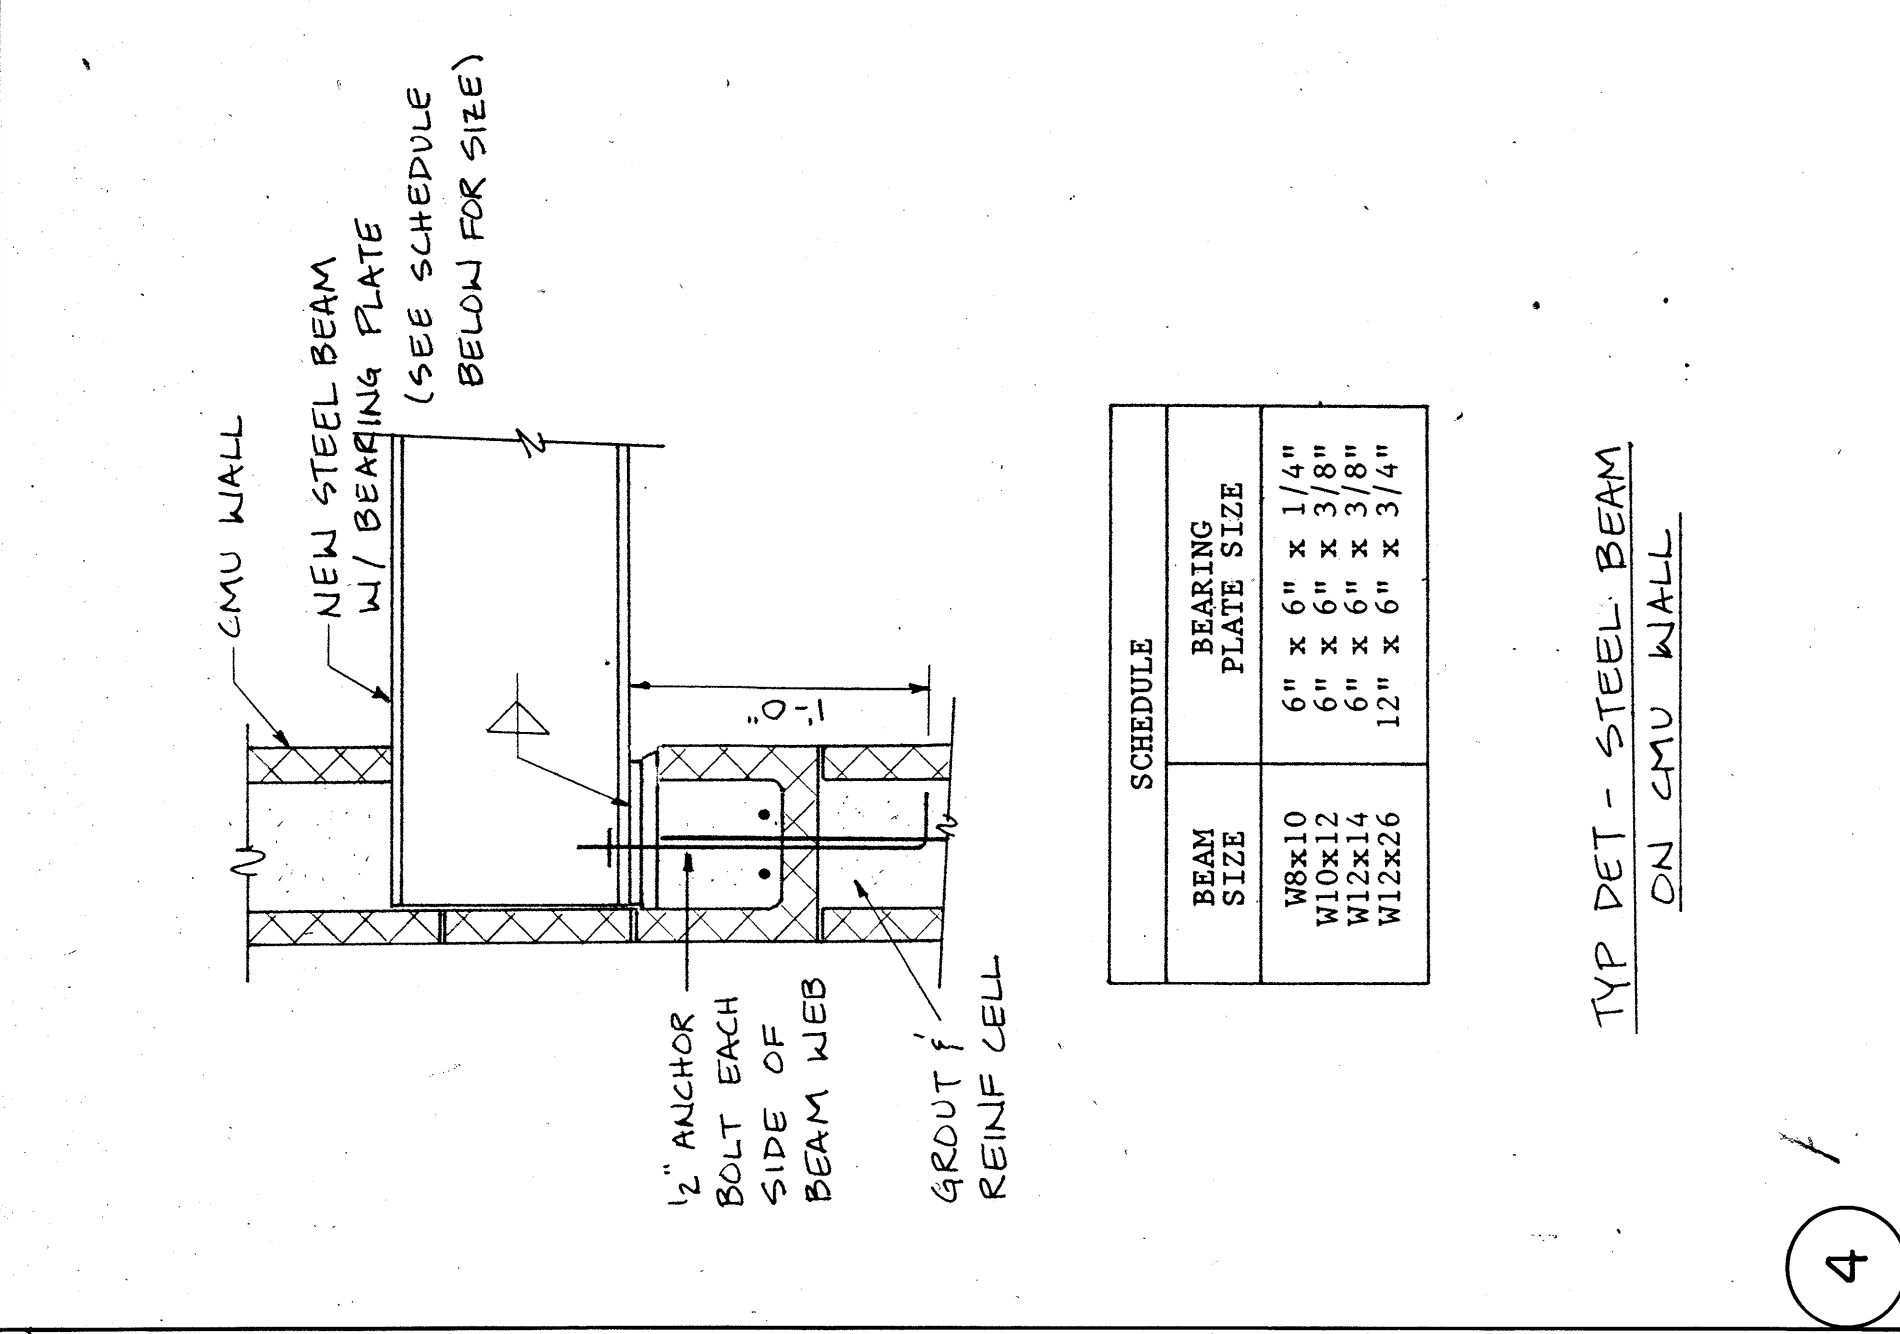

**FOOTING AND COLUMN SCHEDULE**

FOOTING MARK	FOOTING SIZE	FOOTING REIN	FOOTING SHEET
A1-A7	8' x 8'	4 #4	4-1
A8-B1	8' x 8'	4 #4	4-2
A8-B7	8' x 8'	4 #4	4-3
ROOF			
1 <sup>ST</sup> LEVEL			
2 <sup>ND</sup> LEVEL			
3 <sup>RD</sup> LEVEL			
4 <sup>TH</sup> LEVEL			
5 <sup>TH</sup> LEVEL			
6 <sup>TH</sup> LEVEL			
BASE PL			
FOOTING SHEET			
REIN			

