


BENJAMIN THOMPSON & ASSOCIATES, INC. ARCHITECTURE, PLANNING, AND URBANISM ONE STOREY STREET CAMBRIDGE, MA 02138 (617) 876-4800 FAX (617) 861-9213, 868-8923

Cosentini Consulting Engineers 44 Brattle Street Cambridge, Massachusetts 02138 (617) 876-3850 FAX (617) 876-6647

LeMessurier Consultants 1033 Massachusetts Avenue Cambridge, Massachusetts 02138 (617) 868-1200 FAX (617) 661-7520

RENOVATIONS TO 51 BRATTLE STREET

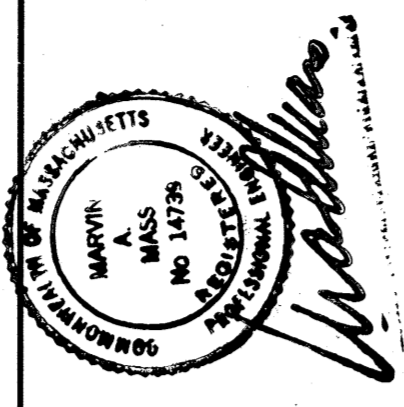

KEY: --- 2 HR. WALL [hatched] NEW MASONRY INFILL

RECORD SET 15 SEPT. 1992

FOURTH LEVEL PLAN P-5. Includes revision table and drawing metadata.

