


THE DIVISION OF CONTINUING EDUCATION

BENJAMIN THOMPSON & ASSOCIATES, INC. ARCHITECTURE, PLANNING, AND URBANISM

Cosentini Consulting Engineers

LeMessurier Consultants

RENOVATIONS TO 51 BRATTLE STREET

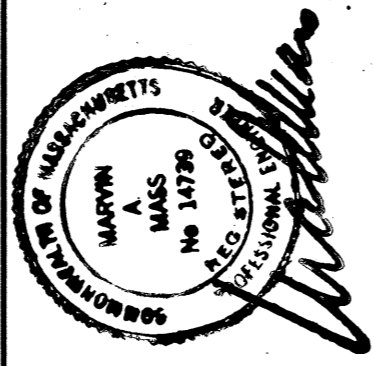

KEY: --- 2 HR. WALL [hatched] NEW MASONRY INFILL

RECORD SET 15 SEPT. 1992

SIXTH LEVEL PLAN P-7. Includes revision table and drawing metadata.

