
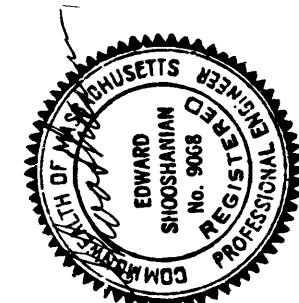



KENNEDY SCHOOL OF GOVERNMENT HARVARD UNIVERSITY

SCALE: 1/8" = 1'-0"  
JOB NO: 7611  
DRAWN: DMOS  
DATE: 20 JULY 77  
REVISIONS:

GROUND FLOOR PLAN

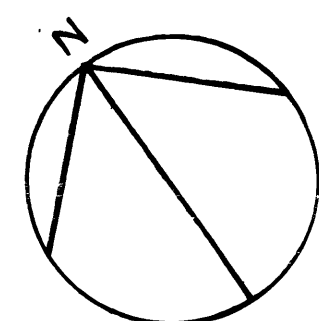

Shoemaker Engineering Assoc  
129 Market Street  
Boston, Massachusetts 02118

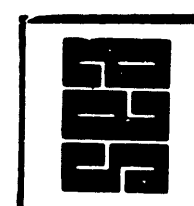

ARCHITECTURAL RESOURCES CAMBRIDGE INC

102 MOUNT AUBURN ST  
CAMBRIDGE MA 02138  
TEL: (617) 547-2200

THOMAS G. GALLAGHER, INC.  
PLUMBING CONTRACTOR  
54 WASHINGTON AVE, CAMBRIDGE, MA.

706-49

RECORD DRAWING  
GROUND FLOOR PLAN

