

GENERAL NOTES





- UNLESS OTHERWISE NOTED, ALL ACT. CEILING & SMOKE SOFFITS ARE @ ELEV. 30'-5 1/2"
- UNLESS OTHERWISE NOTED, ALL FIGURES TO BE 1'-6" AFF.
- ALL DEVICES IN ACT. CEILINGS SUCH AS SMOKE DETECTORS, SPRINKLERS & FIXTURES ARE TO BE CENTERED ON ACoustIC TILE UNITS.
- FOR CEILING OF MAIN LOBBY REFER TO SHIT. A-10

BELFER CENTER
FIRST FLOOR PLAN
1000 sq. ft.
7-12-83

PILGRIM FIRE PROTECTION CO. 4068
Automatic-Sprinkler-Systems
122A DORCHESTER AVE.
DORCHESTER, MA 02125

SCALE: 1/4"=1'-0" DATE: 11-22-83

LEGEND
• PROPERTY OF P.A. GRANVILLE
AS-BUILT SURFACE

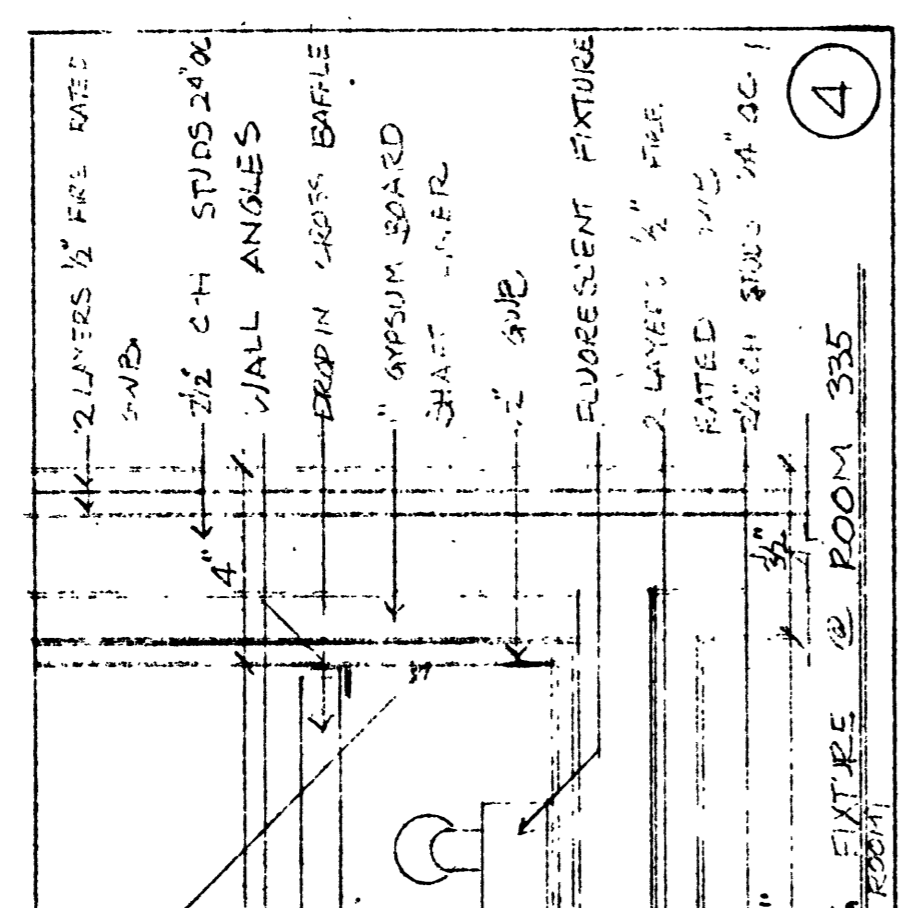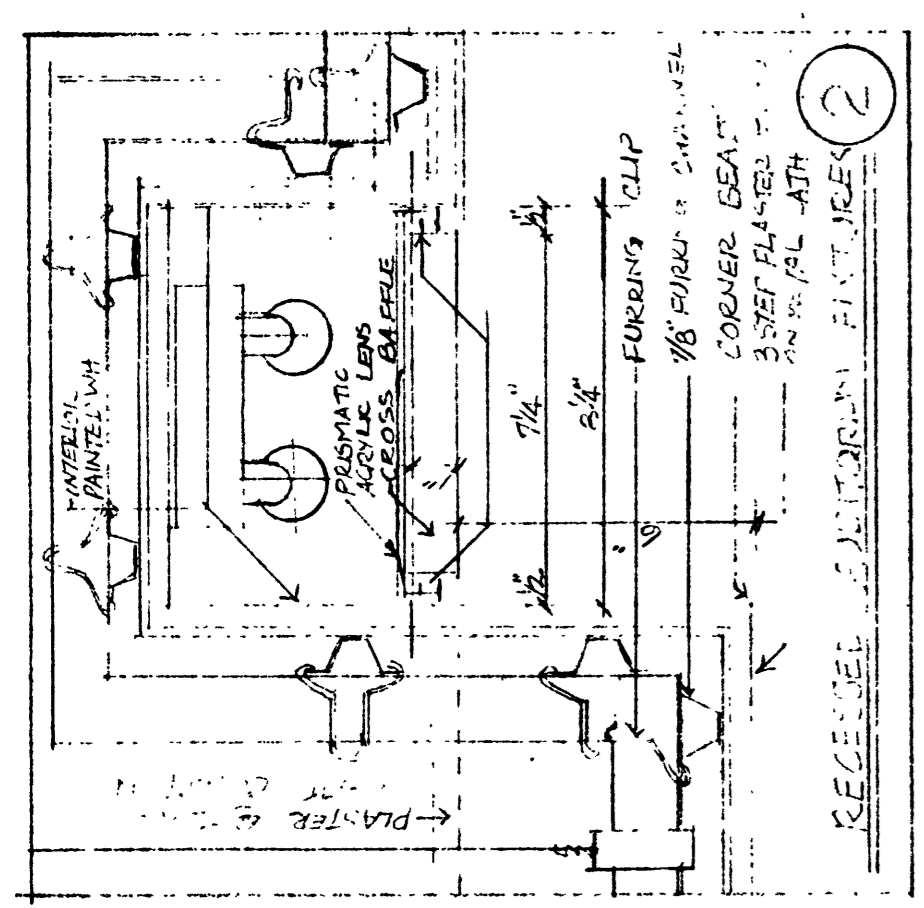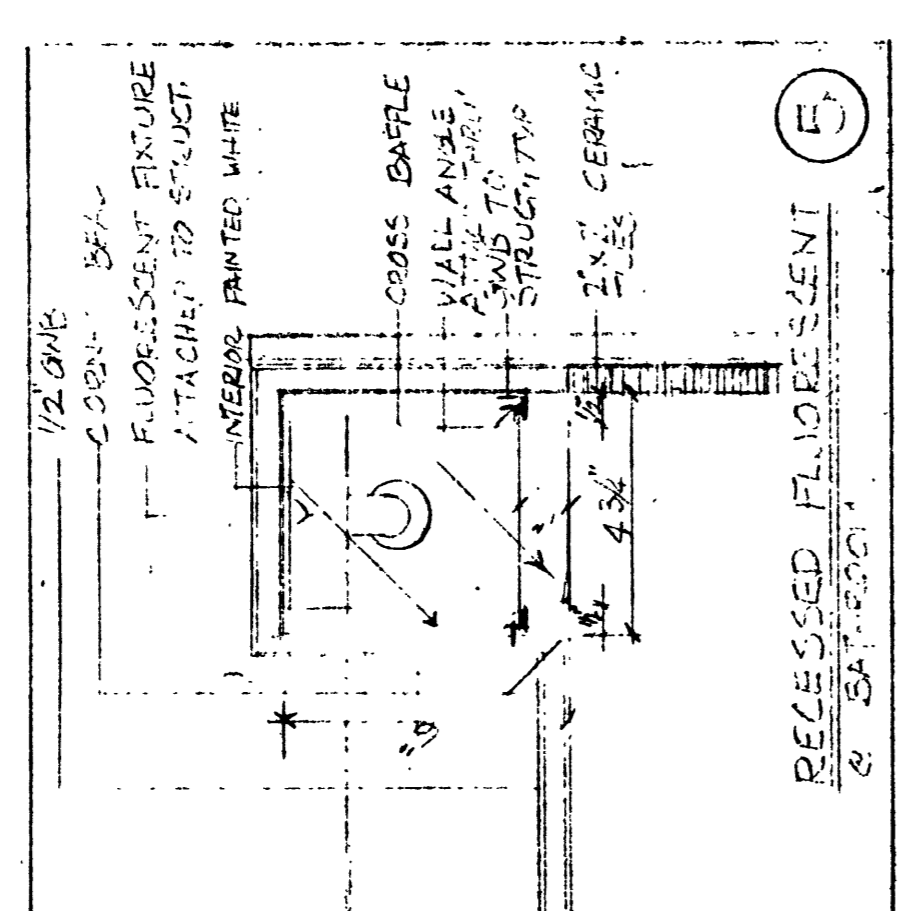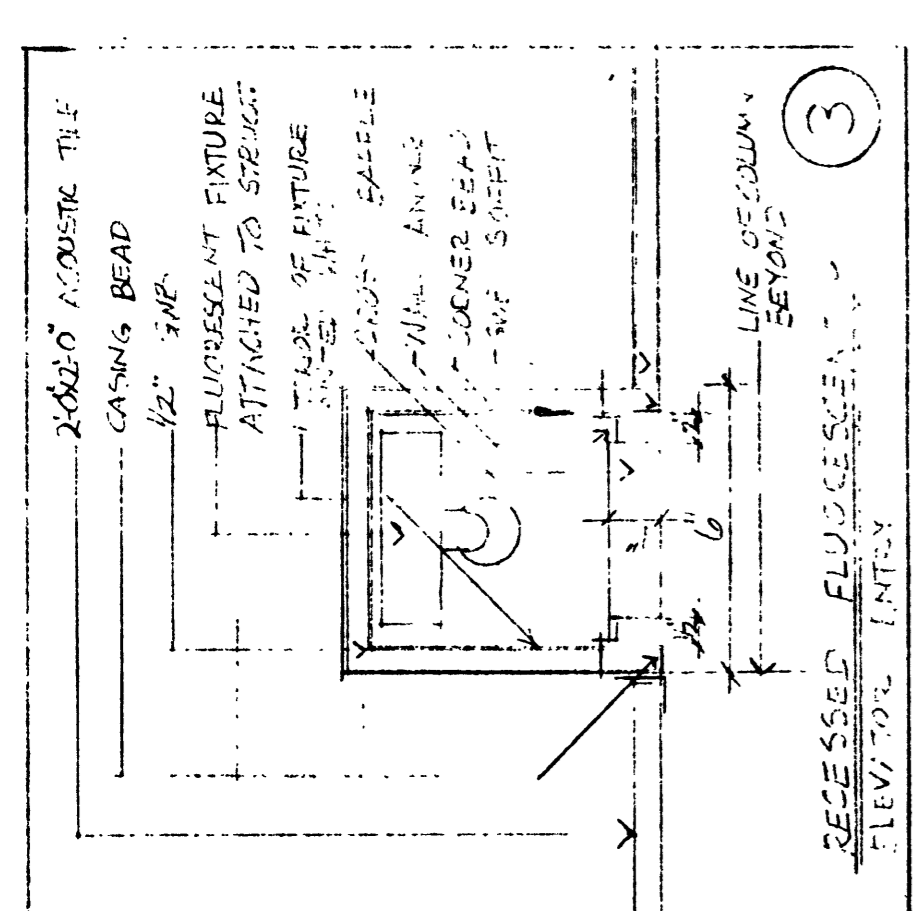

NOTES:
ACoustIC TILE IN LOBBY & CLASSROOM. FIXTURES TO BE 1'-6\"/>

