


ALLIED CONSULTANTS
 RICHMOND SQ ENGINEERS
 SCHIRMER ENGINEERING
 COLLECTIVE WISDOM CORPORATION

A.R.T. BLACK BOX THEATRE AT 2-4 ARROW STREET, CAMBRIDGE MA
 HARVARD REAL ESTATE SERVICES / AMERICAN REPERTORY THEATRE

MARYANN THOMPSON ARCHITECTS
 14 HILLSIDE AVENUE
 CAMBRIDGE, MA 02140
 T: 617.481.4144
 F: 617.481.3844


BUILDING EGRESS
 NO. OF OCCUPANTS: 200
 DOOR WIDTH REQ'D: 32"
 DOOR WIDTH PROVIDED: 68"
 EXIT CAPACITY: 453
 ACTUAL OCCUPANT LOAD: 100

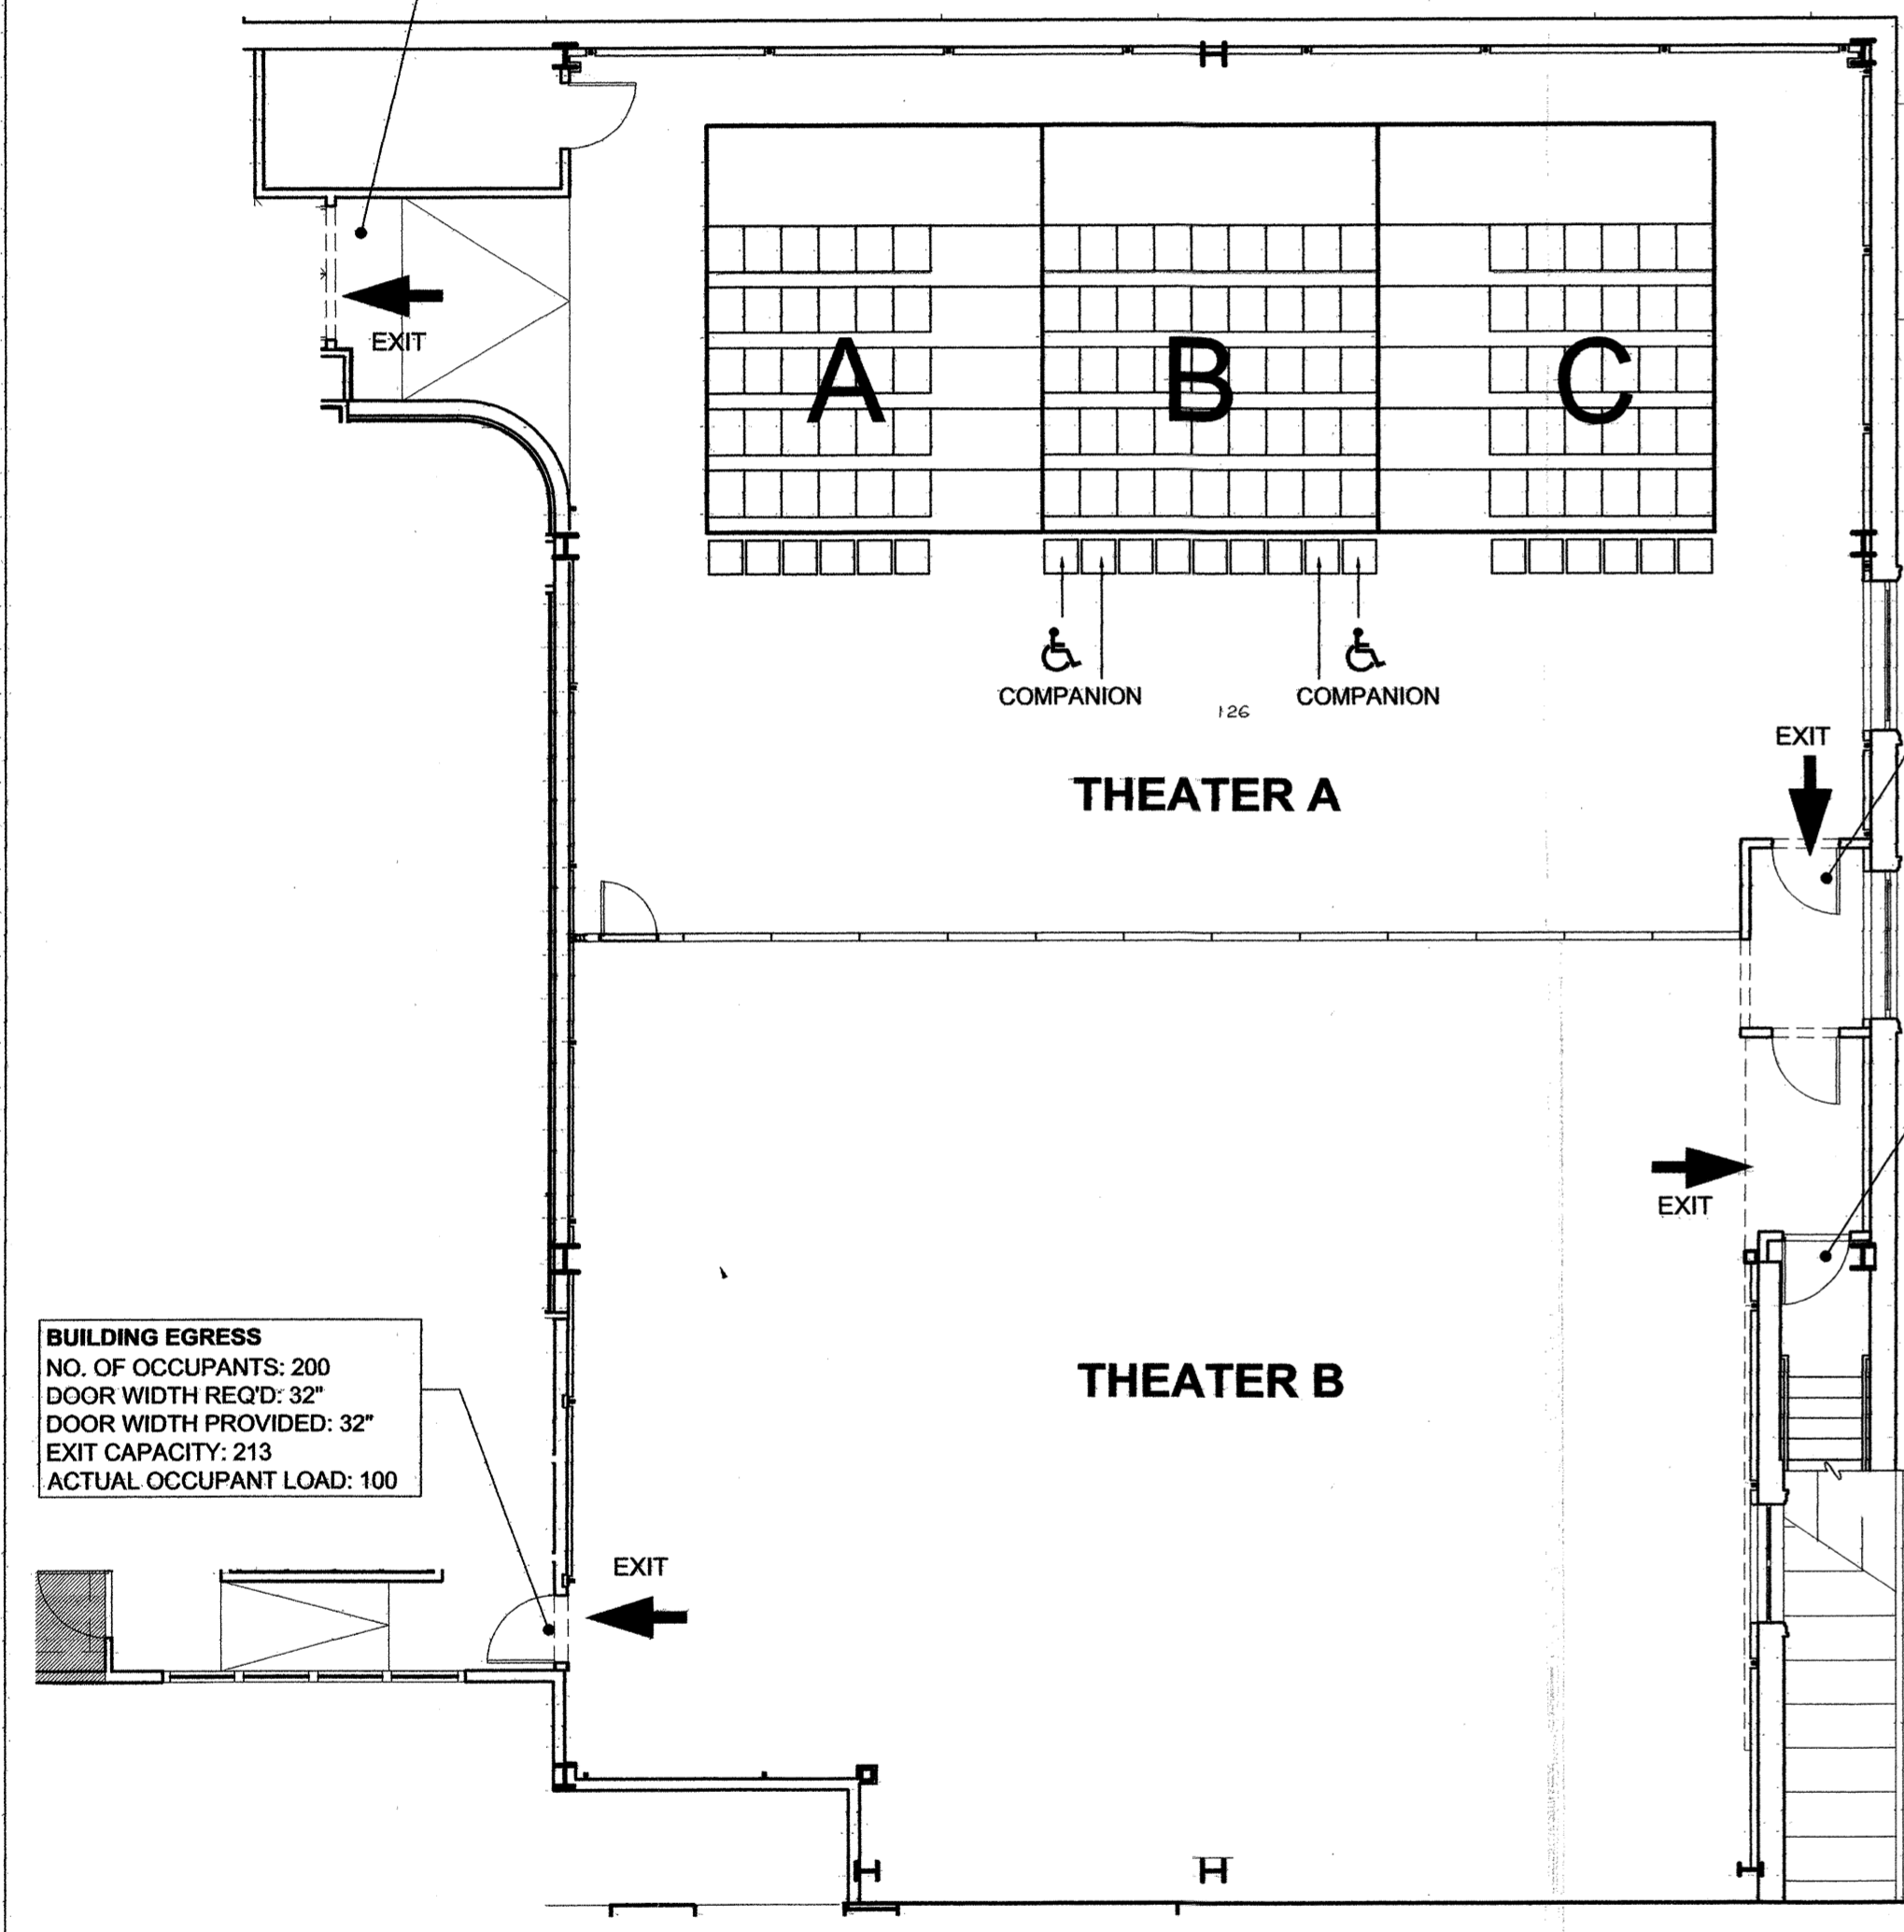

01 THEATER SEATING ARRANGEMENT #E1
 SCALE: 1/8" = 1'-0"

OCCUPANT LOAD
 THEATER A: 200 MAX
 THEATER B: 200 MAX


BUILDING EGRESS
 NO. OF OCCUPANTS: 200
 DOOR WIDTH REQ'D: 32"
 DOOR WIDTH PROVIDED: 68"
 EXIT CAPACITY: 453
 ACTUAL OCCUPANT LOAD: 100

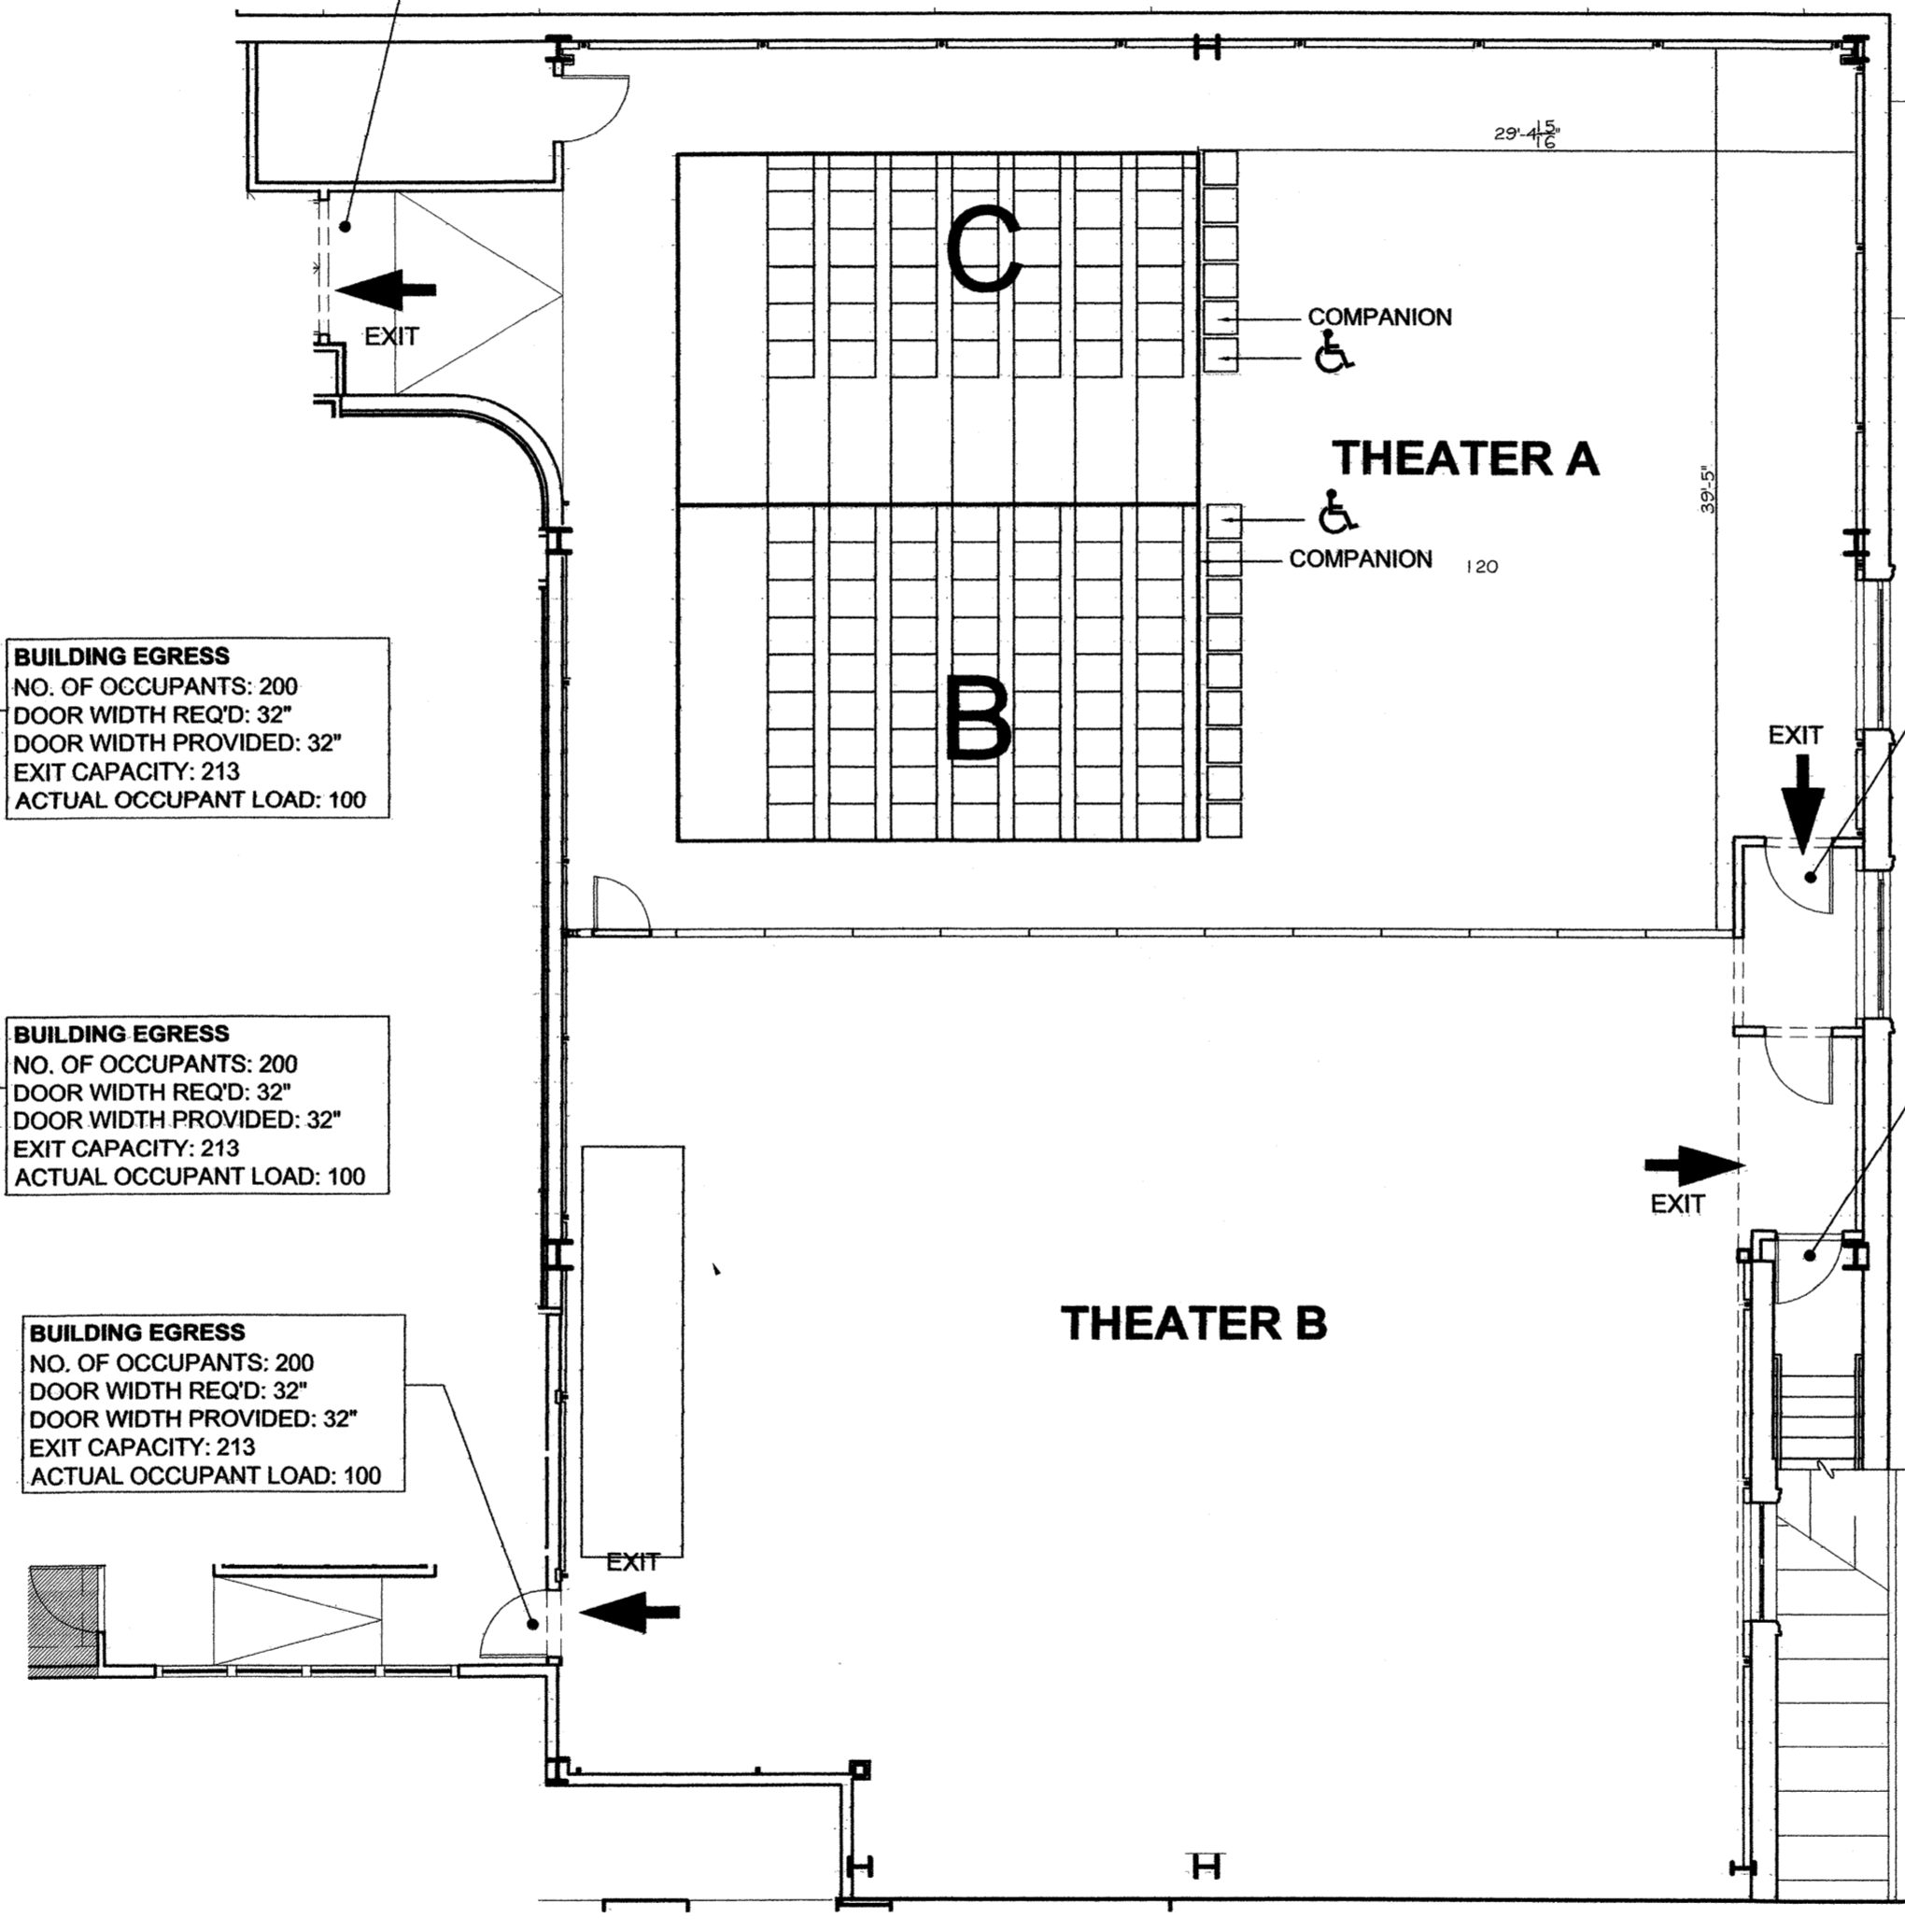

02 THEATER SEATING ARRANGEMENT #E2
 SCALE: 1/8" = 1'-0"

OCCUPANT LOAD
 THEATER A: 200 MAX
 THEATER B: 200 MAX

BUILDING EGRESS
 NO. OF OCCUPANTS: 200
 DOOR WIDTH REQ'D: 32"
 DOOR WIDTH PROVIDED: 68"
 EXIT CAPACITY: 453
 ACTUAL OCCUPANT LOAD: 100

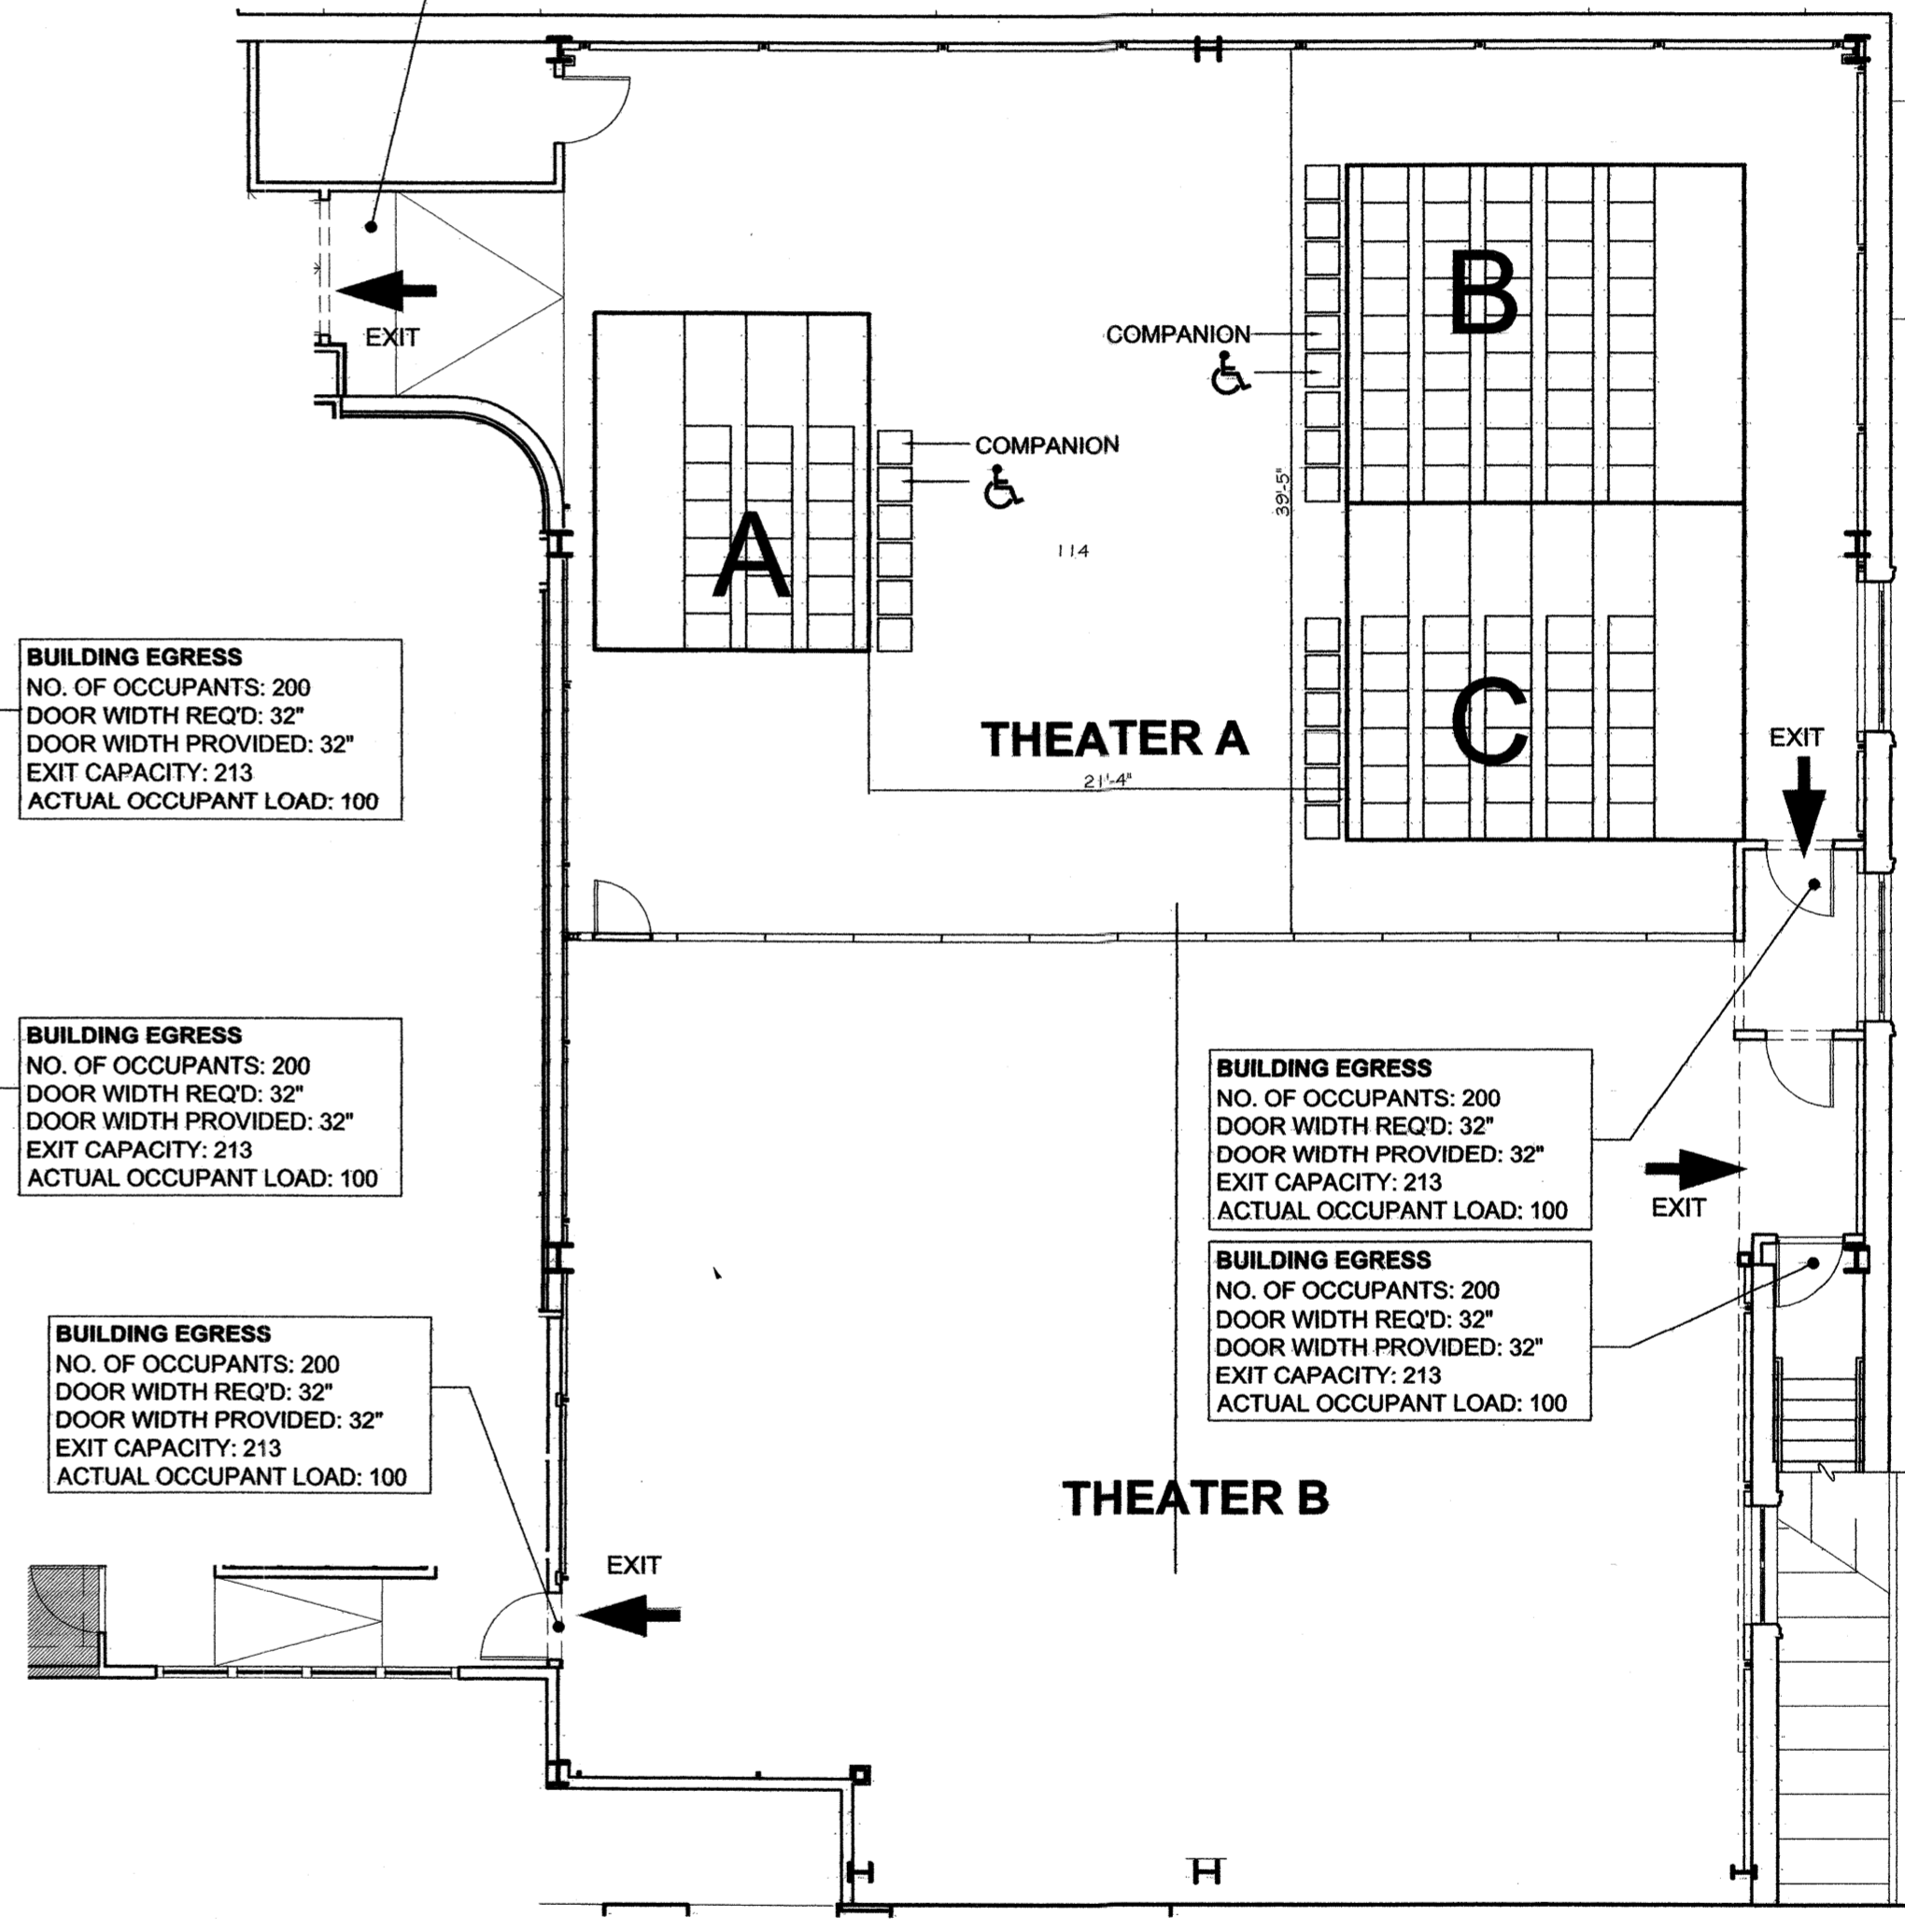

03 THEATER SEATING ARRANGEMENT #E3
 SCALE: 1/8" = 1'-0"

OCCUPANT LOAD
 THEATER A: 200 MAX
 THEATER B: 200 MAX

REVISIONS:	
SET	DATE

CURRENT ISSUE:	
SET	DATE
RECORD SET	04.30.05

DRAWING TITLE:
 THEATER SEATING CONFIGURATIONS/
 LIFE SAFETY

A 1.11