



01 SECTION THROUGH THEATRE
SCALE: 1/4"=1'-0"

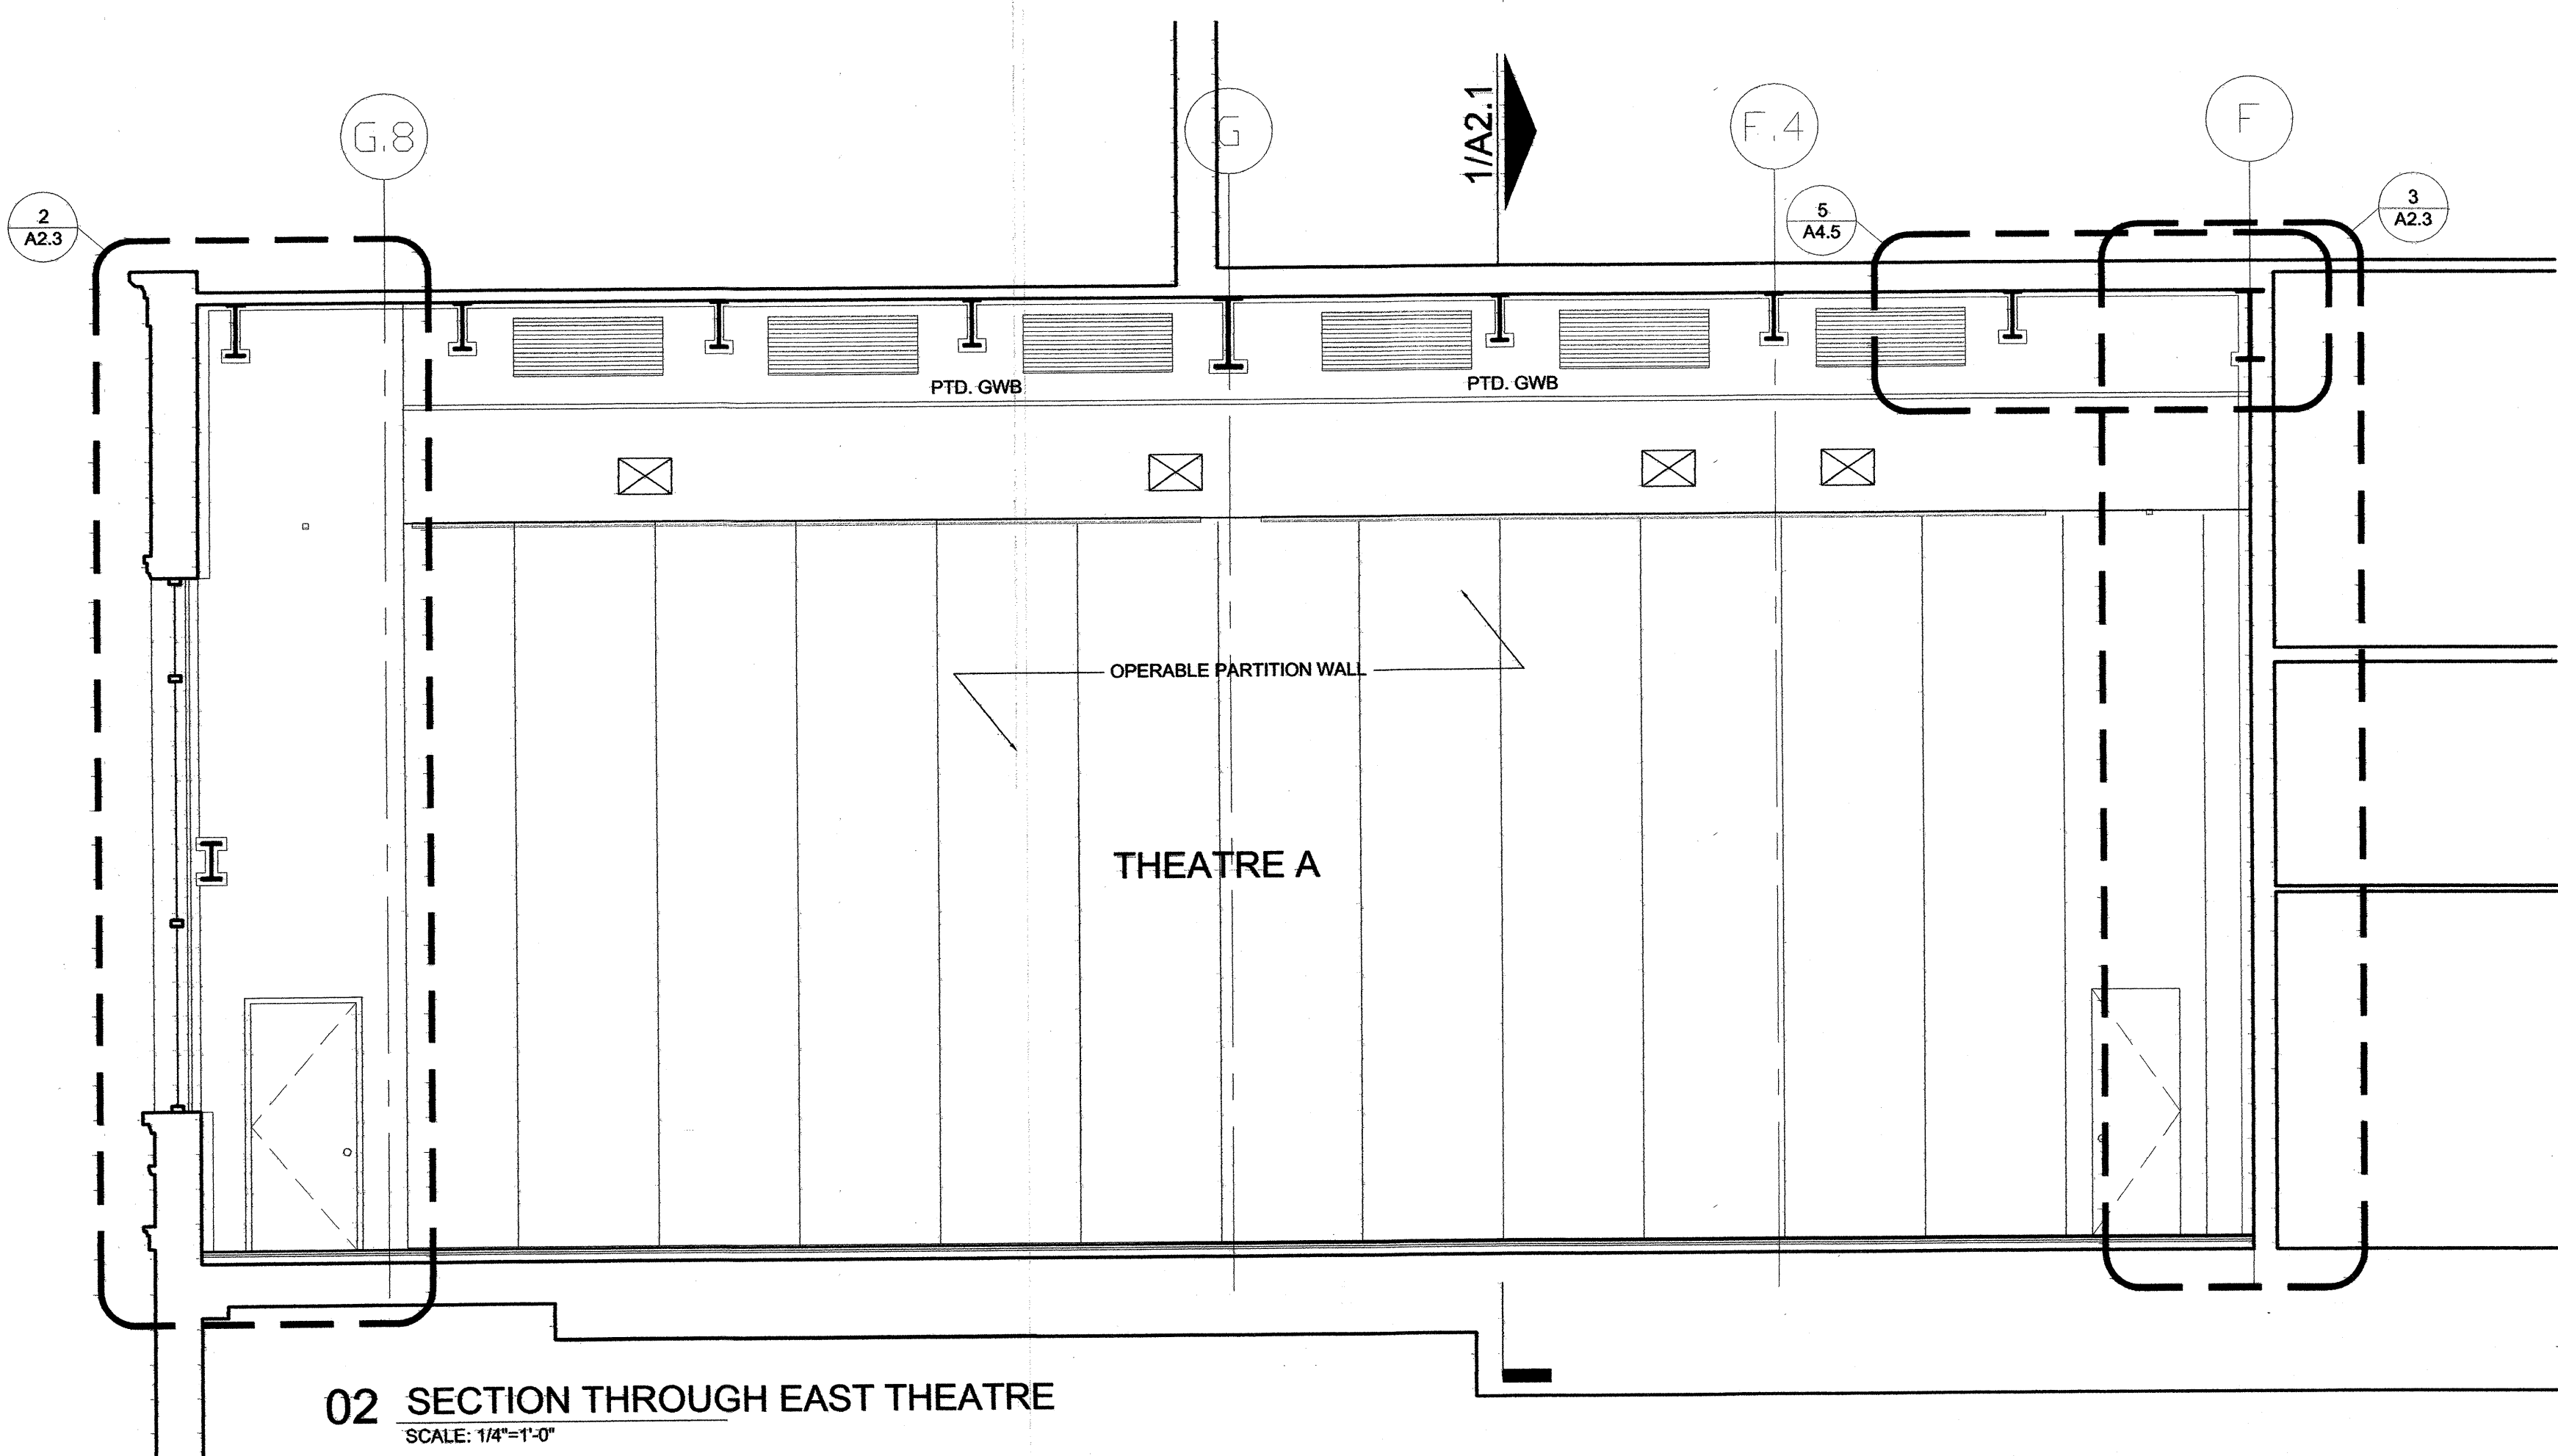

02 SECTION THROUGH EAST THEATRE
SCALE: 1/4"=1'-0"

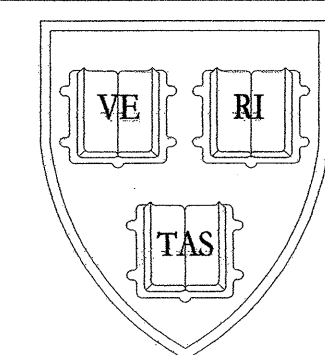

ALLIED CONSULTANTS
RICHMOND SO ENGINEERS
SCHIRMER ENGINEERING
COLLECTIVE WISDOM CORPORATION

T: 978.443.7888
T: 617.923.4800
T: 508.872.5033
T: 781.647.7732

A.R.T. BLACK BOX THEATRE AT 2-4 ARROW STREET, CAMBRIDGE MA

HARVARD REAL ESTATE SERVICES / AMERICAN REPERTORY THEATRE

MARYANN THOMPSON ARCHITECTS
14 HILLSIDE AVENUE
CAMBRIDGE, MA 02140
T: 617.481.4144
F: 617.481.2844

REVISIONS:

SET	DATE

CURRENT ISSUE:

SET	DATE
RECORD SET	04.30.05

DRAWING TITLE:

THEATER SECTIONS

A2.1