




01 WALL SECTION - EAST THEATER
SCALE: 3/4"=1'-0"

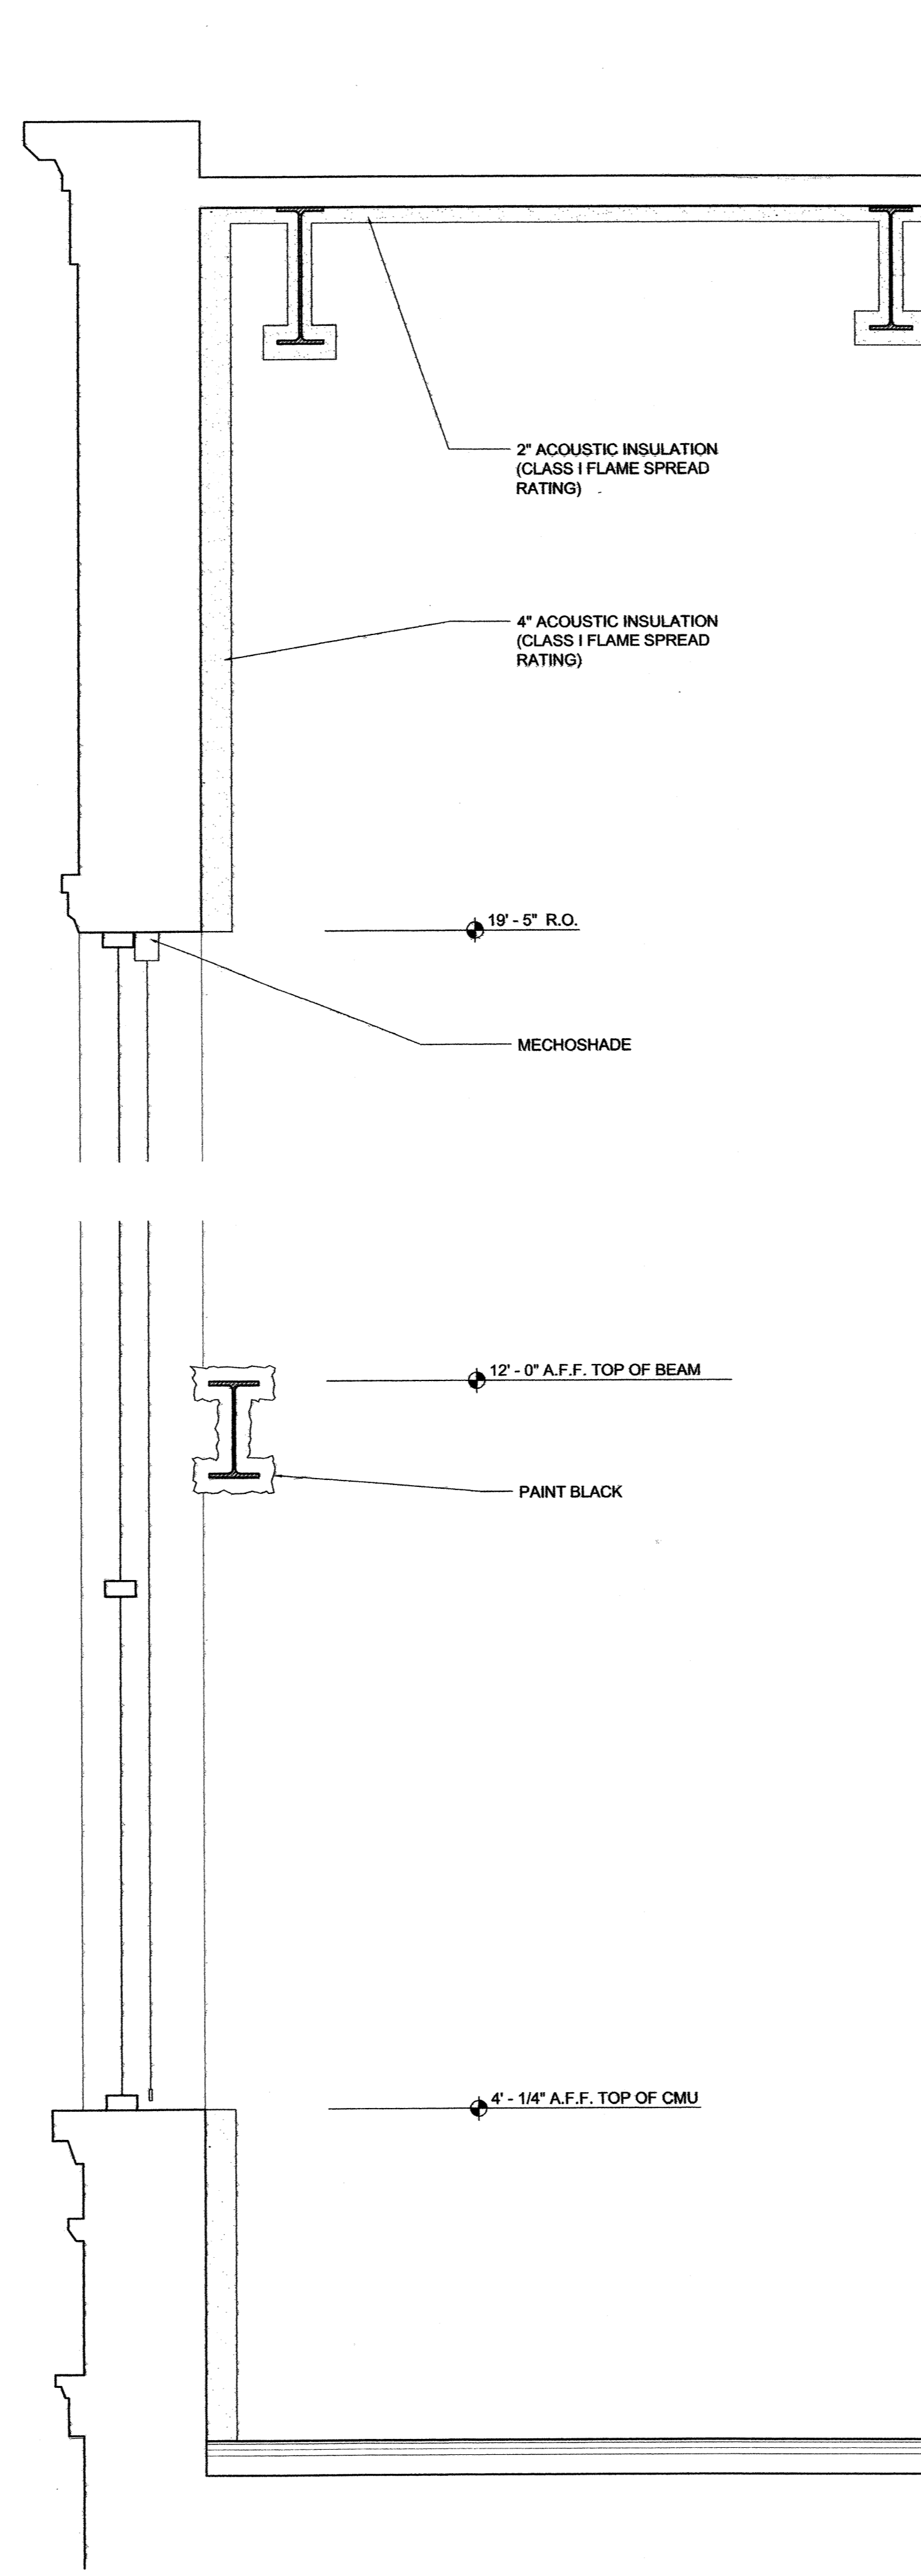

02 WALL SECTION - EAST THEATER
SCALE: 3/4"=1'-0"

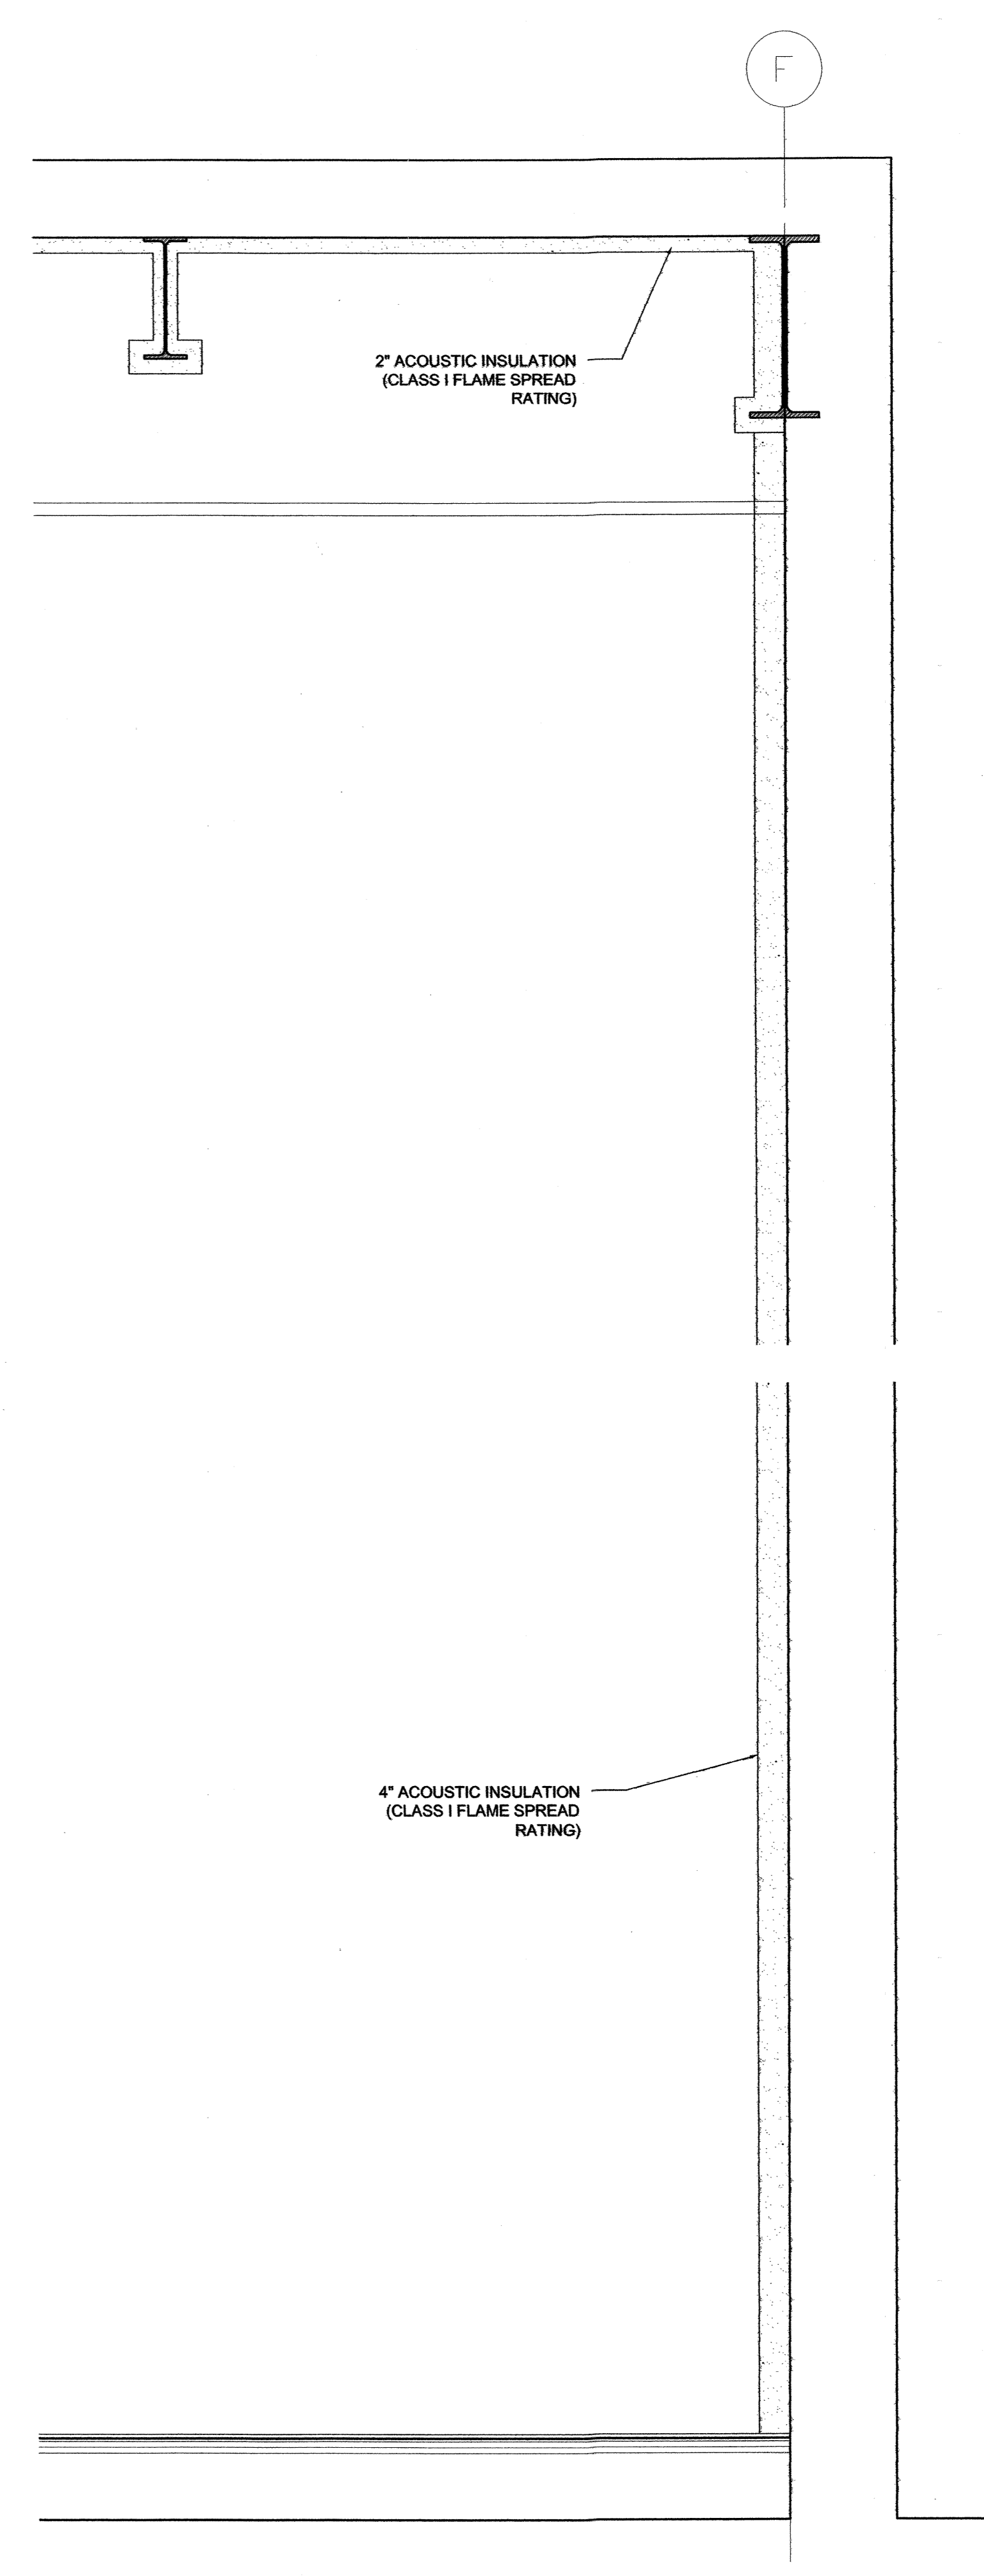

03 WALL SECTION - EAST THEATER
SCALE: 3/4"=1'-0"

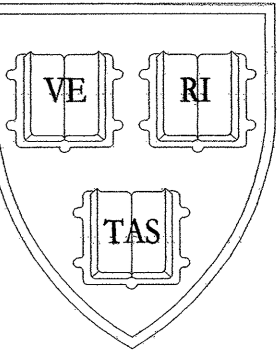

ALLED CONSULTANTS
 RICHMOND SO ENGINEERS
 SCHIRMER ENGINEERING
 COLLECTIVE WISDOM CORPORATION
 T 978.443.7888
 T 617.923.4800
 T 508.872.3033
 T 781.647.7732

A.R.T. BLACK BOX THEATRE AT 2-4 ARROW STREET, CAMBRIDGE MA
 HARVARD REAL ESTATE SERVICES / AMERICAN REPERTORY THEATRE
 MARYANN THOMPSON ARCHITECTS
 14 HILLSIDE AVENUE
 CAMBRIDGE, MA 02144
 F 617.481.3844
 © MARYANN THOMPSON ARCHITECTS

REVISIONS:	
SET	DATE

CURRENT ISSUE:	
SET	DATE
RECORD SET	04.30.05

WALL SECTIONS
A 2.3