




01 SECTION THROUGH HVAC SOFFIT
SCALE: 3/4"=1'-0"

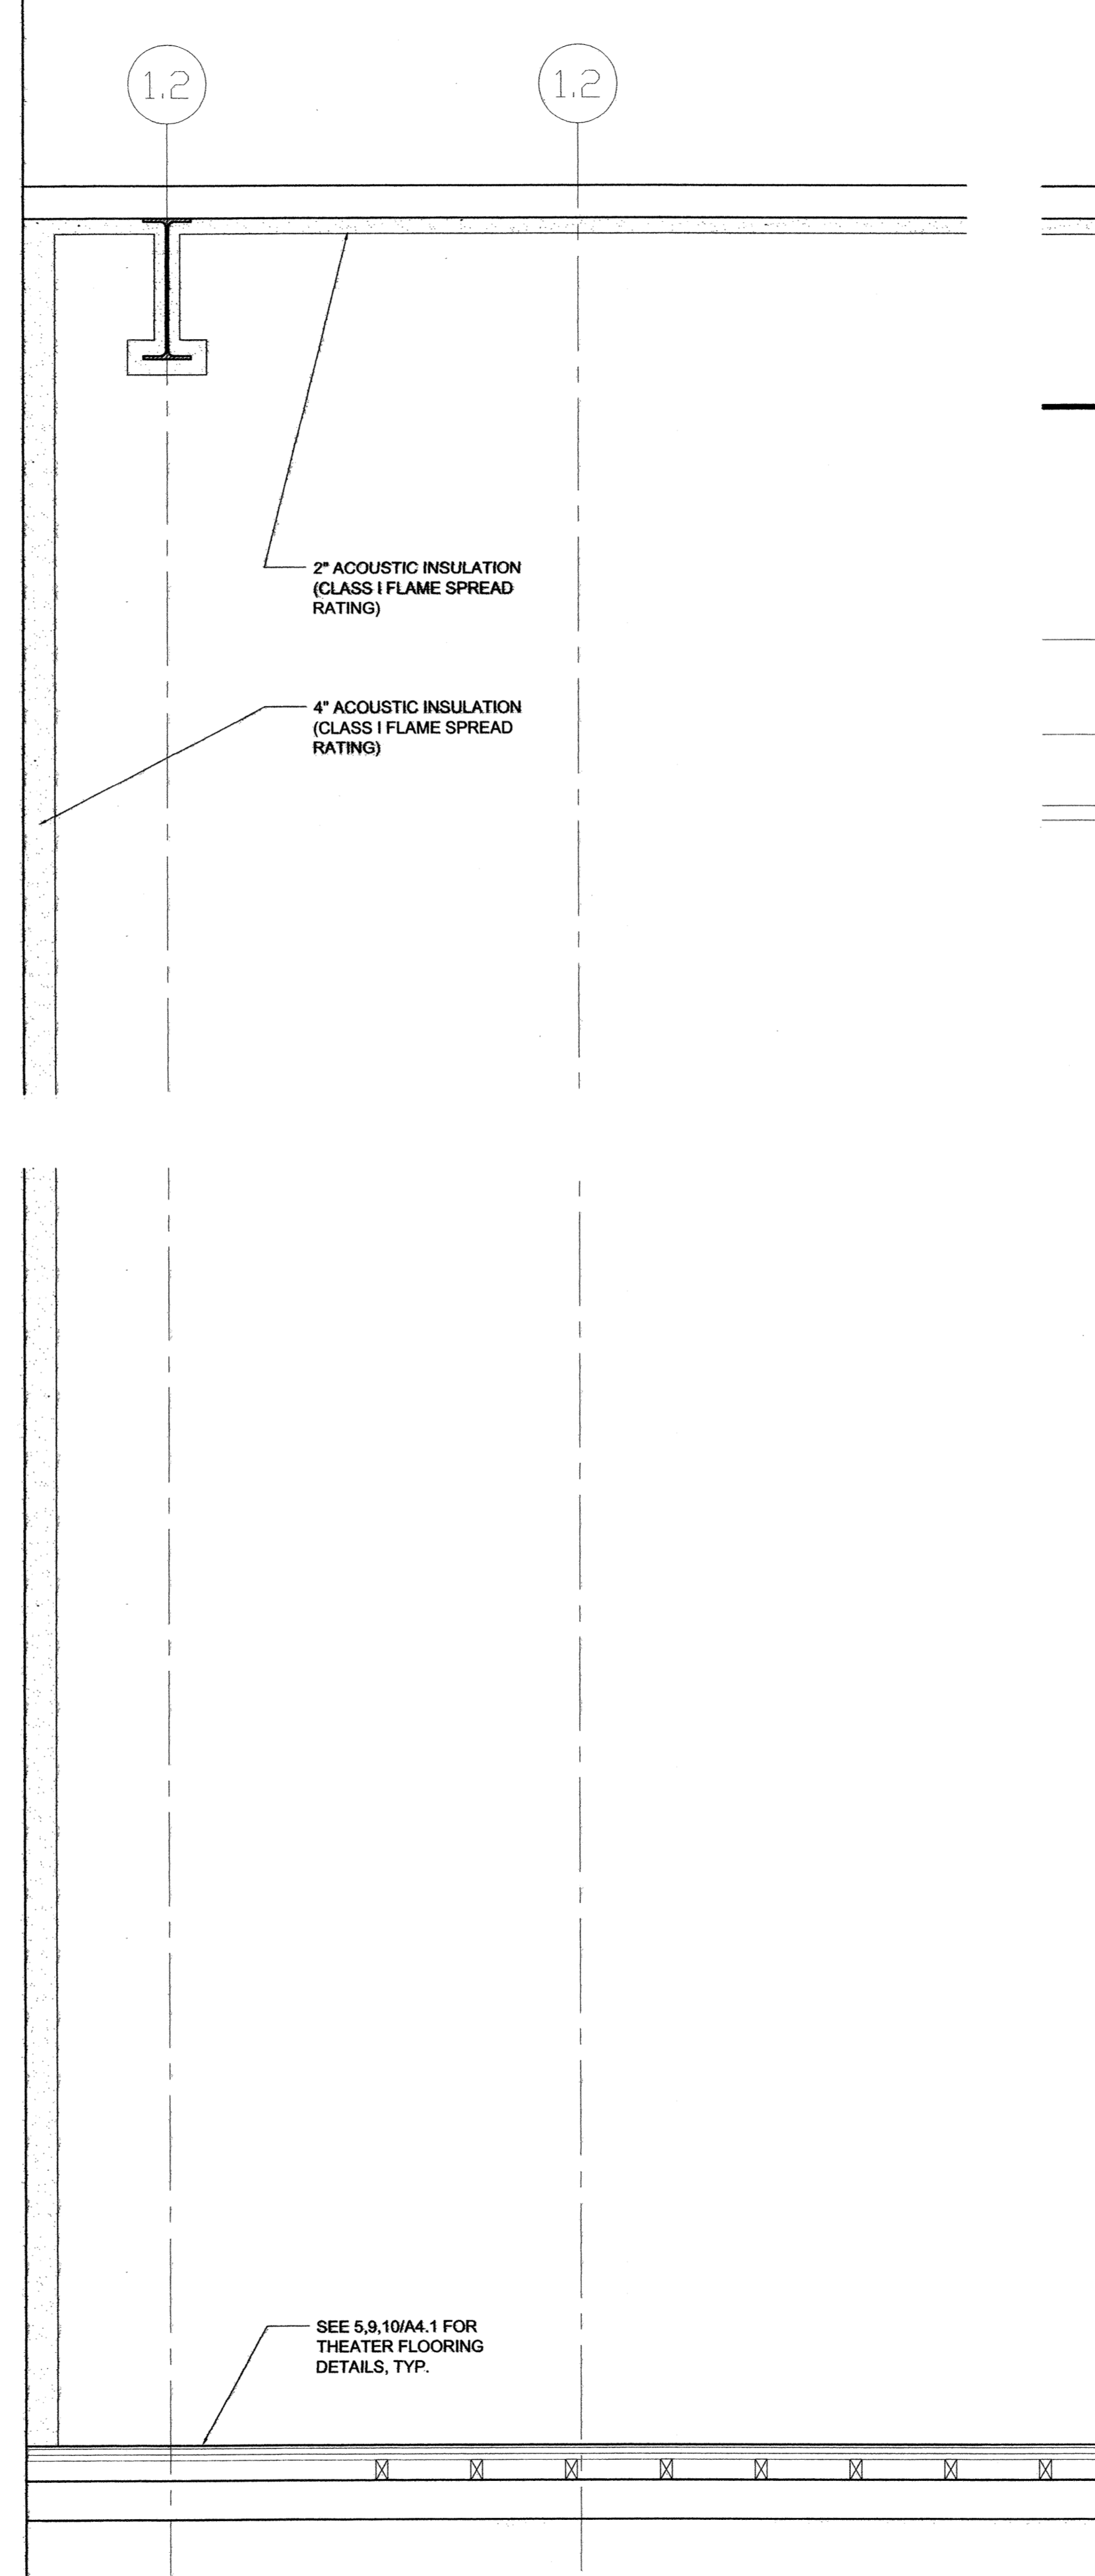


02 SECTION THROUGH WEST THEATER
SCALE: 3/4"=1'-0"

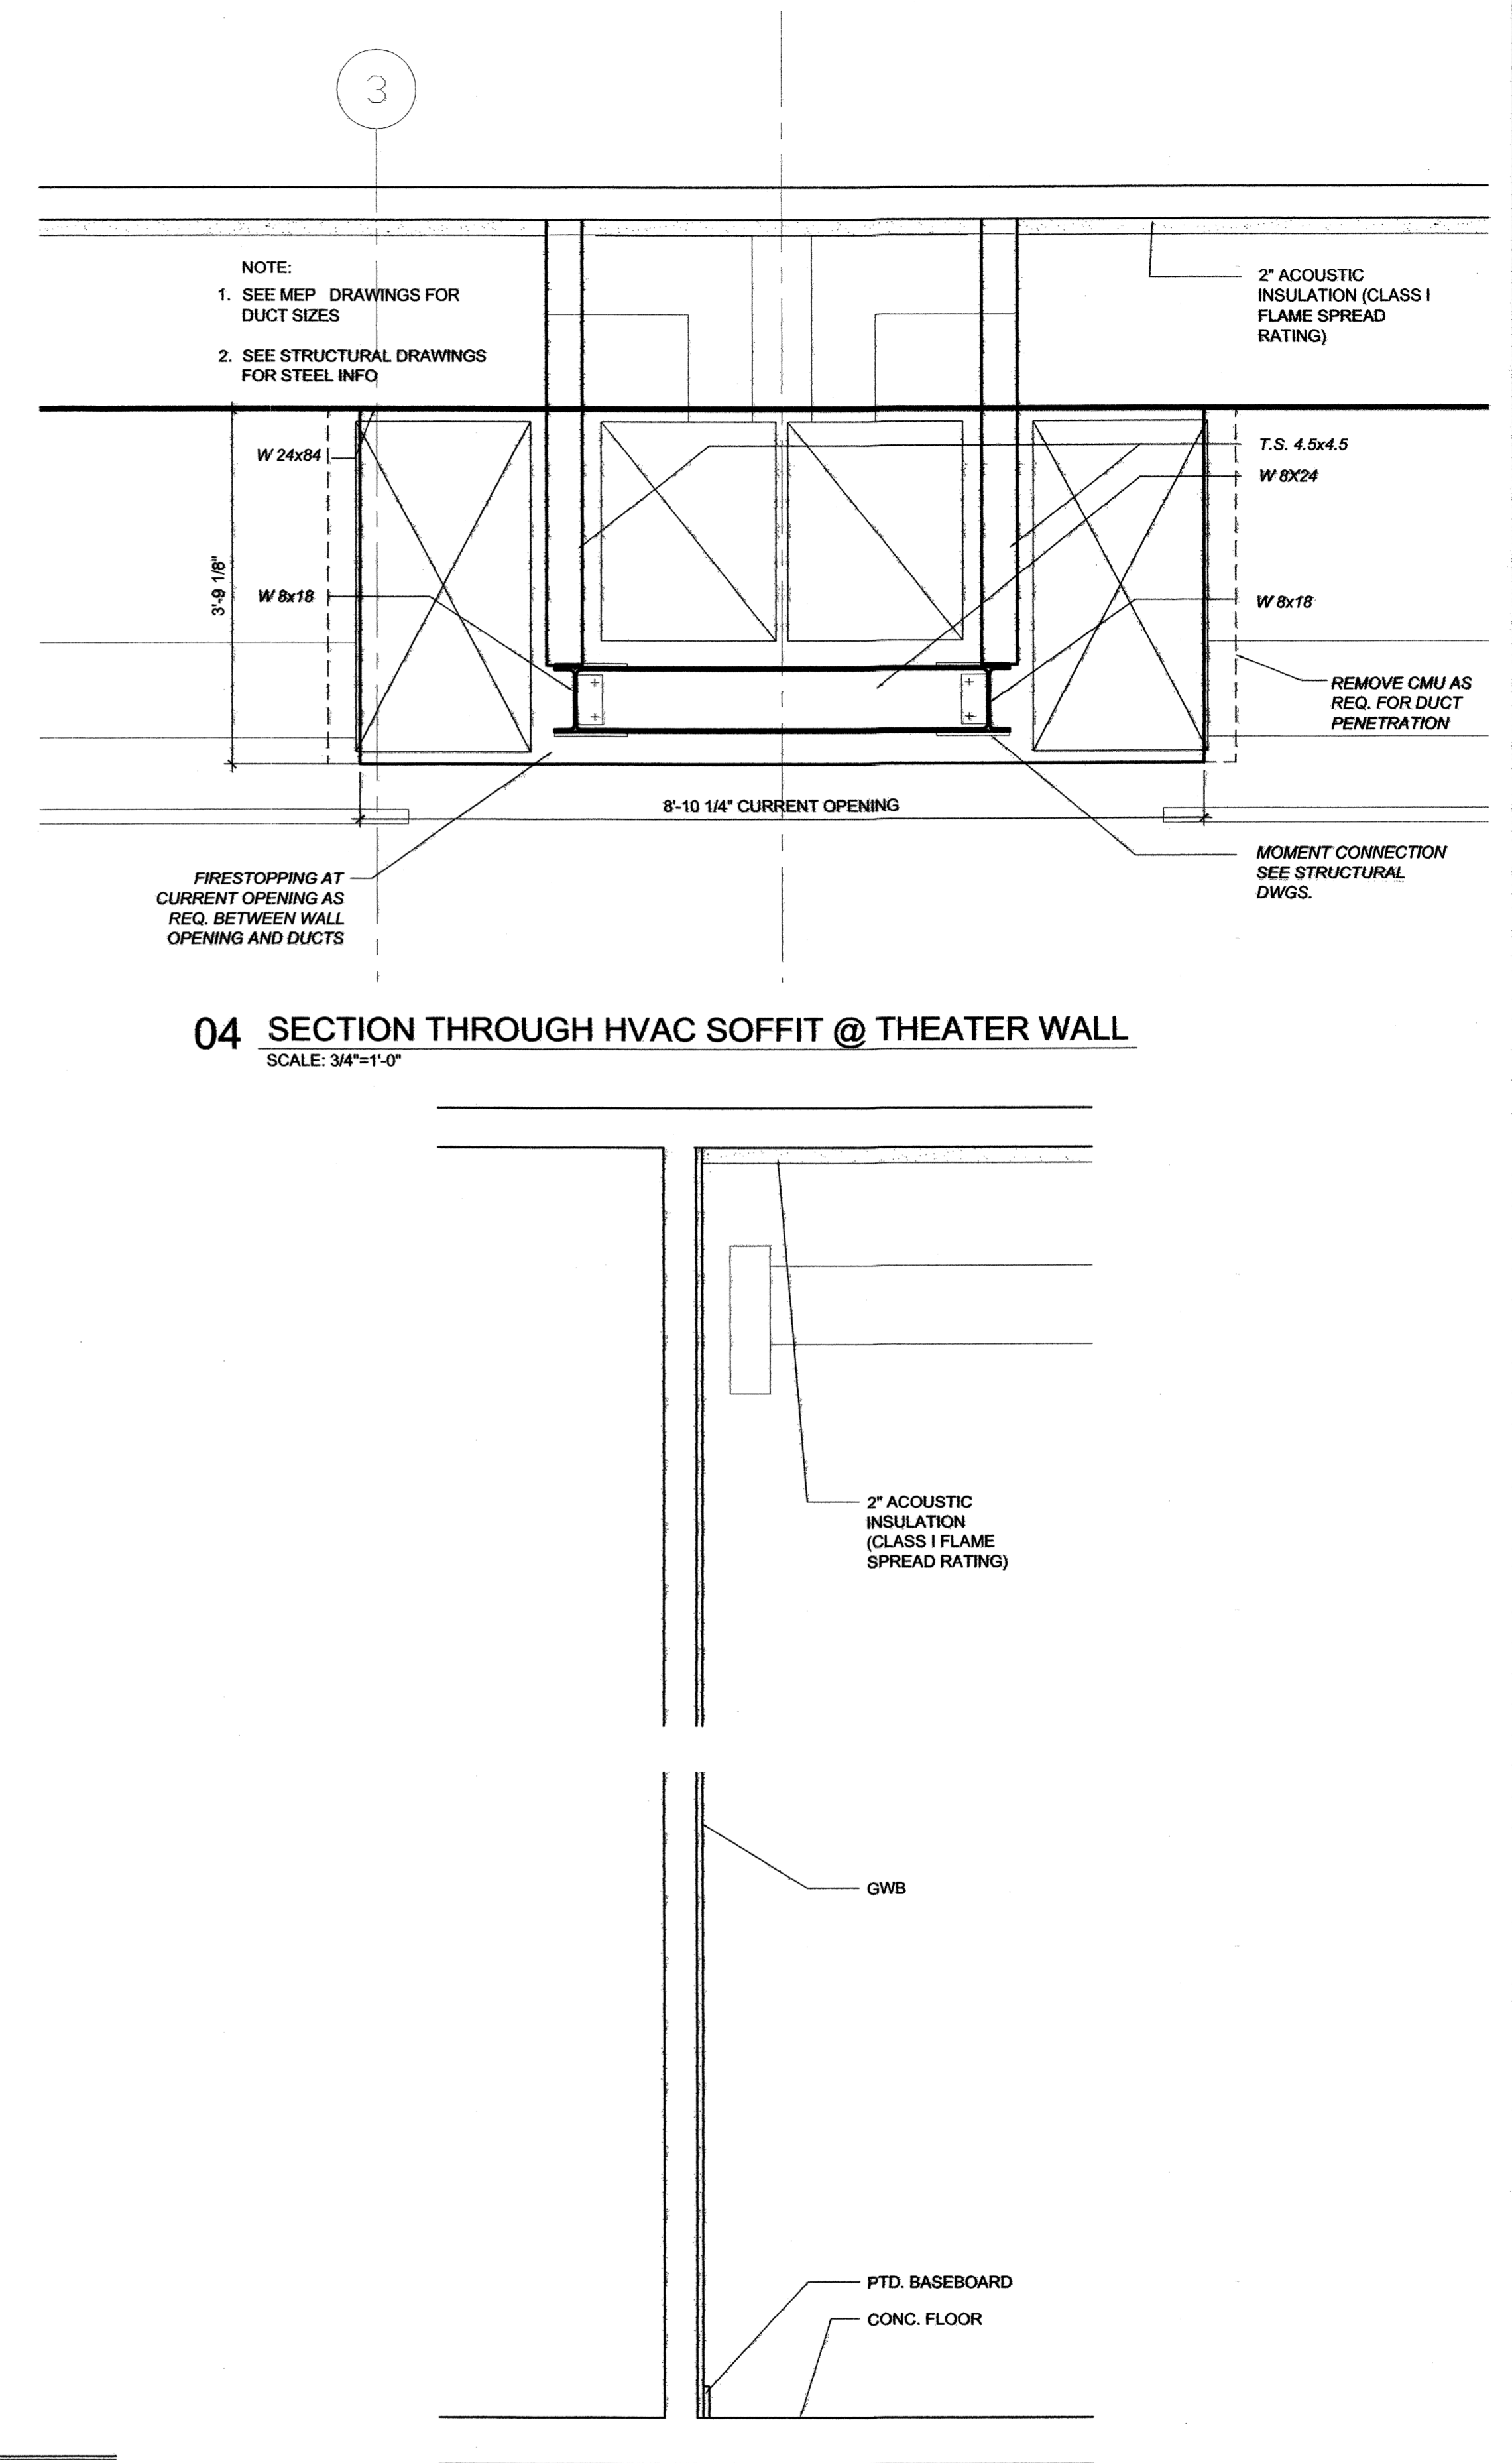

04 SECTION THROUGH HVAC SOFFIT @ THEATER WALL
SCALE: 3/4"=1'-0"

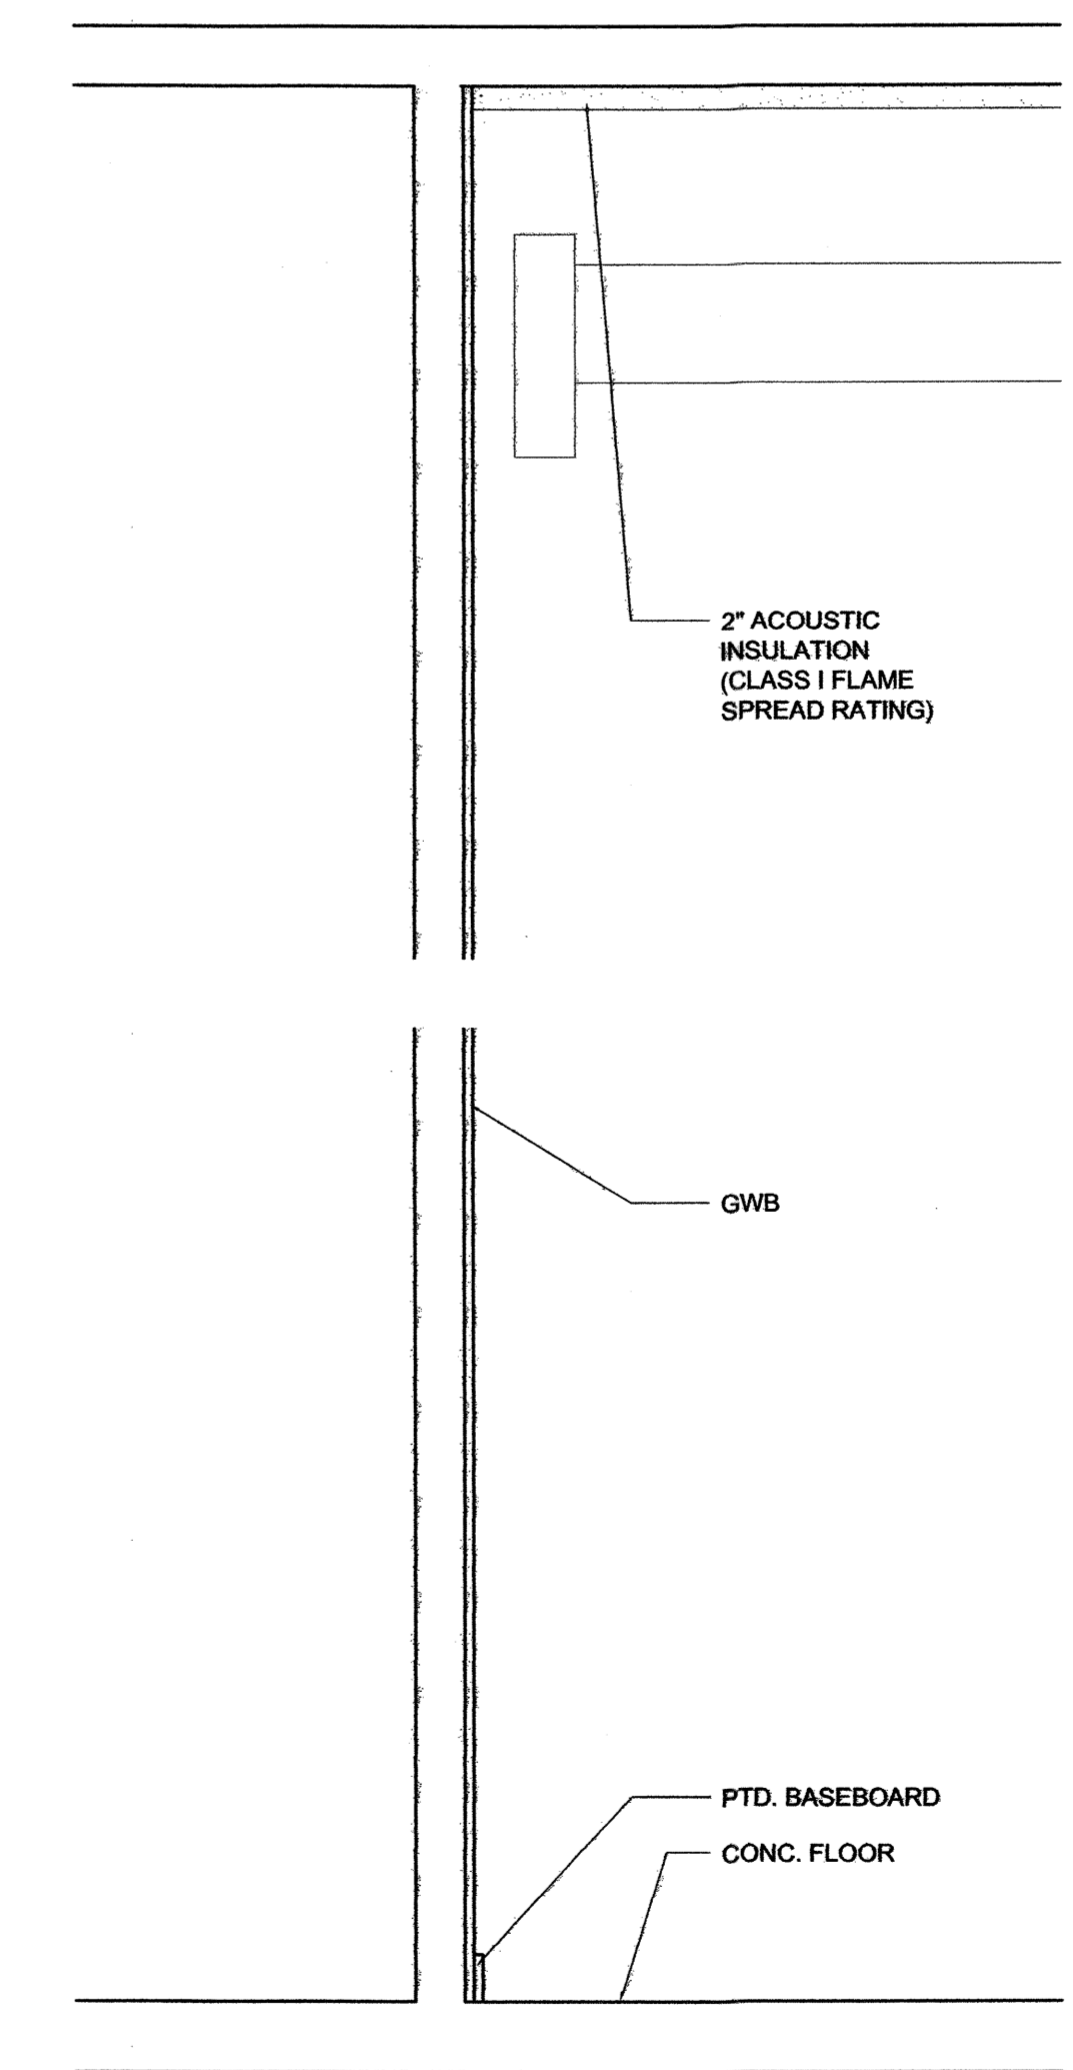

03 SECTION @ LOBBY
SCALE: 3/4"=1'-0"

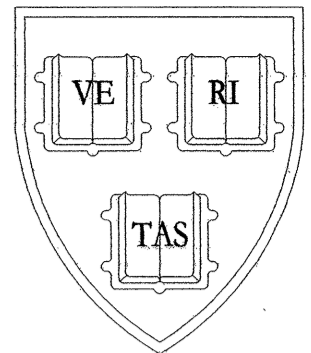

ALLIED CONSULTANTS
RICHMOND SO ENGINEERS
SCHIRMER ENGINEERING
COLLECTIVE WISDOM CORPORATION

T: 978.443.7888
T: 617.923.4800
T: 508.872.3033
T: 781.647.7732

A.R.T. BLACK BOX THEATRE AT 2-4 ARROW STREET, CAMBRIDGE MA
HARVARD REAL ESTATE SERVICES / AMERICAN REPERTORY THEATRE

MARYANN THOMPSON ARCHITECTS
14 HILLSIDE AVENUE
CAMBRIDGE, MA 02140
T. 617.491.4144
F. 617.491.3844

REVISIONS:	
SET	DATE

CURRENT ISSUE:	
SET	DATE
RECORD SET	04.30.05

DRAWING TITLE:

WALL SECTIONS
A 2.4