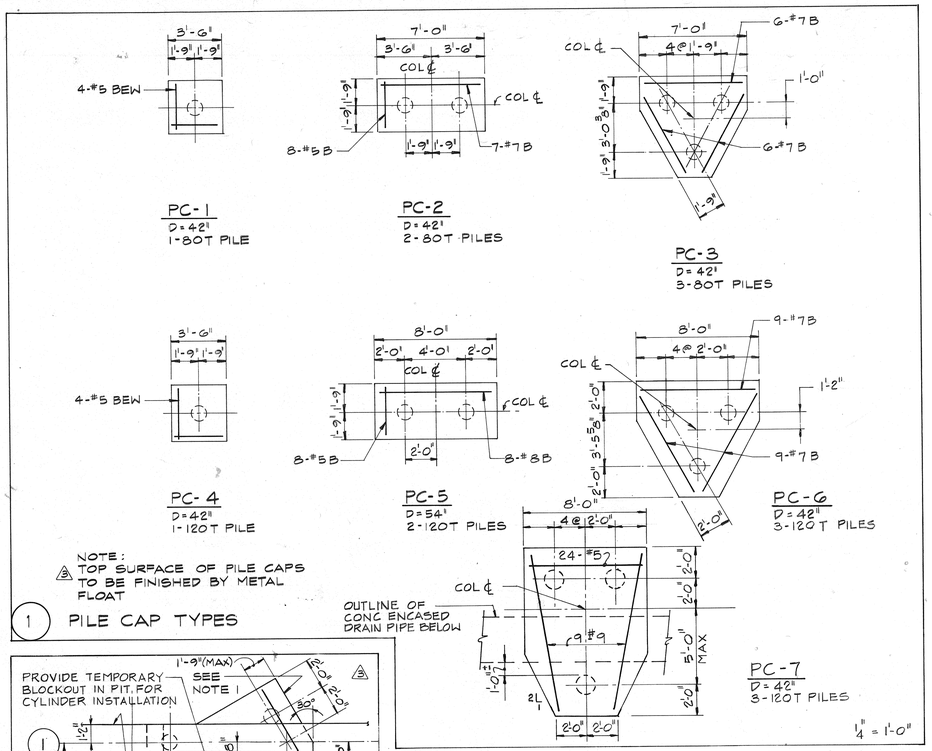

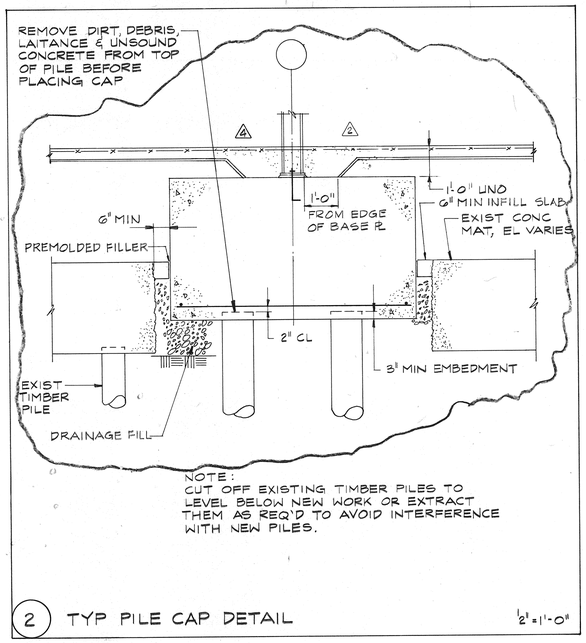

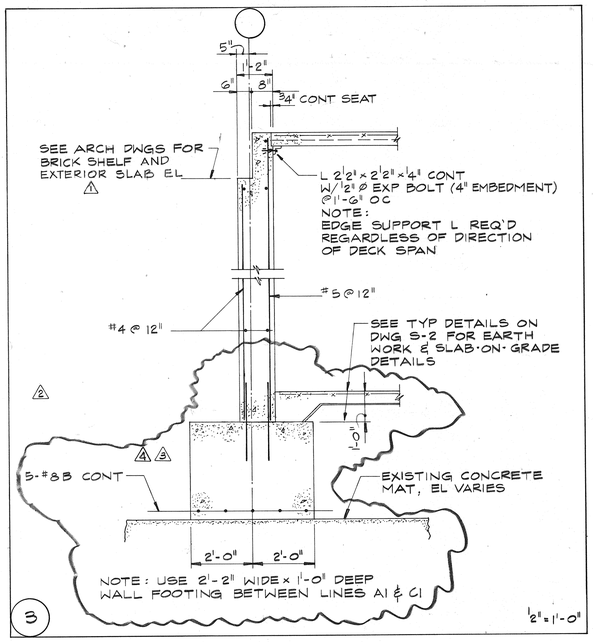

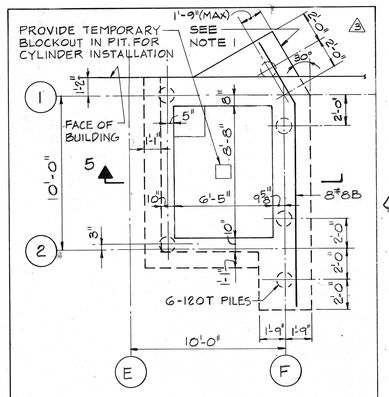

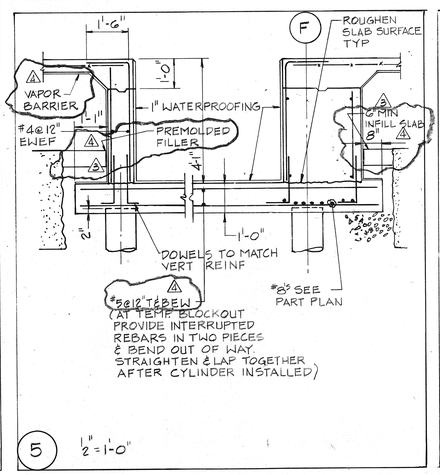

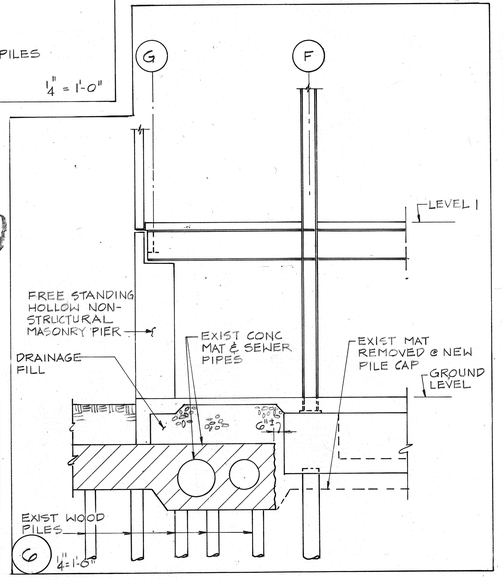

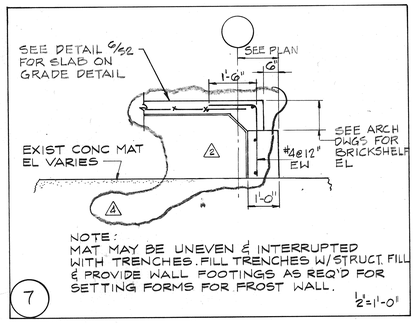

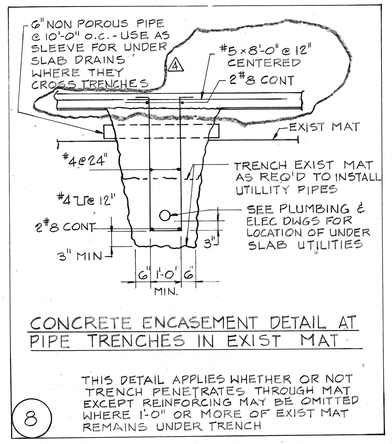

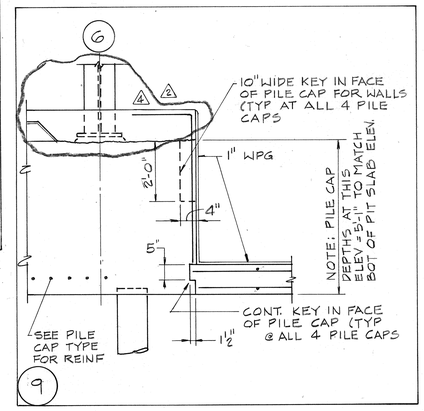

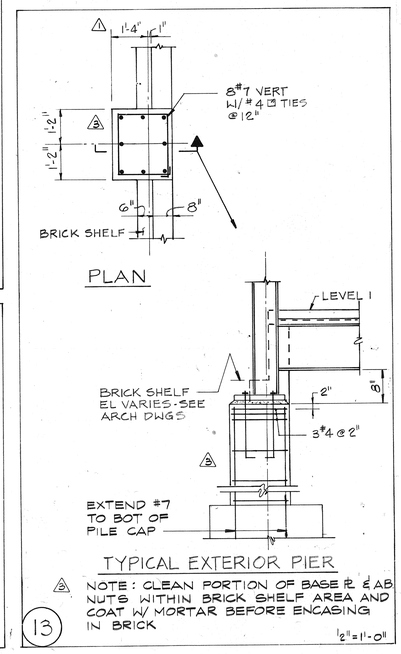

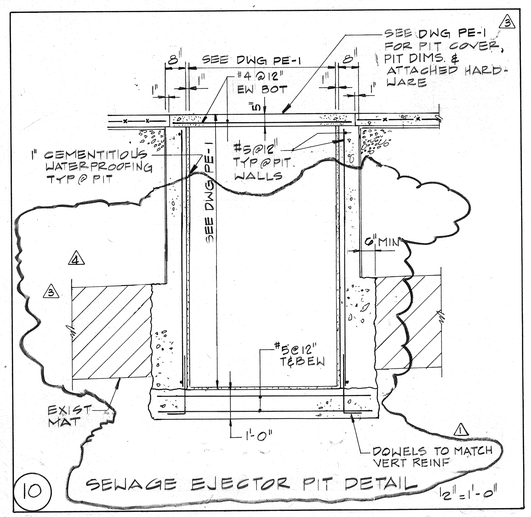

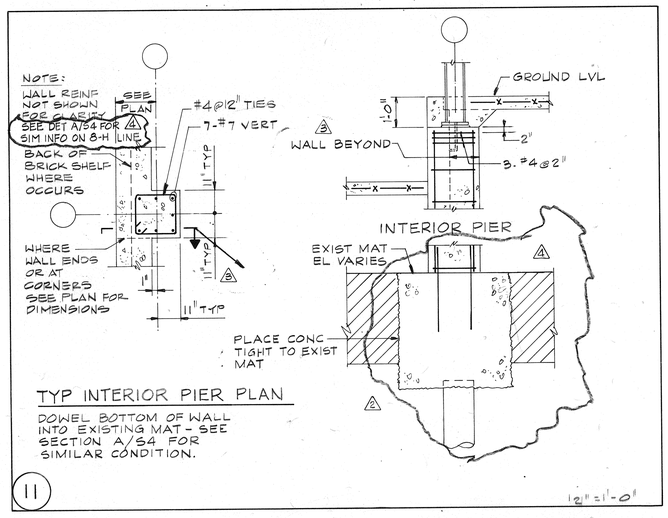

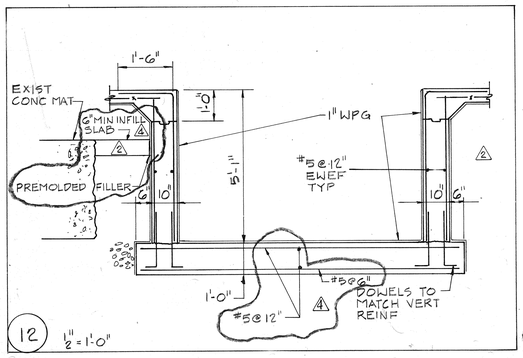

INTERNAL CONTROL
Dimen. Calc.
Dimen. Drawn
Dimen. Check
Keying Check
Coord. Review

PROGRESS PRINT RECORD

Package	Date

OVERLAY INFORMATION
Base
Overlay

JOHN F. KENNEDY SCHOOL OF GOVERNMENT
PHASE IV
HARVARD UNIVERSITY
CAMBRIDGE, MASSACHUSETTS

VE VE VE RI TAS TAS

APPROVALS

HANS WILLIAM HAGEN No 23310 REGISTERED ARCHITECT COMMONWEALTH OF MASSACHUSETTS
Registration Stamp

REVISIONS

Number	Description	Date
1	GENERAL REVISIONS	8-5-88
2	GENERAL REVISIONS	9-30-88
3	GENERAL REVISIONS	10-21-88
4	GENERAL REVISIONS	1-10-89
	REISSUED	2-10-89

FOUNDATION PACKAGE
JUNE 30,1988

ARCHITECTS
TAC /The Architects Collaborative

STRUCTURAL ENGINEERS
LeMessurier Consultants

MECHANICAL ELECTRICAL
BR+A Consulting Engineers

SECTIONS & DETAILS
DRAWING TITLE

30 JUN 88

S 13
DRAWING NUMBER

709_0118