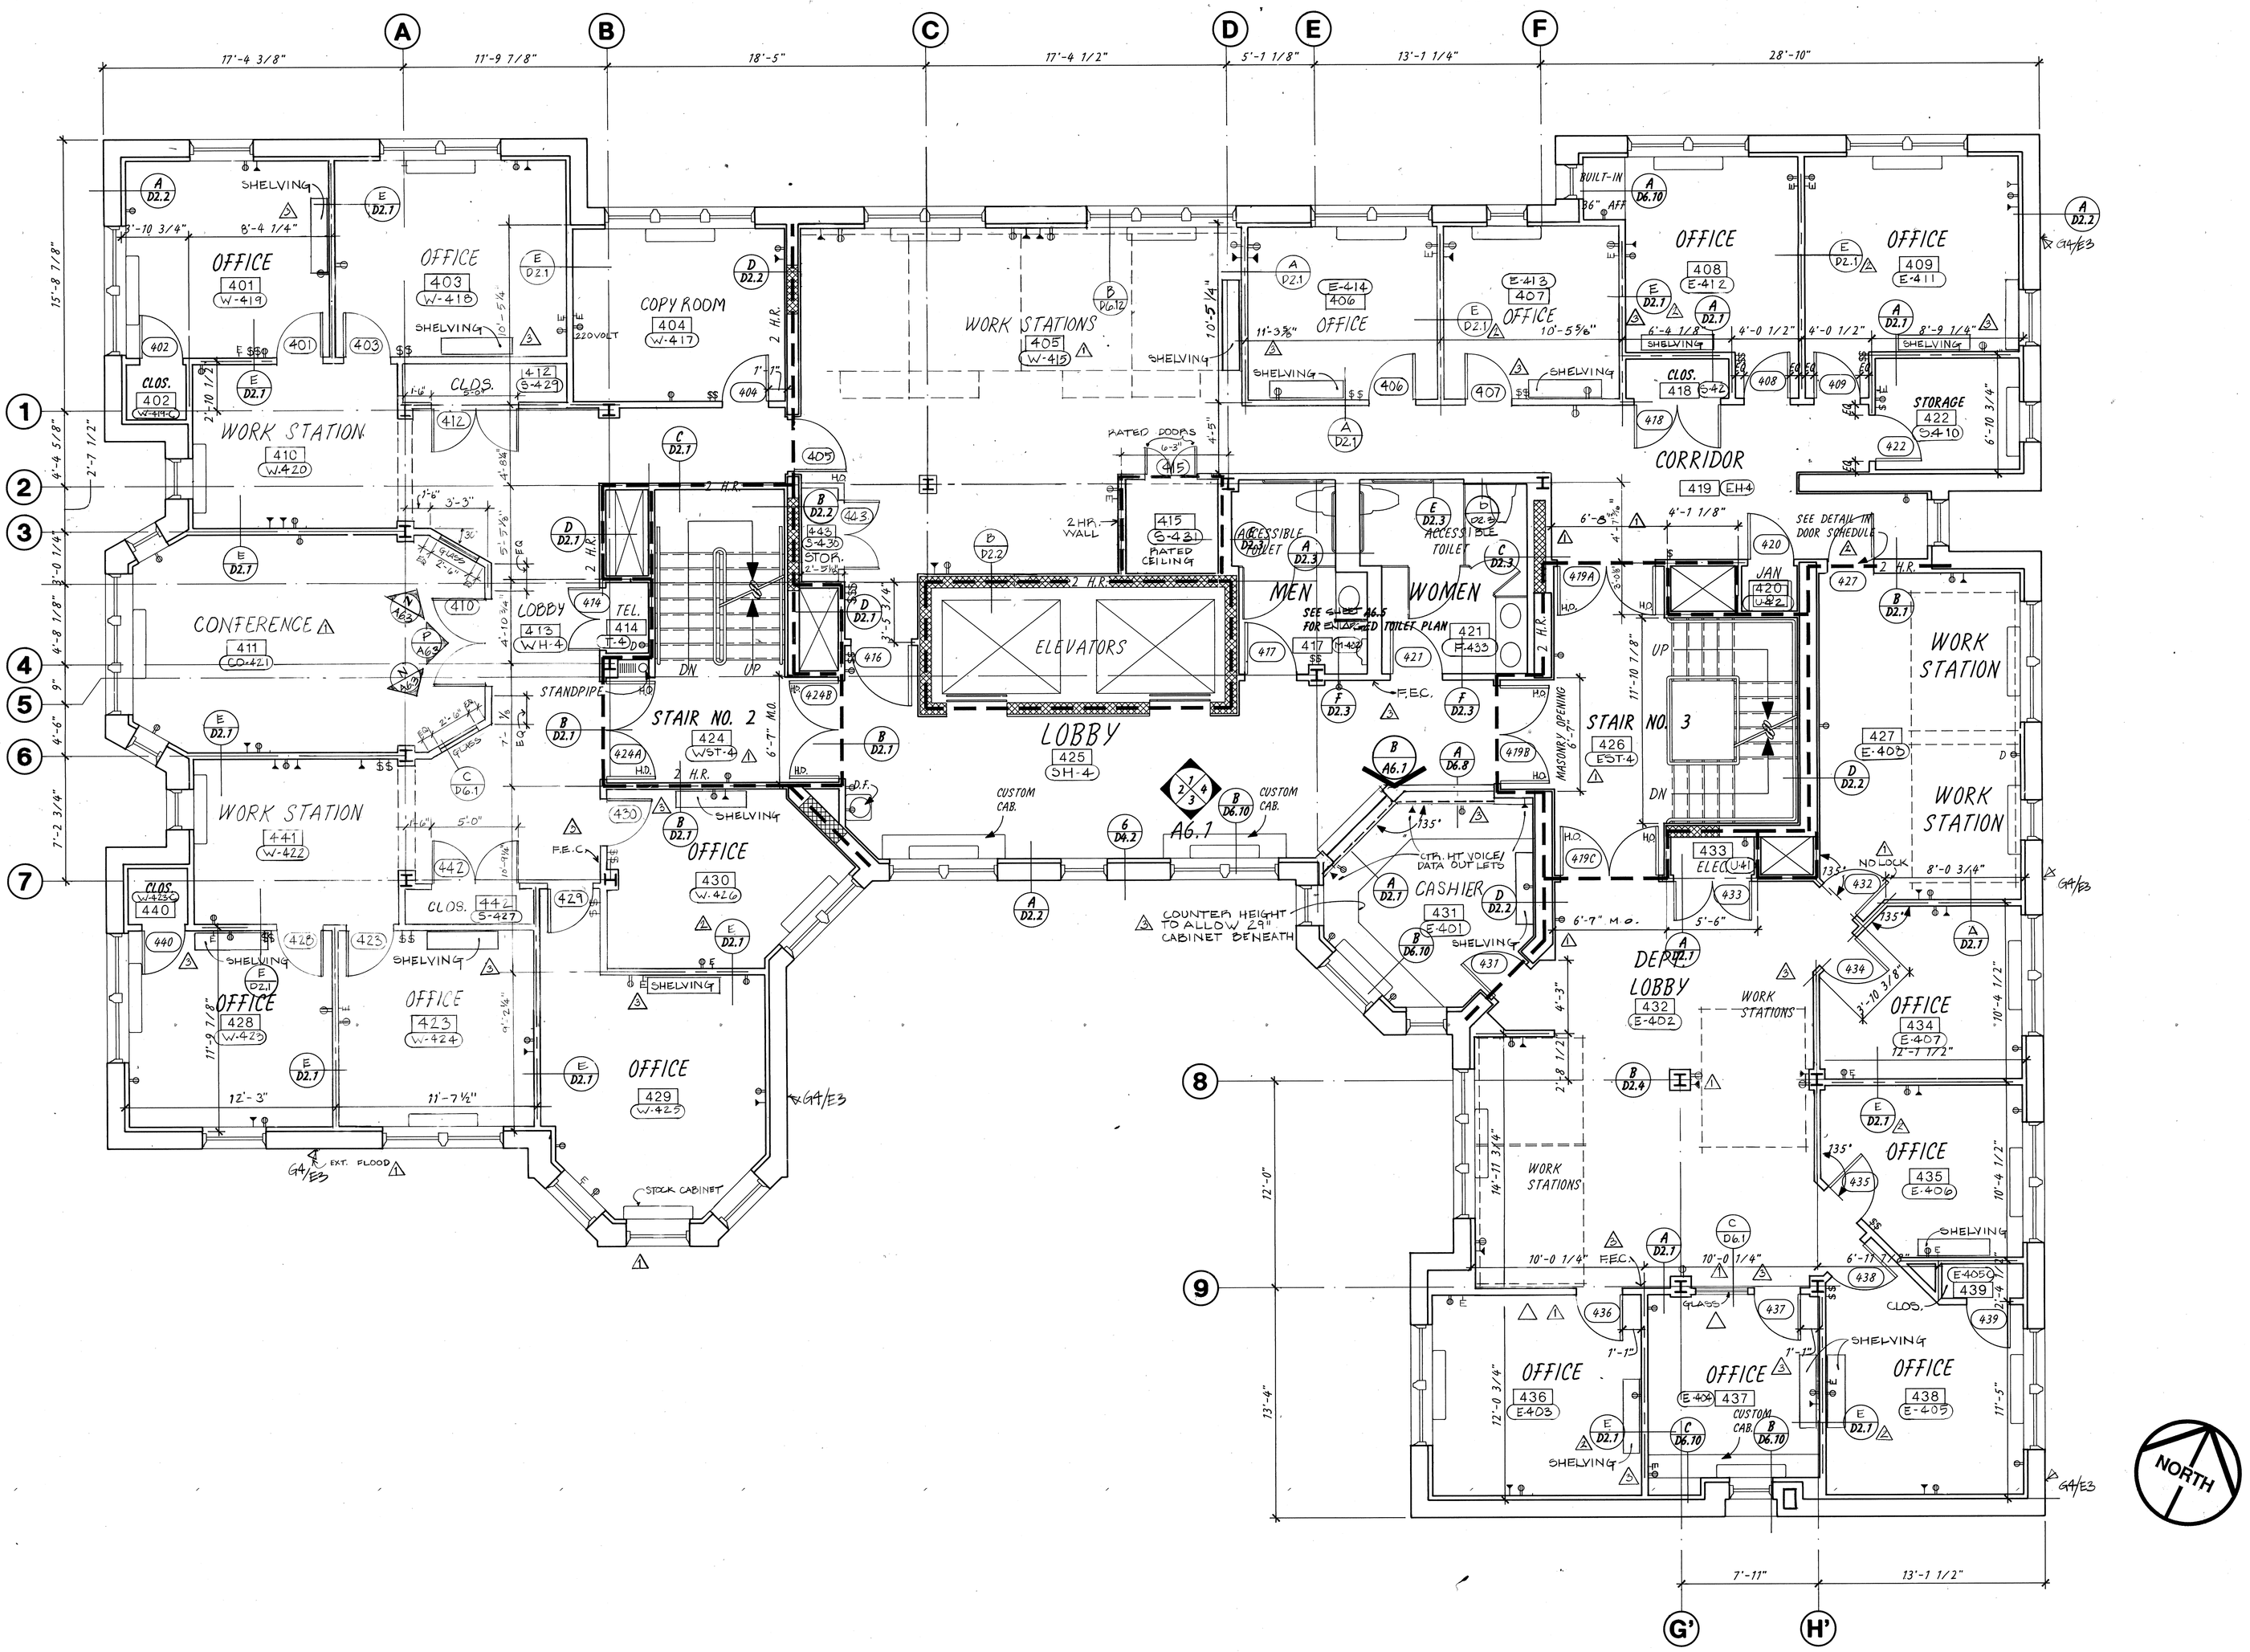

FOURTH LEVEL

HARVARD UNIVERSITY

THE DIVISION OF CONTINUING EDUCATION

BENJAMIN THOMPSON & ASSOCIATES, INC.
ARCHITECTURE, PLANNING, AND URBANISM
ONE STORY STREET
CAMBRIDGE, MA 01238
(617) 876-4300 FAX (617) 661-9213, 868-9023

Cosentini Consulting Engineers
44 Brattle Street
Cambridge, Massachusetts 02138
(617) 876-3830 FAX (617) 876-6647

LeMessurier Consultants
1033 Massachusetts Avenue
Cambridge, Massachusetts 02138
(617) 868-1200 FAX (617) 661-7520

RENOVATIONS TO 51 BRATTLE STREET

KEY:

- 2 HR. WALL
- NEW MASONRY INFILL

RECORD SET 15 FEB. 91

REVISION	DATE	DESCRIPTION
5	24APR91	ADJ. SHELVING AND MISC. REVISIONS
4	19NOV90	FIELD INSTRUCTION N°. 2
3	12NOV90	FIELD INSTRUCTION N° 1

FOURTH LEVEL PLAN

DRAWN	CHECKED	APPROVED
MWR		
SCALE 1/4"=1'-0"	DATE 17 AUG 90	JOB NO. 8912.00

A2.4

1" 1/2" 0 1" 2"

220 - 133