


NEW ENGLAND
VENTILATION
CO. INC.
"AS"-BUILT
DRAWING
DATE: 07-19-91

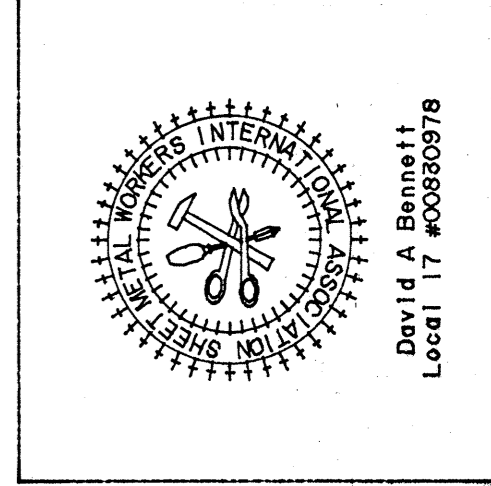

DATE	REVISION	BY	NEW ENGLAND VENTILATION CO., INC.	PROJECT
07-18-91	REV A5-BUILT	DAB	51 BRATTLE ST HARVARD UNIVERSITY (RENOVATIONS) Cambridge, Massachusetts	51 BRATTLE ST HARVARD UNIVERSITY (RENOVATIONS) Cambridge, Massachusetts
				SUBJECT
				PENTHOUSE
				DUCT PLAN
				DWG NO
				9

#220-239