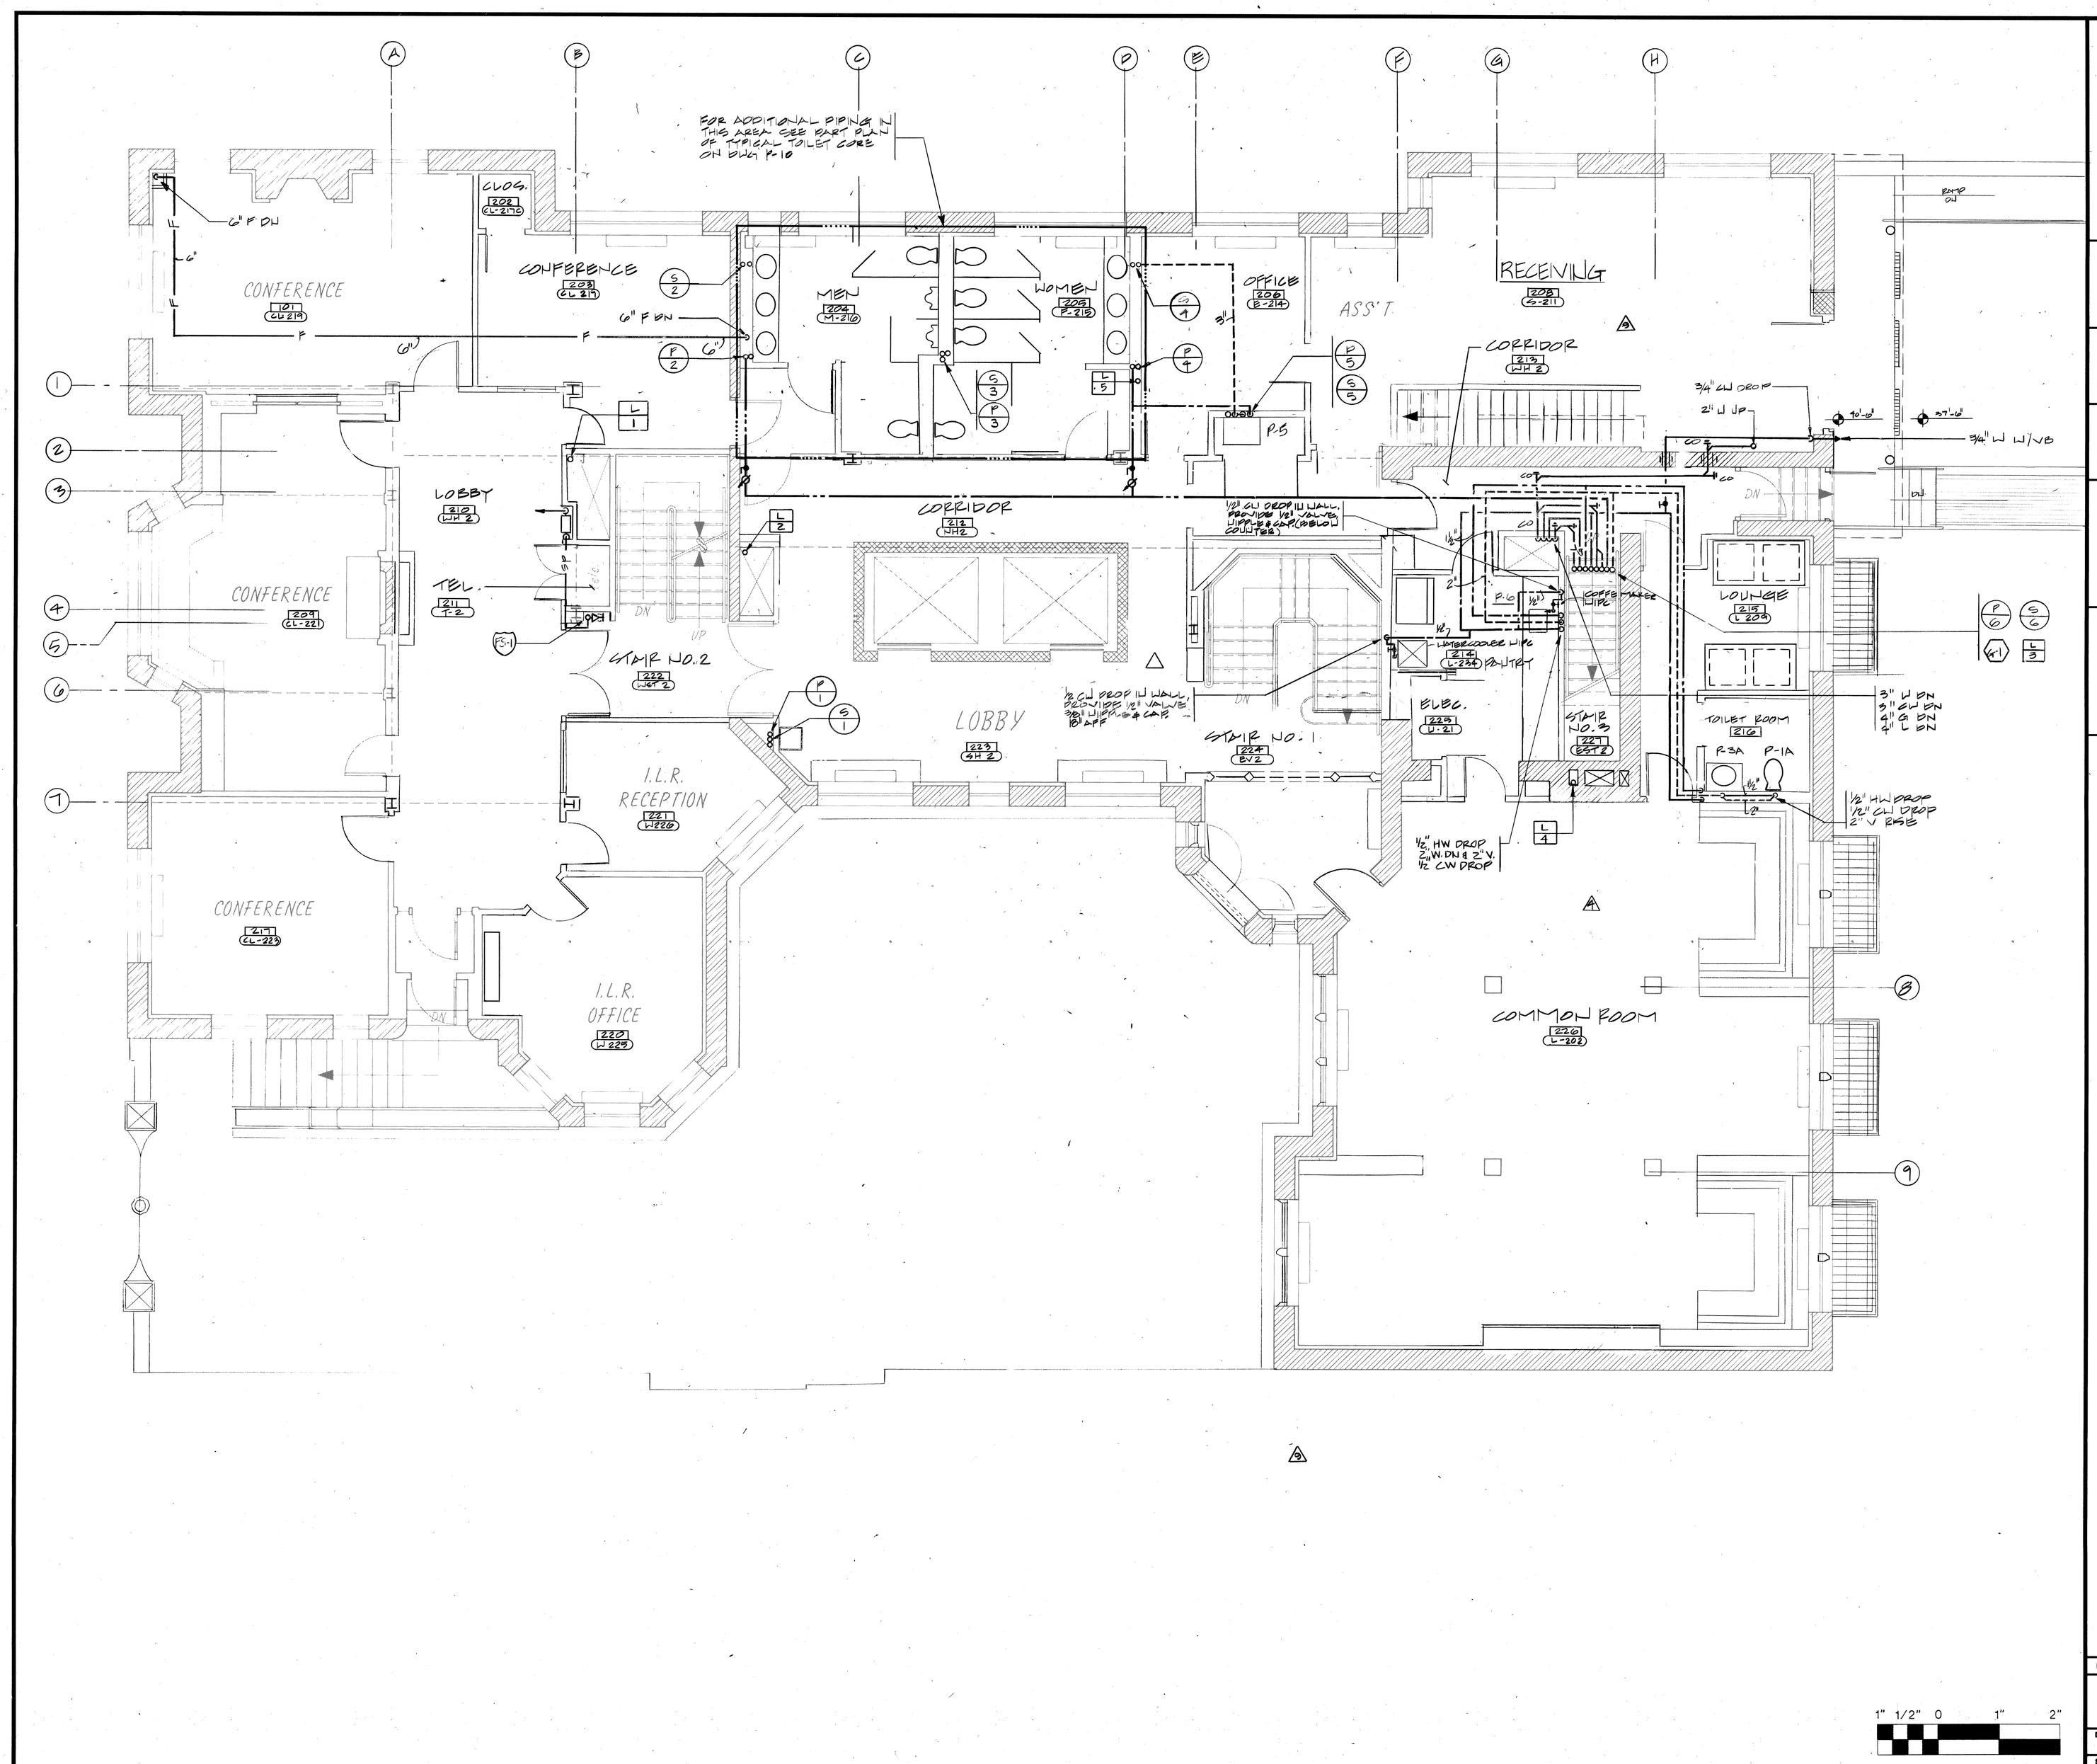

HARVARD UNIVERSITY

THE DIVISION OF CONTINUING EDUCATION

BENJAMIN THOMPSON & ASSOCIATES, INC.
ARCHITECTURE, PLANNING, AND URBANISM
ONE STORY STREET
CAMBRIDGE, MA 01238
(617) 876-4300 FAX (617) 661-9213, 868-9023

Cosentini Consulting Engineers
44 Brattle Street
Cambridge, Massachusetts 02138
(617) 876-3830 FAX (617) 876-6647

LeMessurier Consultants
1033 Massachusetts Avenue
Cambridge, Massachusetts 02138
(617) 868-1200 FAX (617) 661-7520

RENOVATIONS TO 51 BRATTLE STREET

RECORD SET 15 SEPT. 1992

21 4-10-91 ROOM NAME & NUMBER REVISIONS

5

4 12-4-90 DCE REVISIONS
10.24.10 COORDINATION REVISIONS

REVISION	DATE	DESCRIPTION

SECOND LEVEL PLAN

DRAWN	CHECKED	APPROVED
BM	JAP	[illegible]
SCALE	DATE	JOB NO.
[illegible]	8/15/90	8701

21 P-3

220-170172