WALSH BROTHERS INC.
REVIEWED FOR CONTRACT REQUIREMENTS
SPEC. SECTION 5100
FILE # B.11
SUB. # 2
SUBCONTRACTOR Novel
DATE 10/2/90
BY D.C.

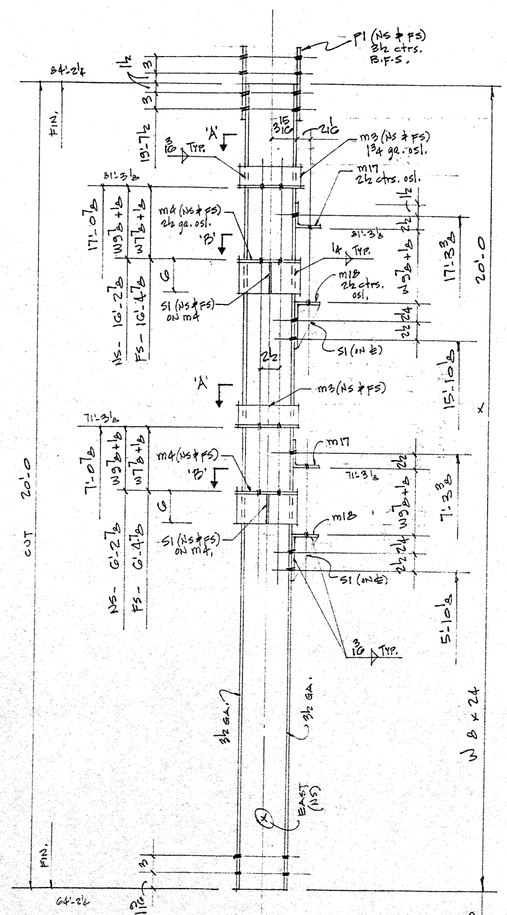

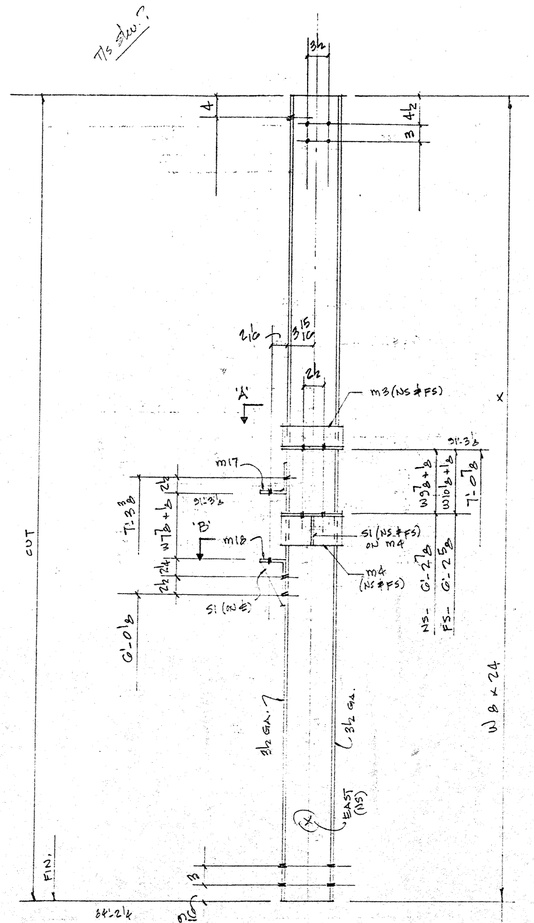

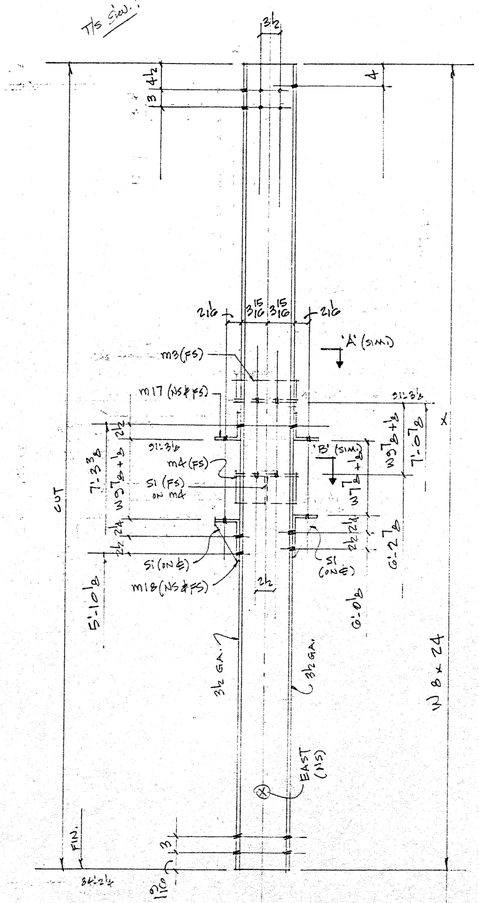

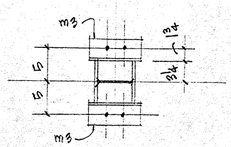

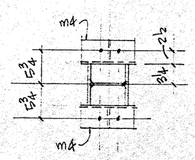

SHOP NOTES - SEE SHEET 1

BILL OF MATERIAL

NO. OF PCS	SHIP MARK	PIECE MARK	DESCRIPTION	LENGTH	REMARKS	WEIGHT
1	H19-B		W 8 x 24	20 0	FIE (L-G)	
2		P1	PL G½ x ½	1 0		
4		m3	L 3 x 3 x ¼	9		
4		m4	L 6 x 4 x ⅜	9		
2		m17	L 4 x 3½ x ¼	6		
2		m18	L 6 x 4 x ⅜	6		
6		S1	PL 3⅜ x ⅜	5⅜	FITTED	
1	A1-C		W 8 x 24		FIE (G-R)	
2		m3				
2		m4				
1		m17				
1		m18				
3		S1				
1	A3-C		W 8 x 24		FIE (G-R)	
1		m3				
1		m4				
2		m17				
2		m18				
3		S1				

FINAL APPROVAL
DATE SEP 21 1990
FOR FABRICATION
SEP 21 1990
FOR ERECTION
AUG 31 1990

3-17-30

REVISIONS			PRINT RECORD		
NO.	DATE	DESCRIPTION	DATE	QTY.	ISSUED

NOVEL IRON WORKS
OCEAN ROAD
GREENLAND, N.H. 03840

PAINT: None	HOLES U.N. 13/16 ø	WELD U.N. E70XX	AISC CERTIFIED CATEGORY II
PROJECT: HARVARD UNIV, RENOV, 51 BRATTLE ST. CAMBRIDGE, MASS.			DATE: 7-30
			DRAWN BY: RGD
DESCRIPTION: Cols.			CHK'D BY: V
ARCH.	ENG.		JOB NO.: 130
CUSTOMER: WALSH BROS.			SHT. NO.: 11

MAKEPEACE

220-1186V