WALSH BROTHERS INC.
REVIEWED FOR CONTRACT REQUIREMENTS
SPEC. SECTION 5100
FILE # 8.13
SUB. # 2
SUBCONTRACTOR Novel
DATE 10/2/96
BY J.C.

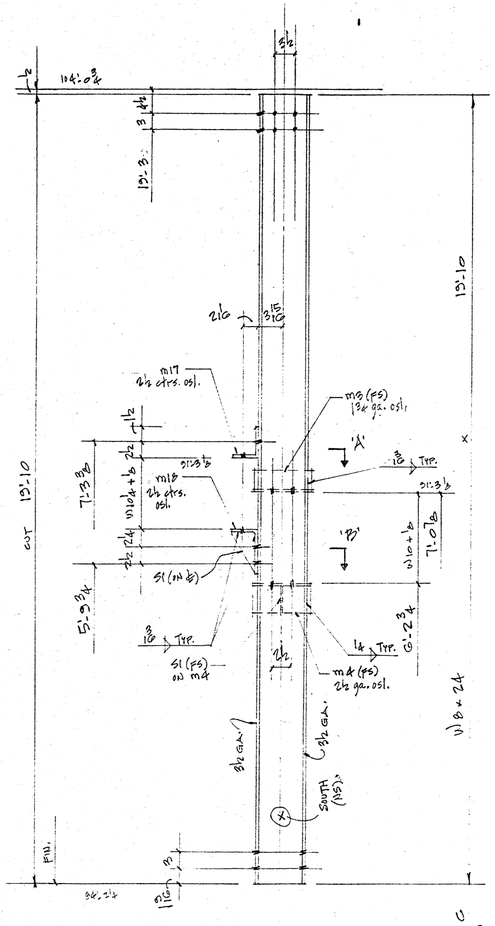

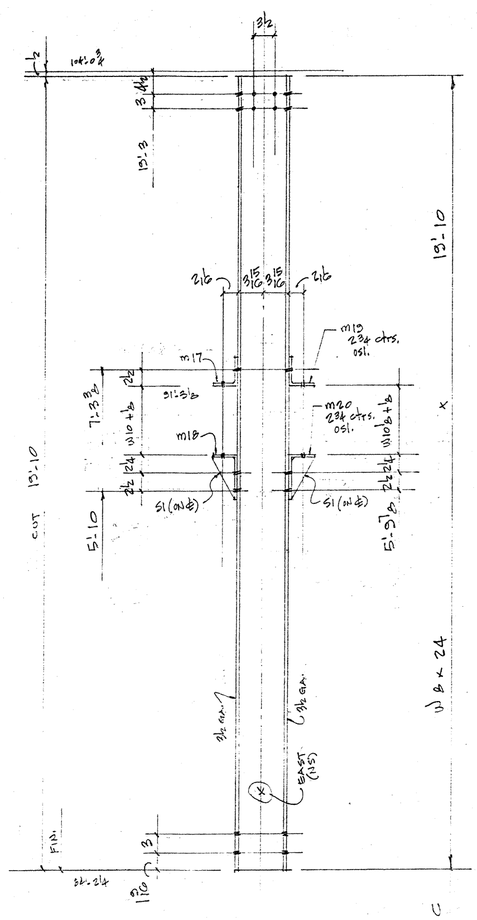

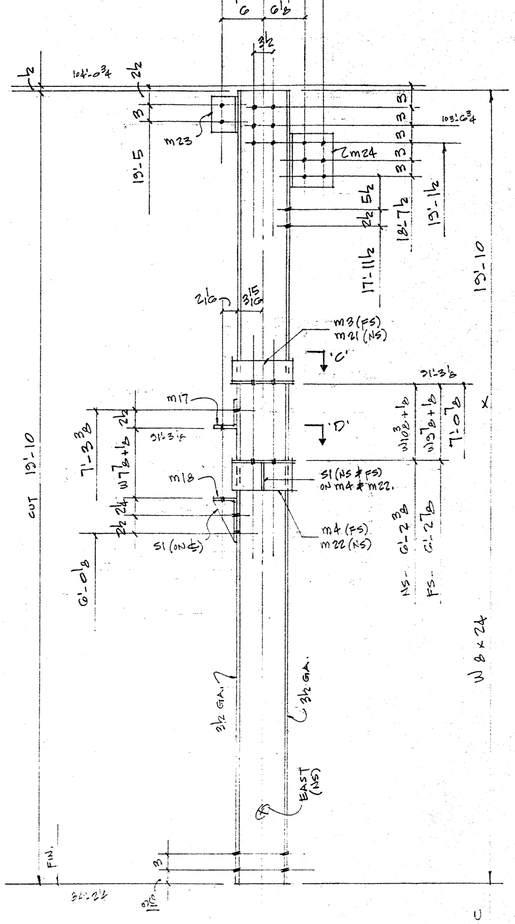

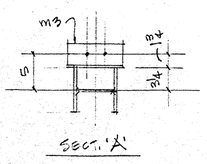

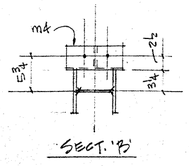

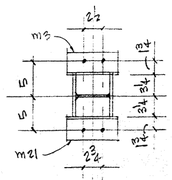

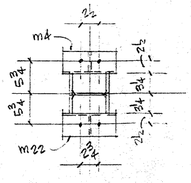

SHOP NOTES - SEE SHEET 1

BILL OF MATERIAL

NO. OF PCS	SHIP MARK	PIECE MARK	DESCRIPTION	LENGTH	REMARKS	WEIGHT
1	B7-C		W 8 x 24	13' 10	FIE (G-R)	
1		m3	L 3 x 3 x 5/16	3		
1		m4	L 6 x 4 x 3/8	3		
1		m17	L 4 x 3 1/2 x 5/16	6		
1		m18	L 6 x 4 x 3/8	6		
2		S1	PL 3 5/8 x 3/8	5 5/8	FITTED	
1	B4-C		W 8 x 24	13 10	FIE (G-R)	
1		m17				
1		m18				
1		m13	L 4 x 3 1/2 x 5/16	6		
1		m20	L 6 x 4 x 3/8	6		
2		S1				
1	C2-C		W 8 x 24	13 10	FIE (G-R)	
1		m3				
1		m4				
1		m21	L 3 x 3 x 5/16	3		
1		m22	L 6 x 4 x 3/8	3		
1		m17				
1		m18				
3		S1				
1		m23	L 4 x 4 x 3/8	6		
1		m24	L 6 x 6 x 1/2	3		

FINAL APPROVAL
DATE SEP 21 1996
FOR FABRICATION
SEP 19 1996

3547-30

REVISIONS			PRINT RECORD		
NO.	DATE	DESCRIPTION	DATE	QTY.	ISSUED

NOVEL IRON WORKS
OCEAN ROAD
GREENLAND, N.H. 03840

PAINT None	HOLES U.N. 1 1/16 ø	WELD U.N. E70XX	AISC CERTIFIED CATEGORY II
PROJECT HARVARD UNIV. RENOV. 51 BRATTLE ST. CAMBRIDGE, MASS.			DATE 7-30
			DRAWN BY RCD
DESCRIPTION Cols.			CHK'D BY C
ARCH.	ENG.		JOB NO. 130
CUSTOMER WALSH BROS.			SHT. NO. 13

220 - 1198