


FOURTH FLOOR FRAMING PLAN
 TOP OF STEEL EL. 611.3 U.N.
 SEE DWG. E1 FOR SECTS. & BRG. # DETAILS.

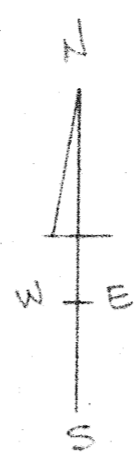

ERECTOR NOTE!
 BACK CHARGES FOR REPAIRS
 OR ALTERATIONS TO OUR
 WORK WILL NOT BE ACCEPTED
 UNLESS APPROVED BY
 NOVEL IRON WORKS, INC.

NOVEL IRON WORKS, INC.
 REVIEWED FOR CONTRACT
 REQUIREMENTS
 SPEC. SECTION 5100
 FILE NO. 7
 SHEET NO. 2
 SUBMITTED Nov 22
 DATE 10/24/06
 BY DC

FINAL APPROVAL
 DATE

FOR ERECTION
 DATE

FIELD CONNS. 3/4\"/>

REVISIONS		PRINT RECORD			
NO.	DATE	DESCRIPTION	DATE	QTY.	ISSUED

		NOVEL IRON WORKS	
		OCEAN ROAD GREENLAND, N.H. 03840	
PAINT	MOLES U.N. 1/6\"/>	WELD U.N. E70XX	DATE 7-00
PROJECT	HARVARD UNIV. RENOVATIONS 51 BRATTLE ST. CAMBRIDGE, MASS.		DRAWN BY EGD
DESCRIPTION	4TH FLOOR FRAMING PLAN		CHK'D BY ✓
ARCH. P. THOMPSON & ASSOC.	ENG. LE NESSURIER	JOB NO. 130	DATE 10-5-00
CUSTOMER WALSH PROS.		SHT. NO. E3	

10-5-00
 2-17-00

Handwritten notes and signatures at the bottom right corner.