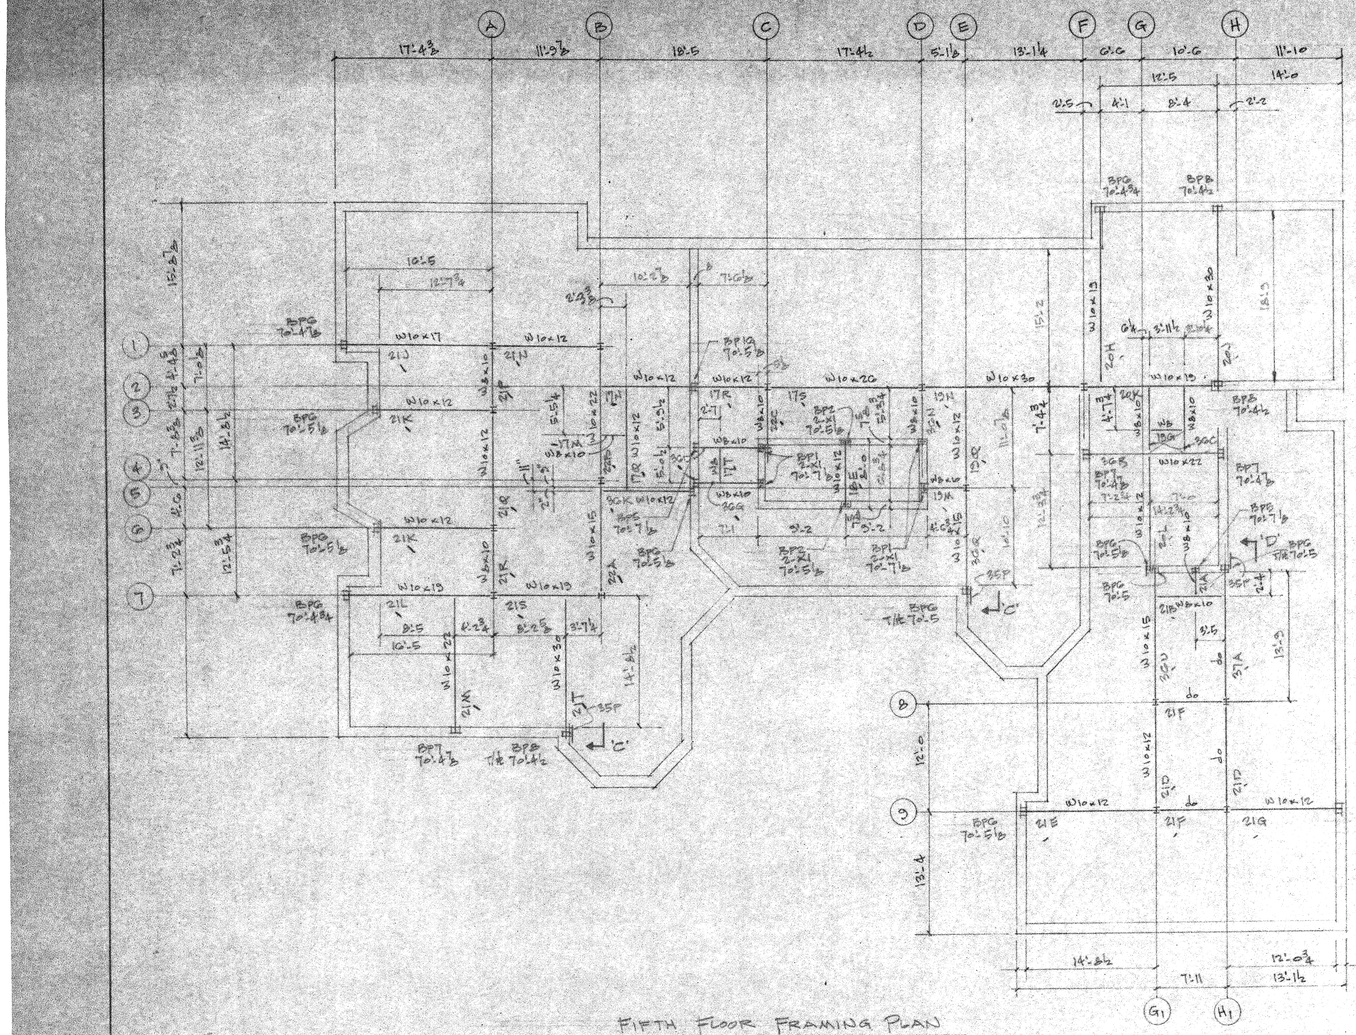

FIFTH FLOOR FRAMING PLAN

TOP OF STEEL EL. 71'-3 U.N.
SEE DWG. 21 FOR SEATS. & BRG. PL DETAILS.

ERECTOR NOTE!

BACK CHARGES FOR REPAIRS OR ALTERATIONS TO OUR WORK WILL NOT BE ACCEPTED UNLESS APPROVED BY NOVEL IRON WORKS, INC.

WALSH BROS.
REVIEWED FOR CONFORMANCE WITH CONTRACT REQUIREMENTS
SPEC. SECTION 5100
FILE # 7
SUB. # 2
SUBCONTRACTOR NOVEL
DATE 10/24/90
BY PC

FINAL APPROVAL
DATE OCT 24 1990

FOR ERECTION
DATE OCT 16 1990

FOR APPROVAL
AUG 3 1990

FIELD CONNS: 3/4 A.S. BOLT W/N & W (A325-N) U.N.

REVISIONS			PRINT RECORD		
NO.	DATE	DESCRIPTION	DATE	QTY.	ISSUED

NOVEL IRON WORKS
OCEAN ROAD
GREENLAND, N.H. 03840

PAINT	HOLES U.N. 16+	WELD U.N. E70XX	
PROJECT: HARVARD UNIV. RENOVATIONS, 51 BRATTLE ST., CAMBRIDGE, MASS.			DATE 7-30
DESCRIPTION: 5TH FLOOR FRAMING PLAN			DRAWN BY RCD
ARCH. B. THOMPSON & ASSOC.	ENG. LE MESSURIER		CHK'D BY
CUSTOMER: WALSH BROS.			JOB NO. 130
			SHT. NO. E4

10-10-90
9-17-90

930-1169