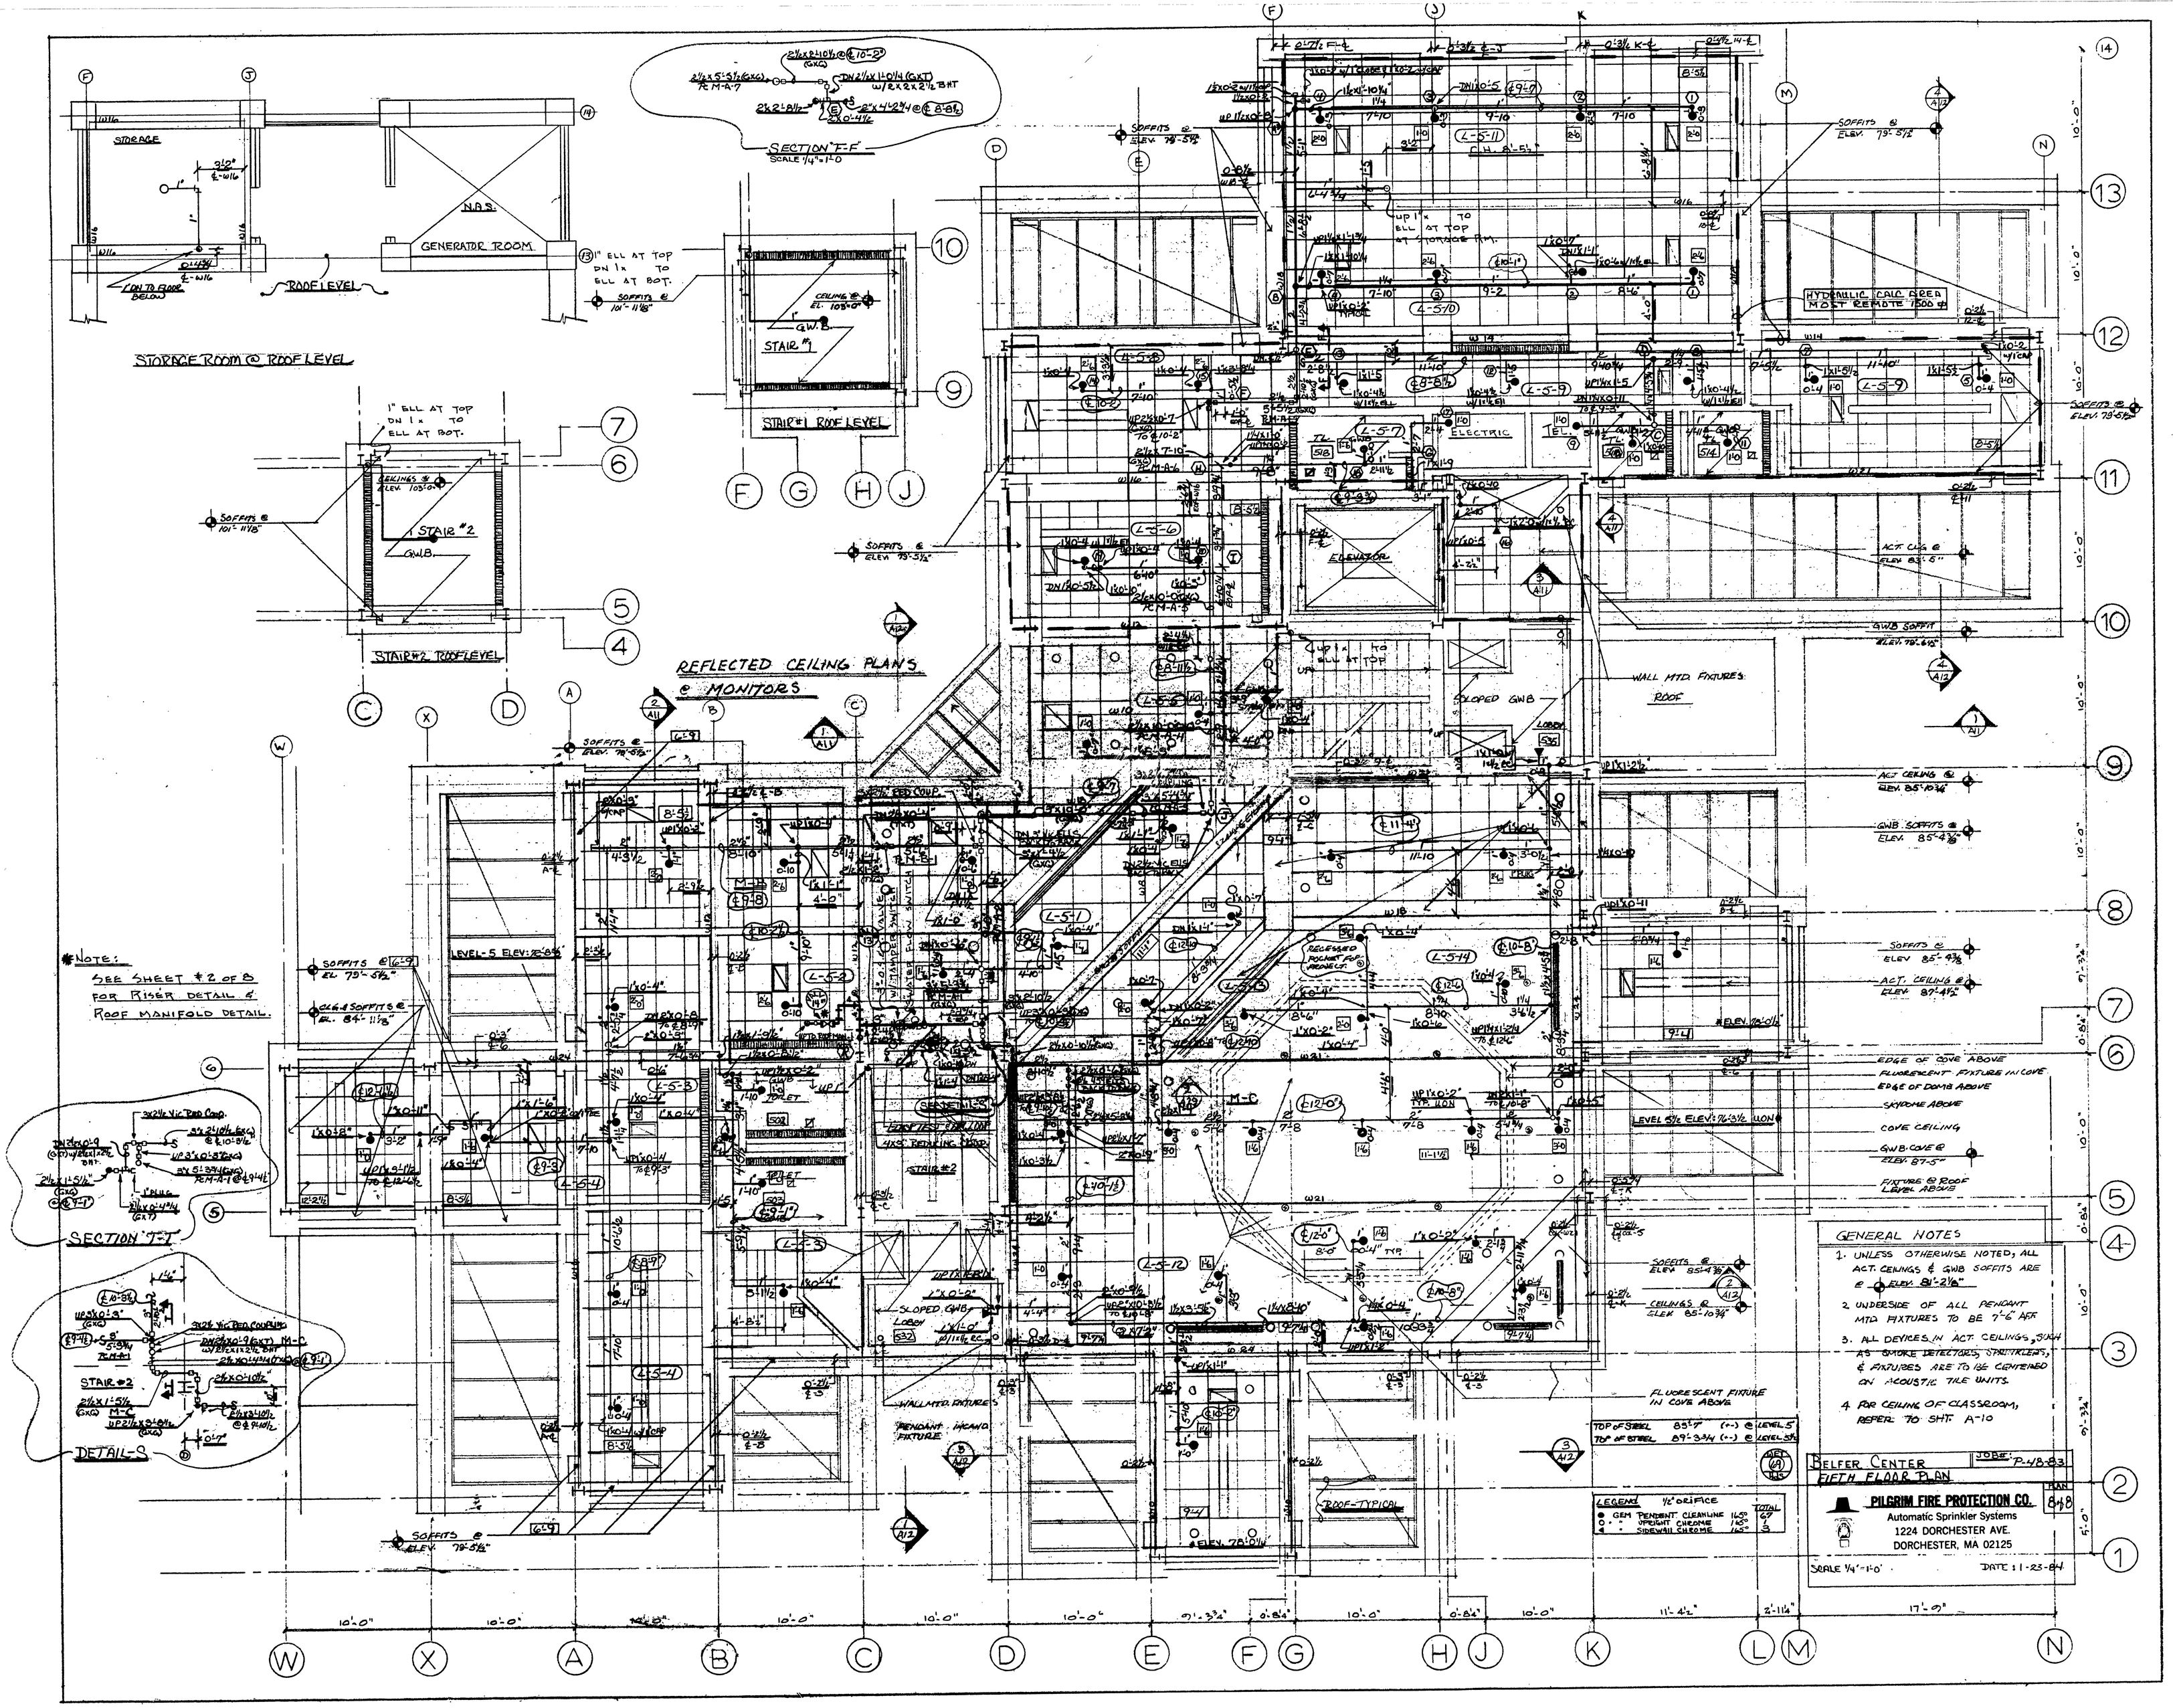

NOTE:
SEE SHEET #2 OF 8 FOR RISER DETAIL & ROOF MANIFOLD DETAIL.

GENERAL NOTES

1. UNLESS OTHERWISE NOTED, ALL ACT. CEILINGS & GWB SOFFITS ARE @ ELEV. 81'-2⅛"
2. UNDERSIDE OF ALL PENDANT MTD. FIXTURES TO BE 7'-6" AFF.
3. ALL DEVICES IN ACT. CEILINGS, SUCH AS SMOKE DETECTORS, SPRINKLERS, & FIXTURES ARE TO BE CENTERED ON ACOUSTIC TILE UNITS.
4. FOR CEILING OF CLASSROOM, REFER TO SHT. A-10

TOP OF STEEL 85'-7" (+-) @ LEVEL 5
TOP OF STEEL 89'-3¾ (+-) @ LEVEL 5½

LEGEND ½" ORIFICE

● GEM	PENDANT CLEARLINE	165°	67
○ •	UPRIGHT CHROME	165°	1
◆ •	SIDEWALL CHROME	165°	3

BELFER CENTER
FIFTH FLOOR PLAN
JOBE: P-48-83

PILGRIM FIRE PROTECTION CO.
Automatic Sprinkler Systems
1224 DORCHESTER AVE.
DORCHESTER, MA 02125

SCALE 1/4"=1'-0" DATE: 1-23-84

BELFER CENTER

KENNEDY SCHOOL of GOVERNMENT

HARVARD UNIVERSITY

SCALE: 1/4"=1'-0"

DRAWN: RCM.

DATE: 6/15/83

REVISIONS:
1 9-23-83
2
3
4
5
6

FIFTH FLOOR REFLECTED CEILING PLAN

ARCHITECT:
ARCHITECTURAL RESOURCES CAMBRIDGE INC.

GILBANE BUILDING CO. GENERAL CONTRACTORS

SUBMITTED BY:
MORE DRYWALL CO. INC.
129 SECOND ST.
MANCHESTER, N.H.

AS-BUILTS
DATED 4-16-84

707-0090