
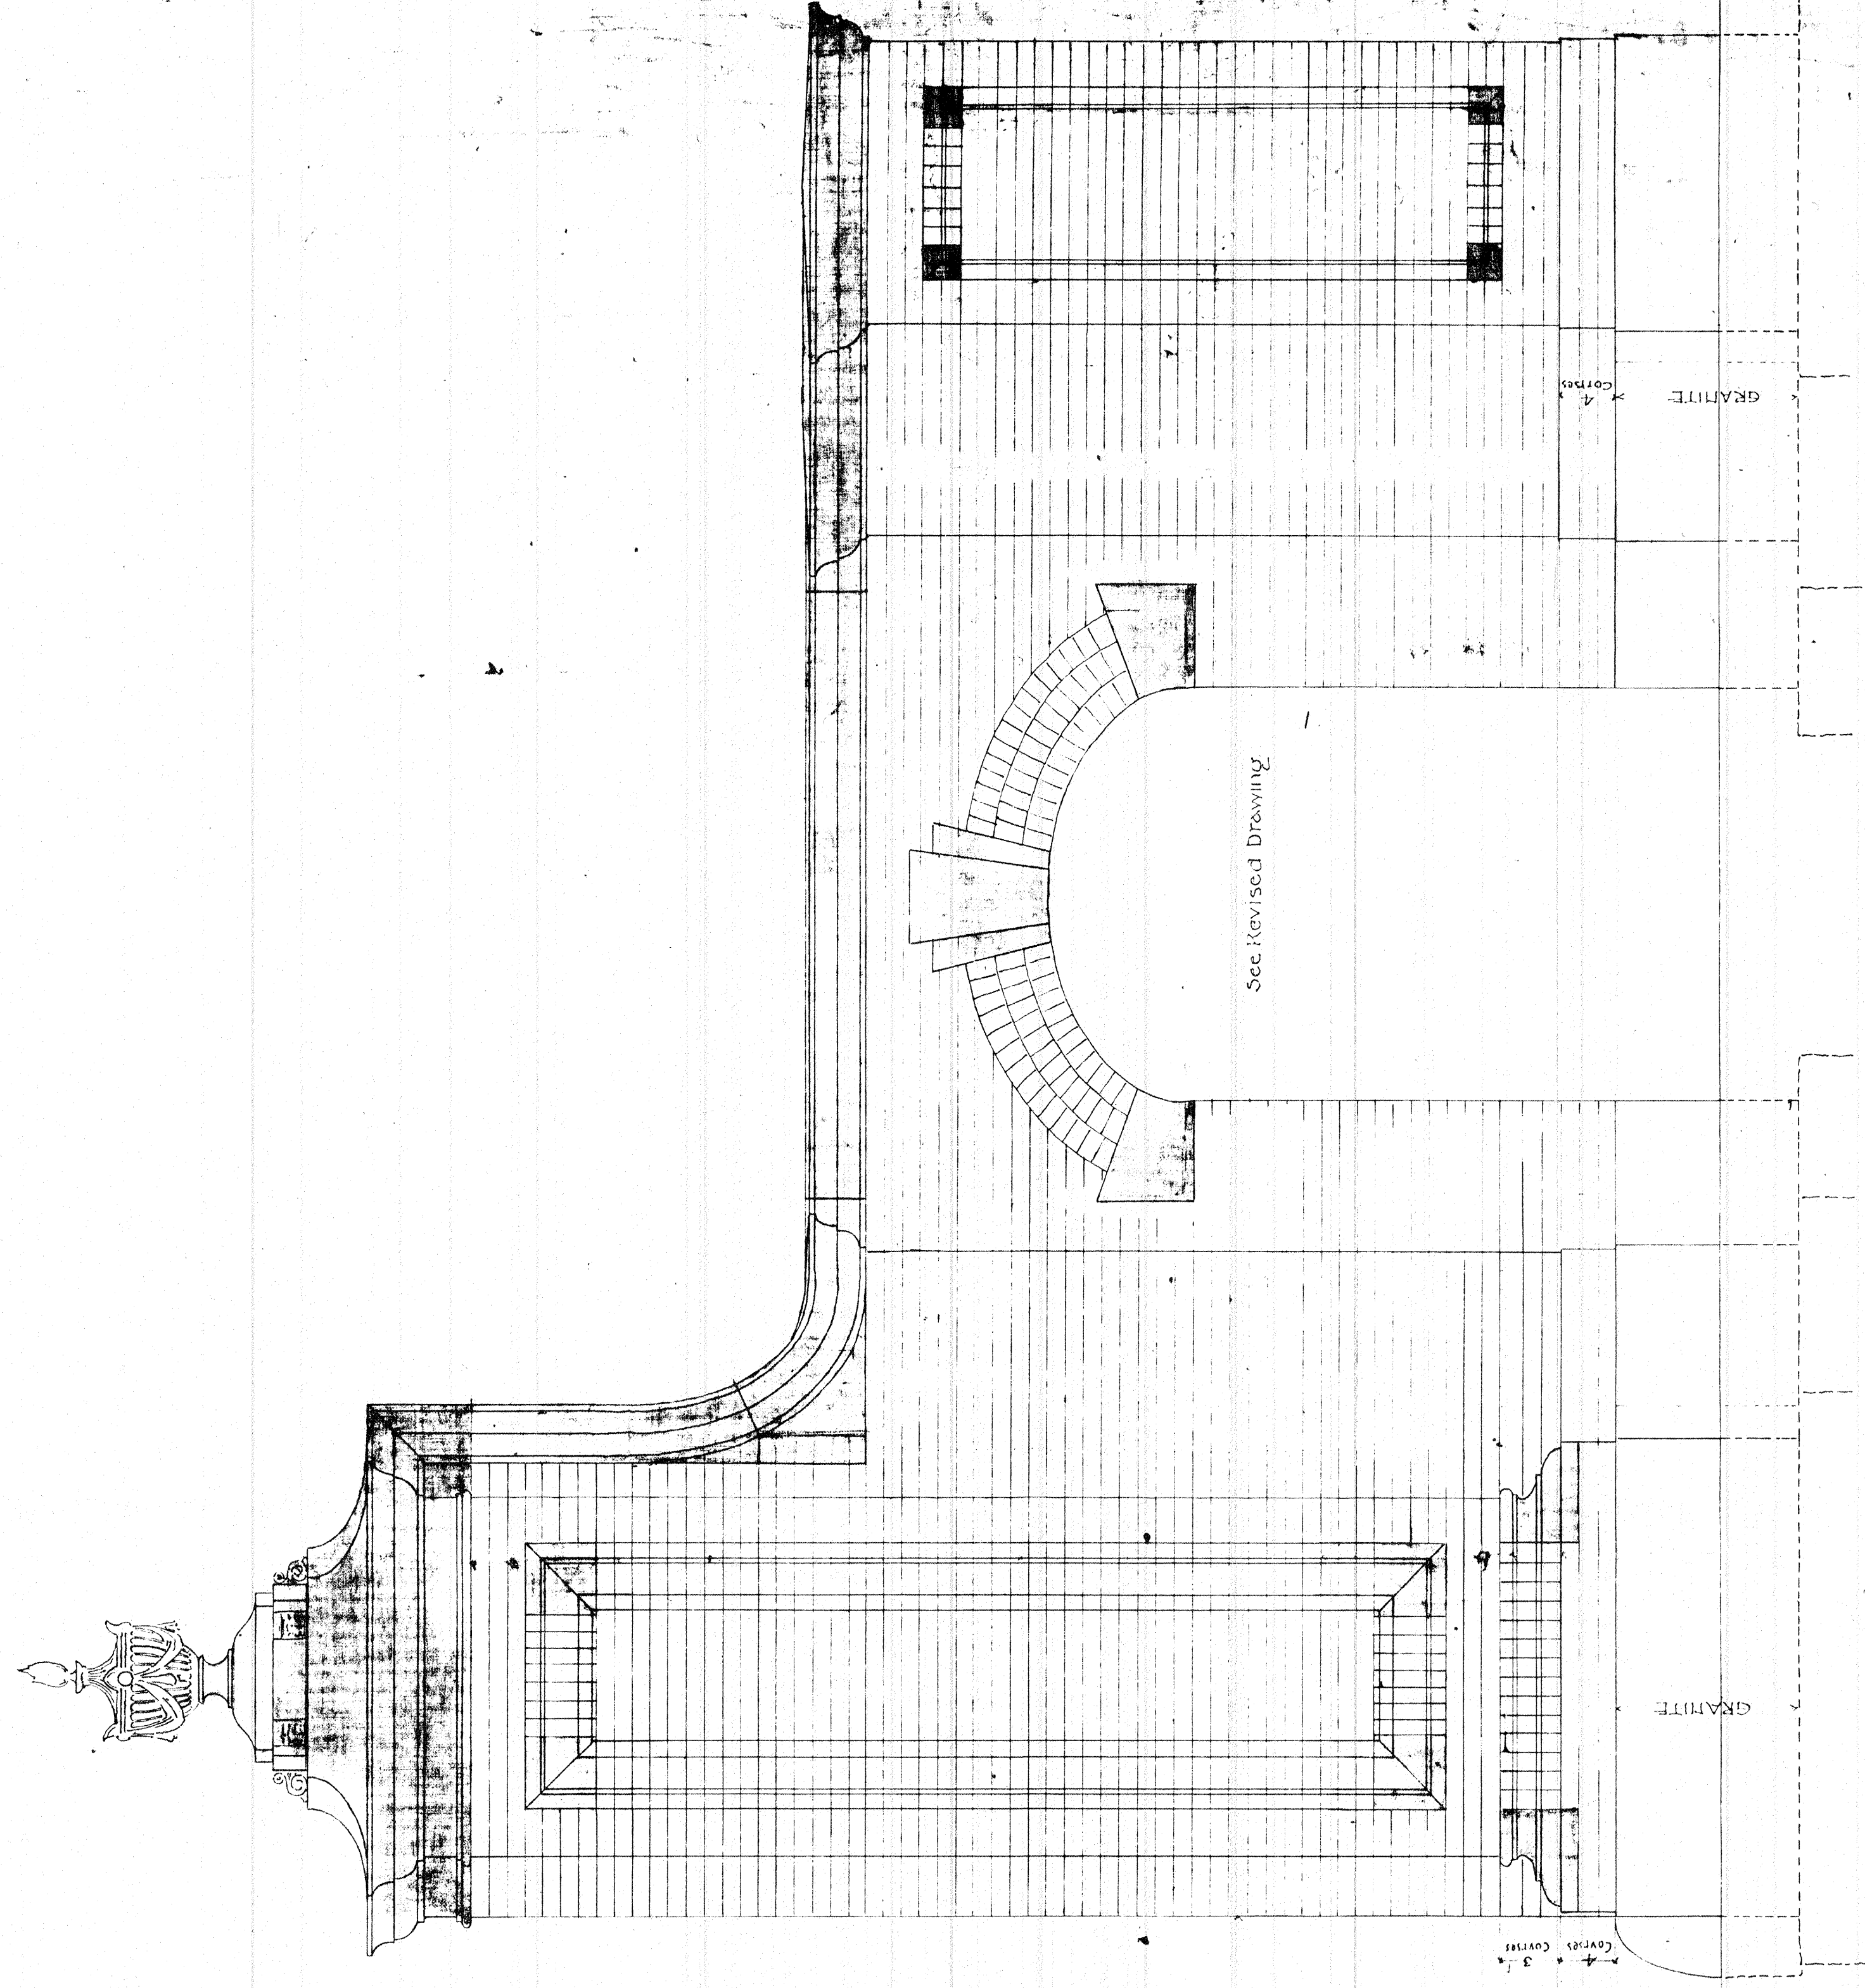


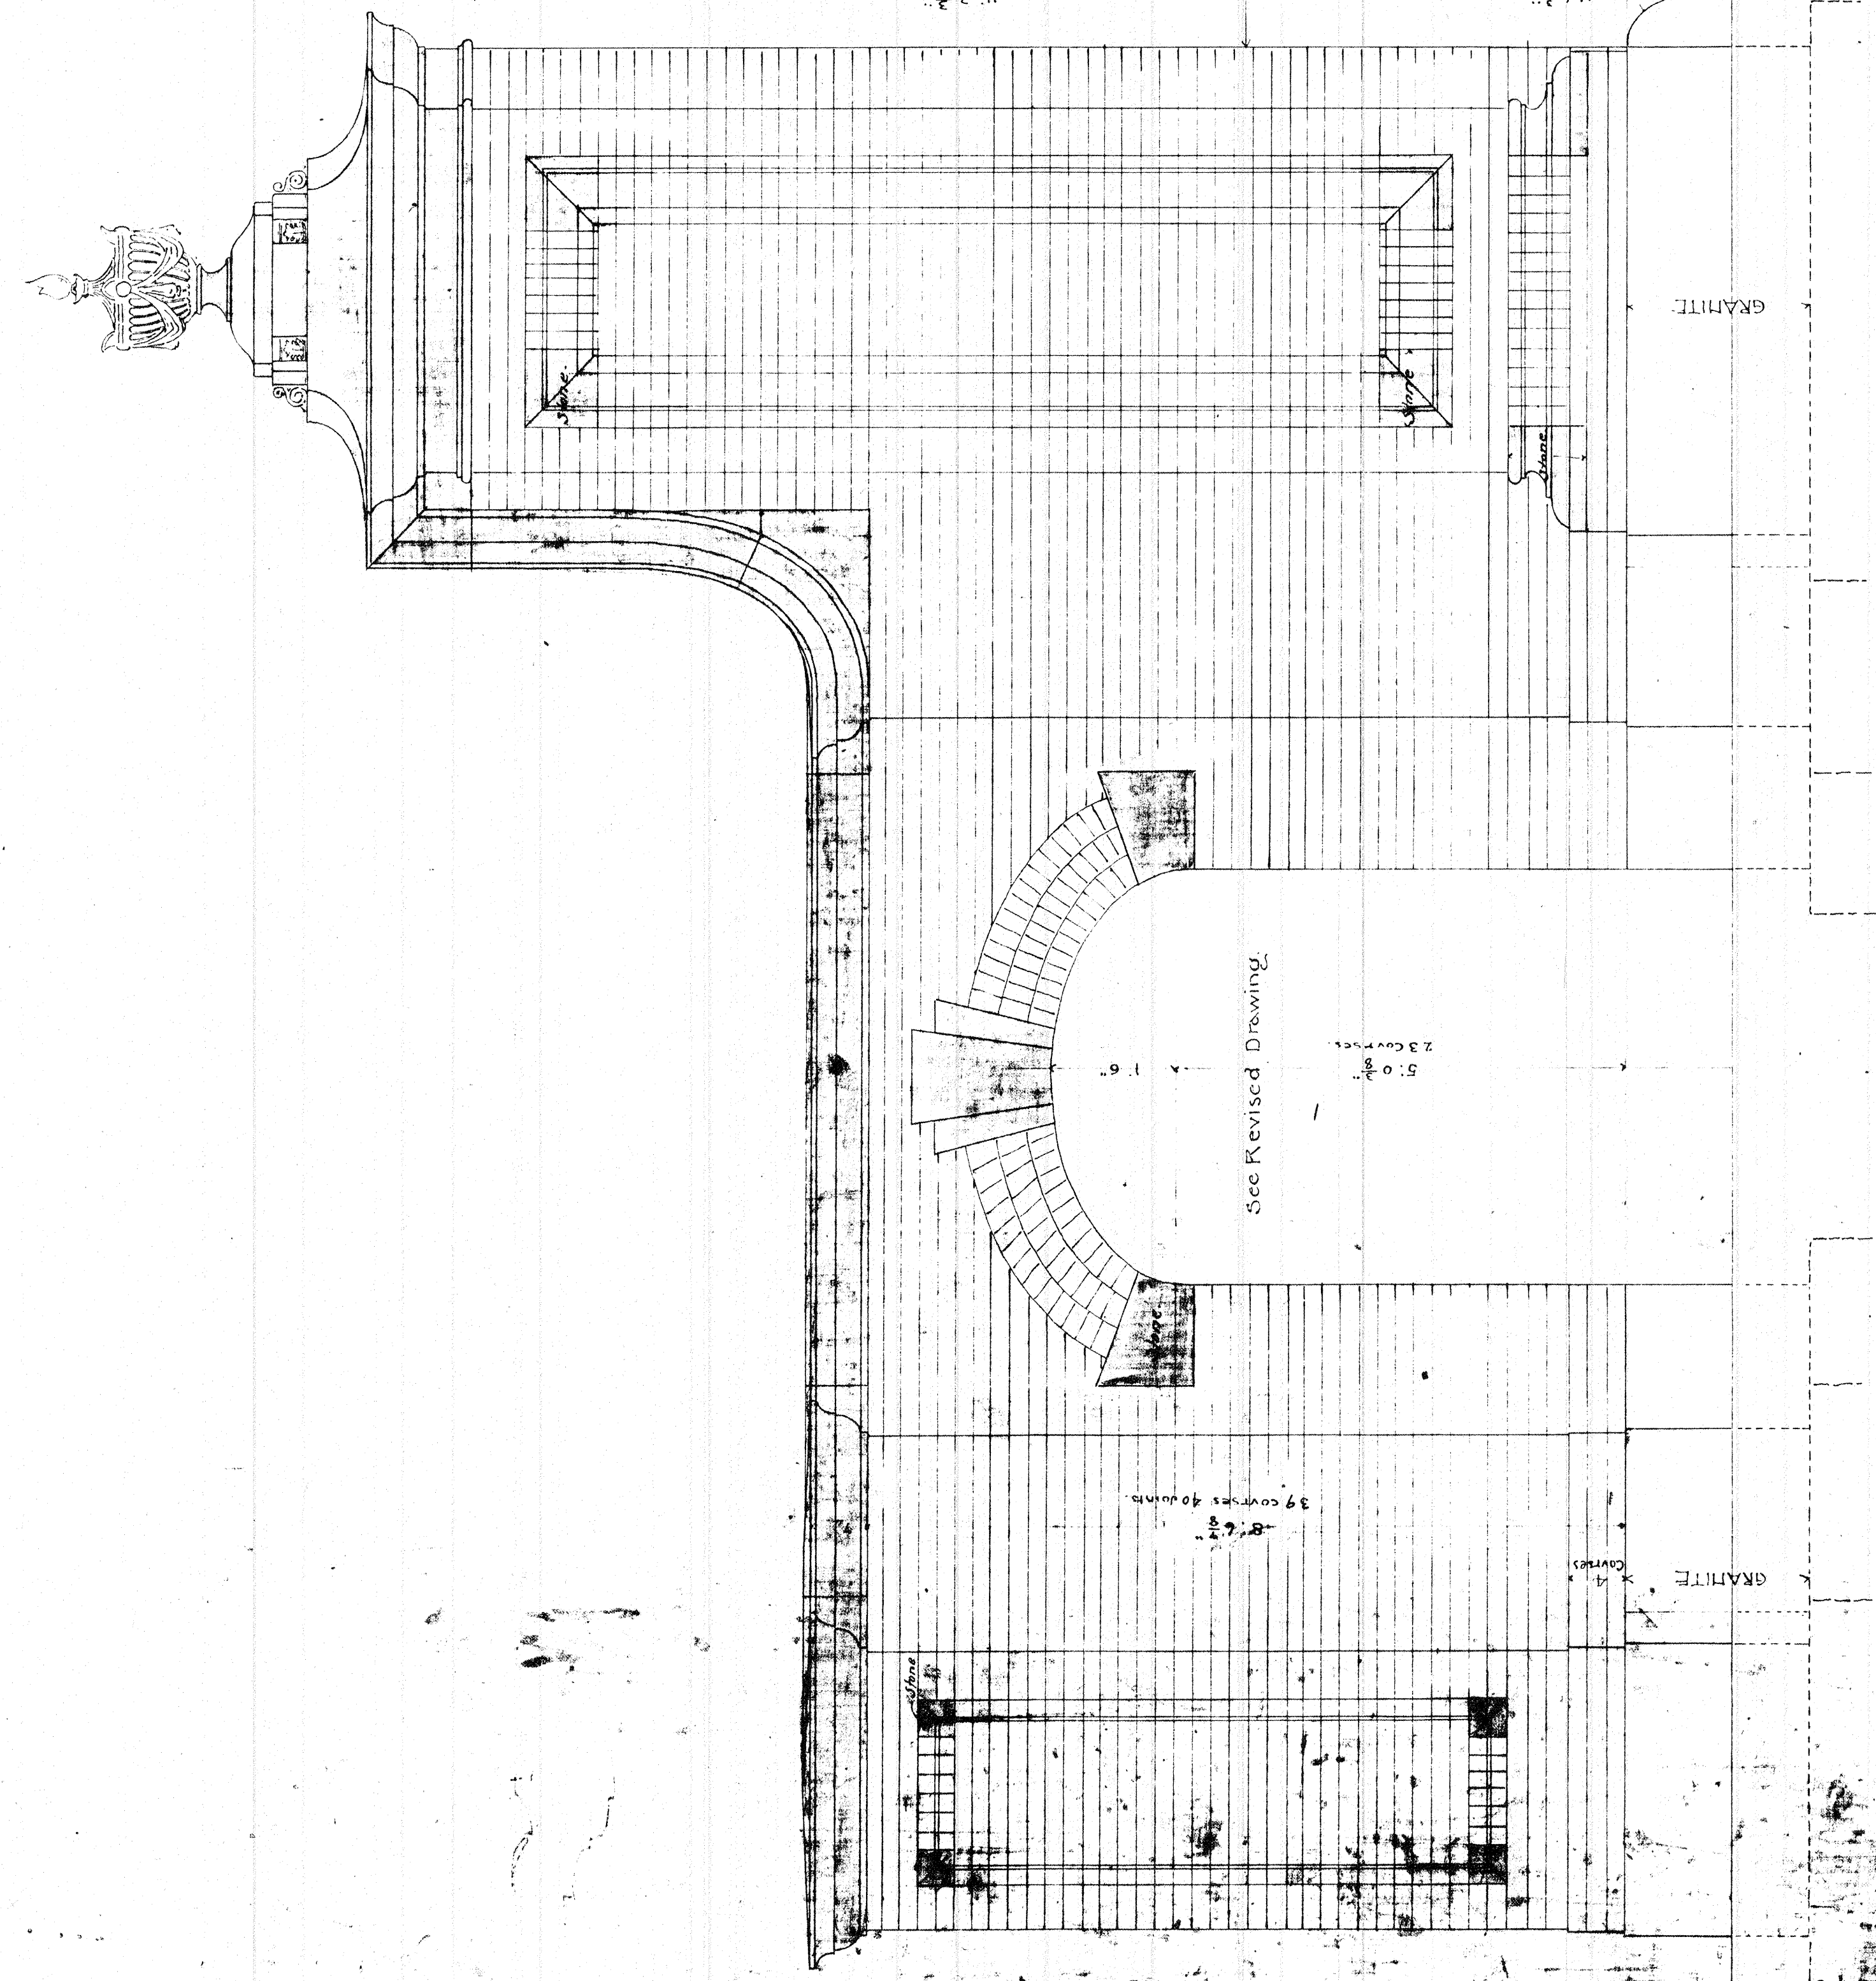

FRONT ELEVATION OF GATE
AT ENTRANCE TO GROUNDS OF HARVARD COLLEGE HARVARD ST
CAMBRIDGE MASS.

MRS. J. H. B. & WHITE ARCHT'S 57 BROADWAY, NEW YORK.

For Foundations see Section.

SCALE 3/4" = 1' FOOT

CAMBRIDGE MASS.

3

1430

1430

1430

CL-FG 002A