
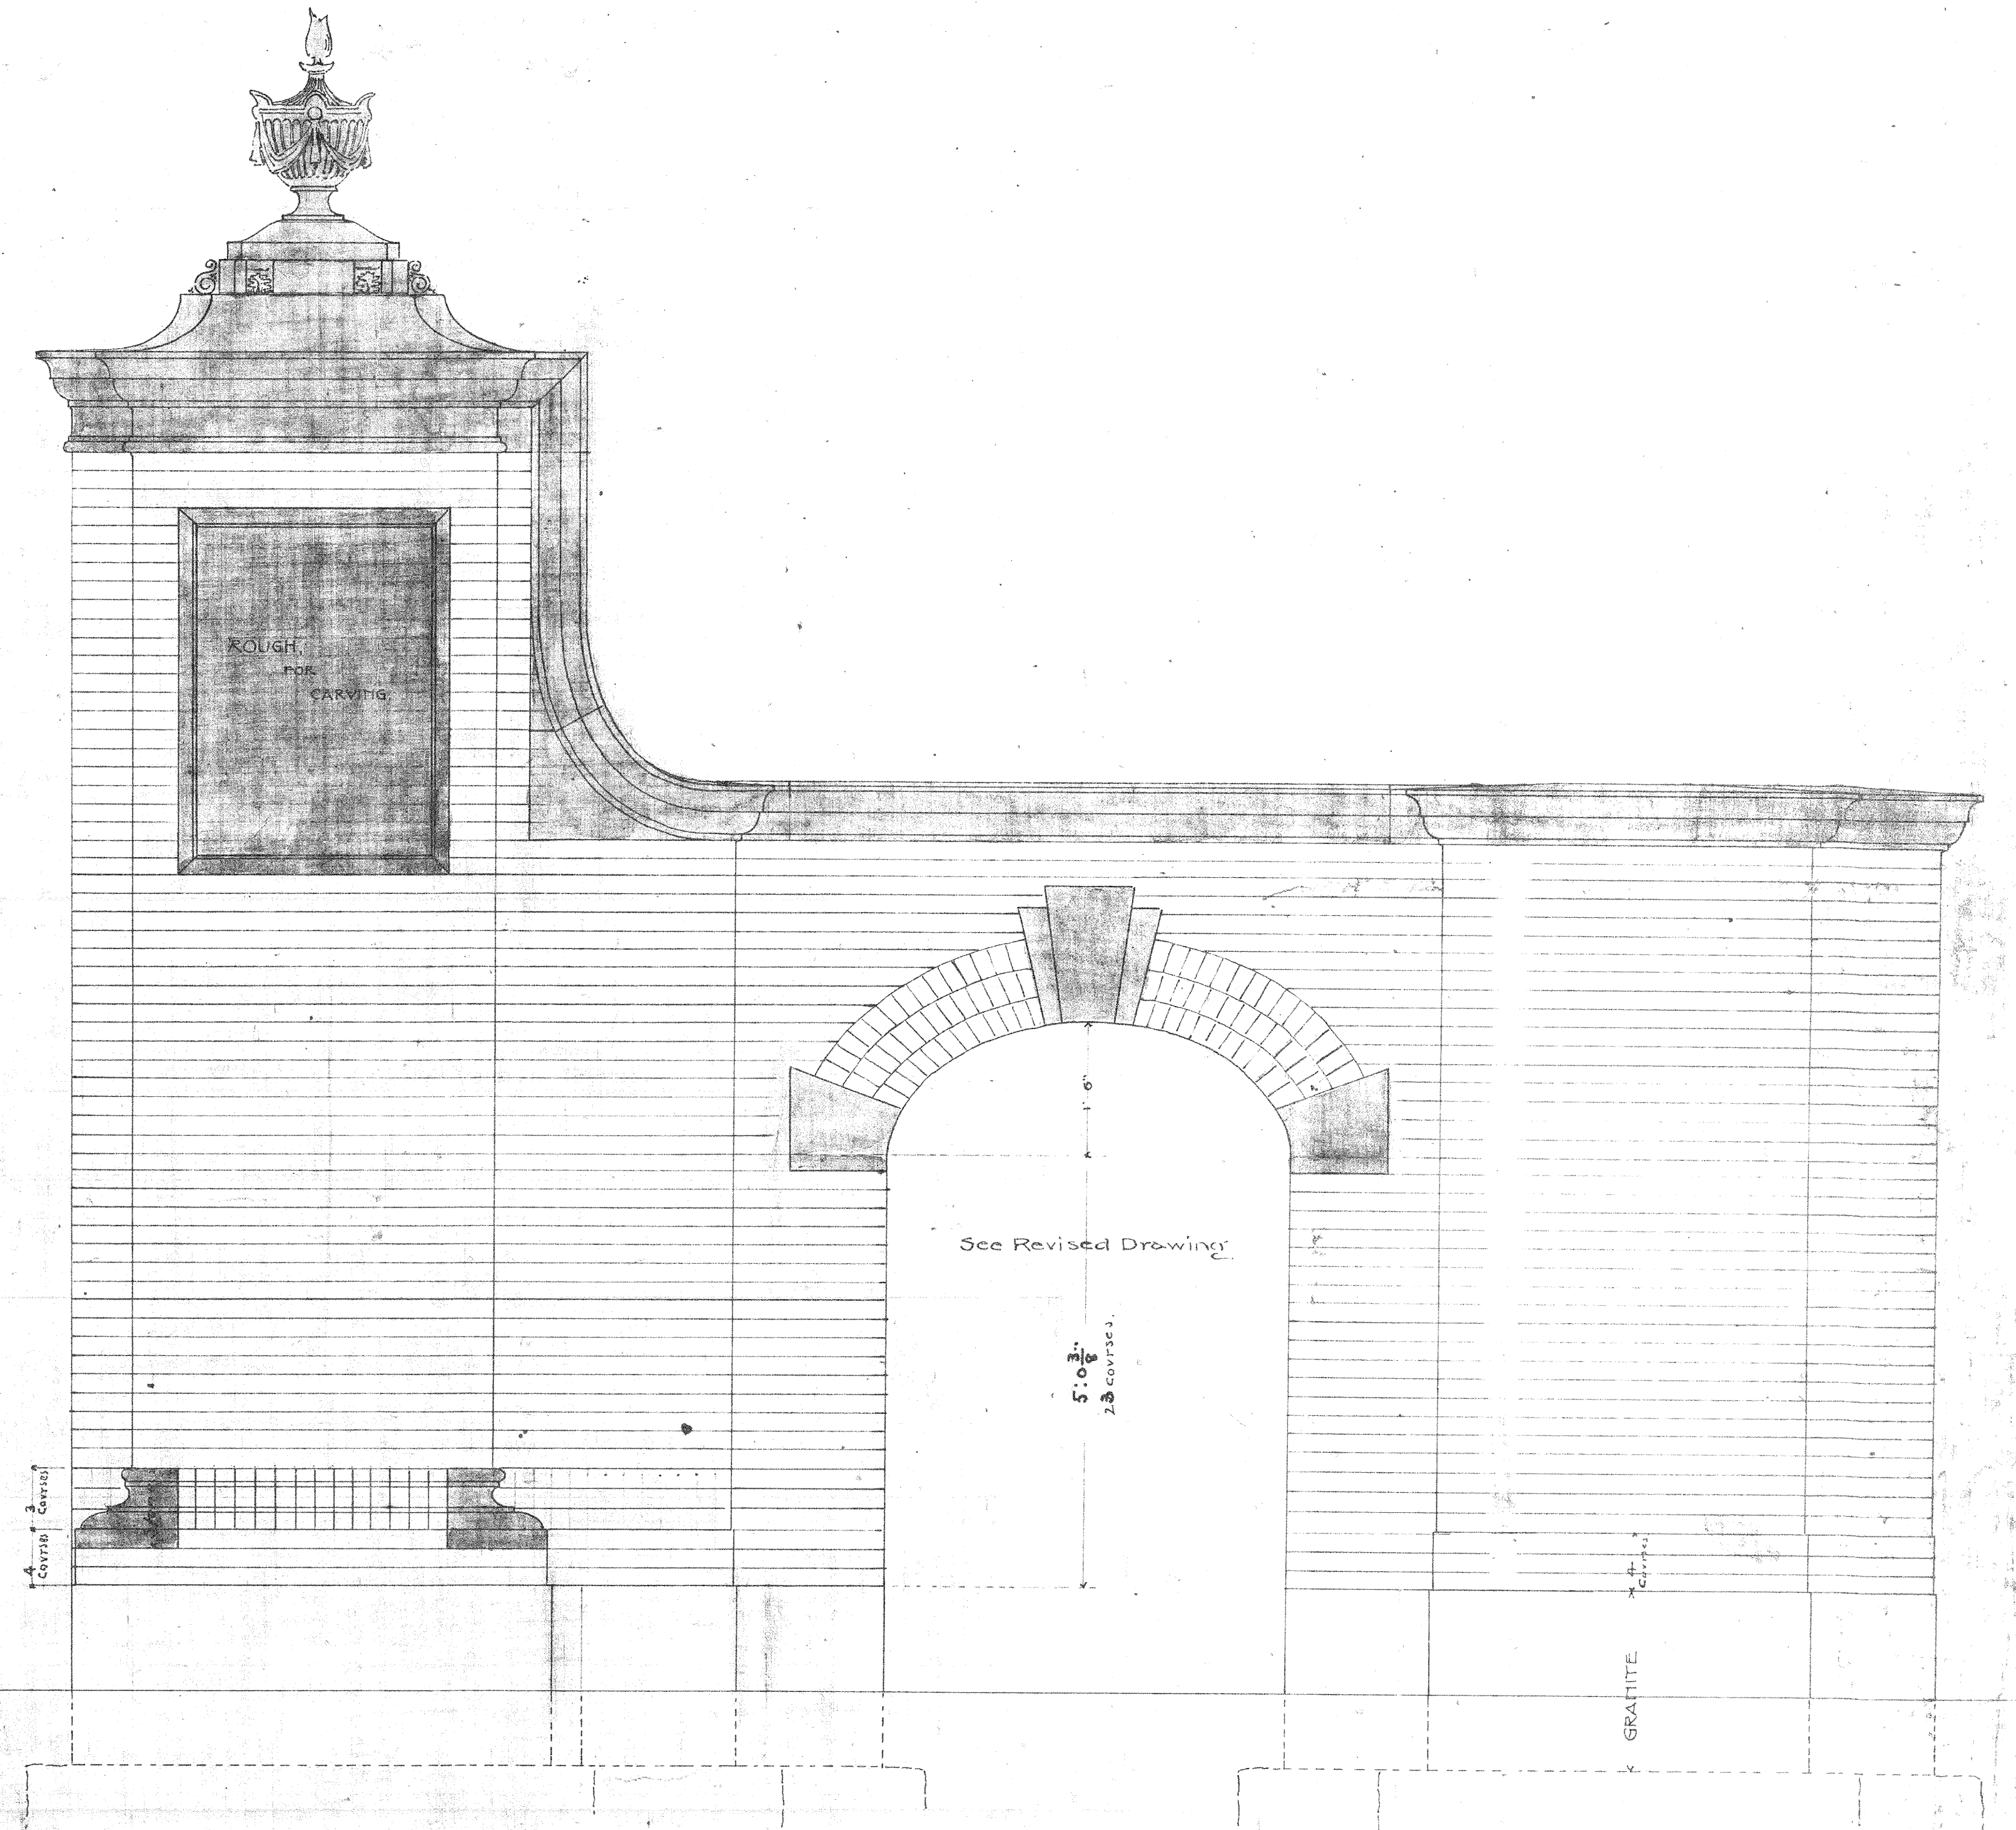


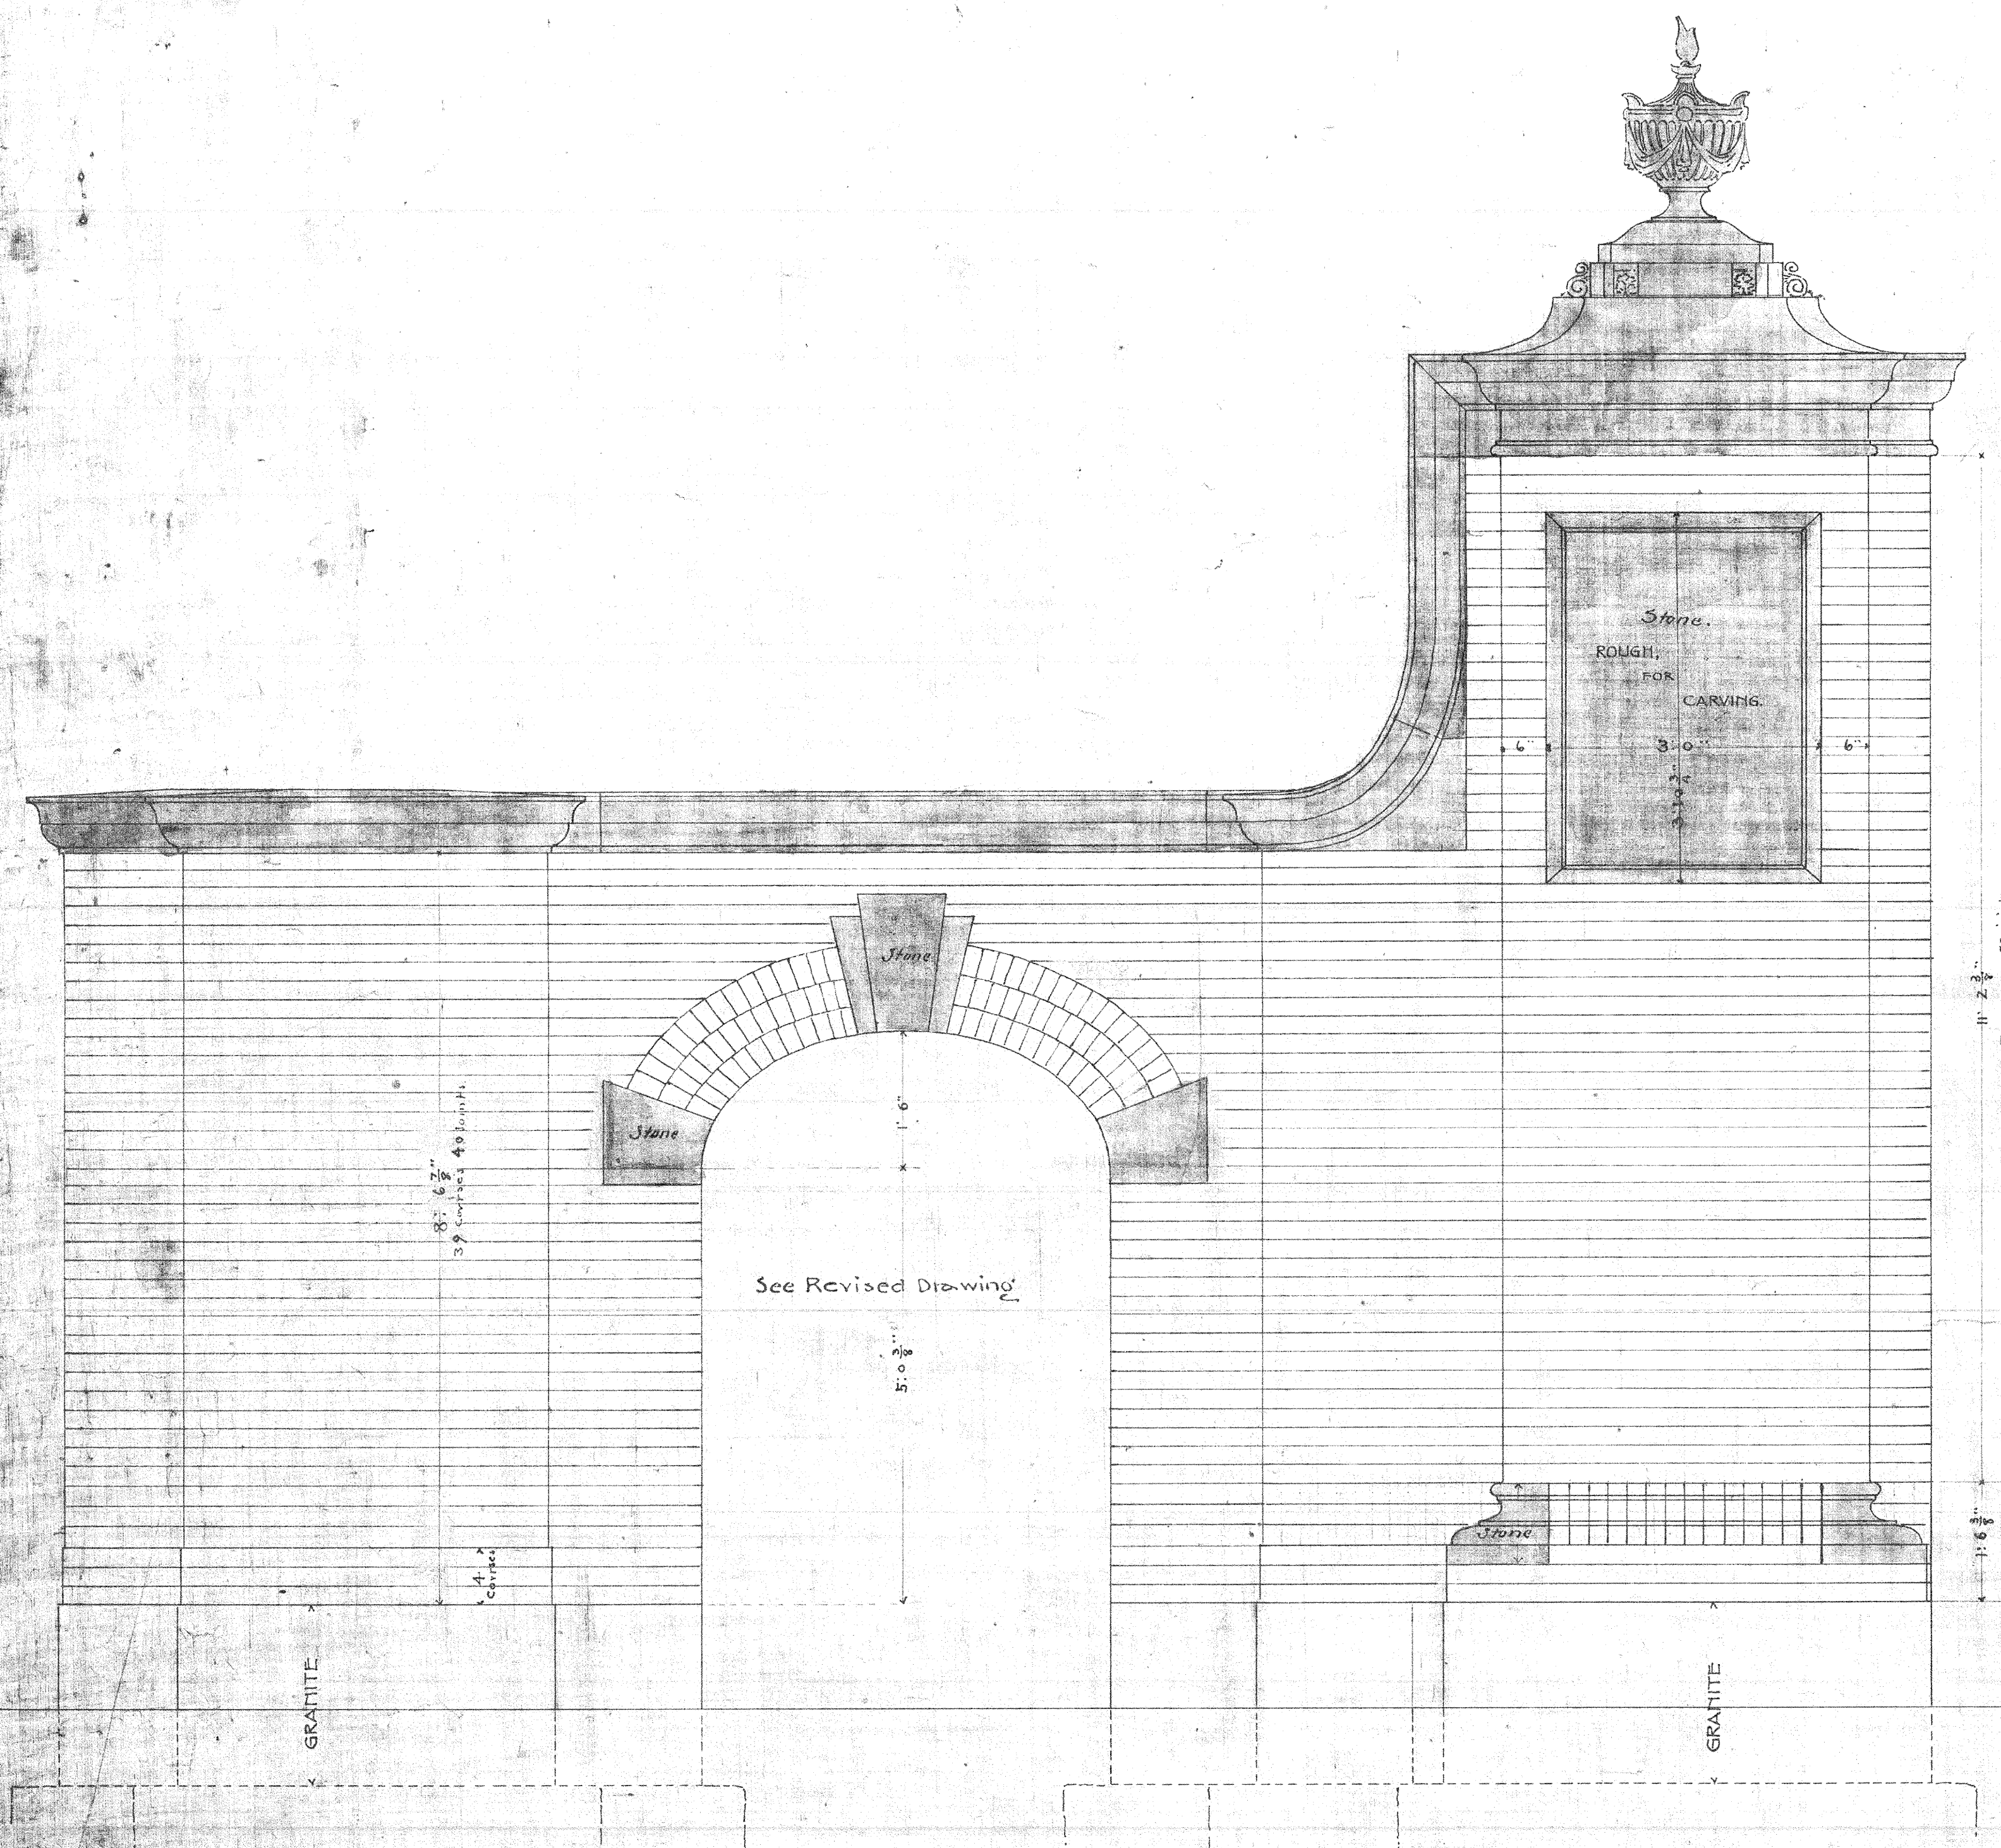


REAR ELEVATION OF GATE
AT ENTRANCE TO GROUNDS OF HARVARD COLLEGE, HARVARD ST.
CAMBRIDGE MASS.

MCKIM MEAD & WHITE ARCHTS 37 BROADWAY NEW YORK

SCALE $\frac{3}{4}$ INCH = 1 FOOT

For Foundations see Section

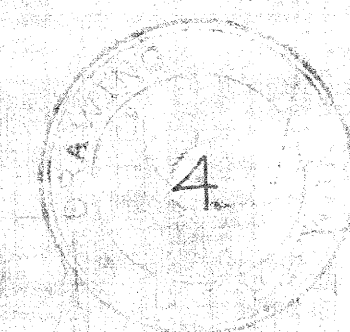

1431

1431

207-46