



Drawn by TFL
 Checked by RCS
 Date Issued 1/22/03
 Drawing Scale 1/8" = 1'-0"
 Issued 1/22/03
 BULLETIN #6
 COORDINATION
 VALUE ENGINEERING
 FOR CONSTRUCTION
 ISSUED 09/21/02
 Issued

Burt Hill Kosar Ritelmann Associates
 270 Congress Street
 Boston, MA 02210
 617-423-4252
 FAX: 617-423-4333
 200 Brickstone Square
 Andover, MA 01810
 978-474-6405
 FAX: 978-474-6401

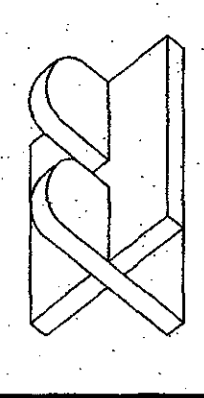

1
 ELEVATION: NORTH
 1/8" = 1'-0"

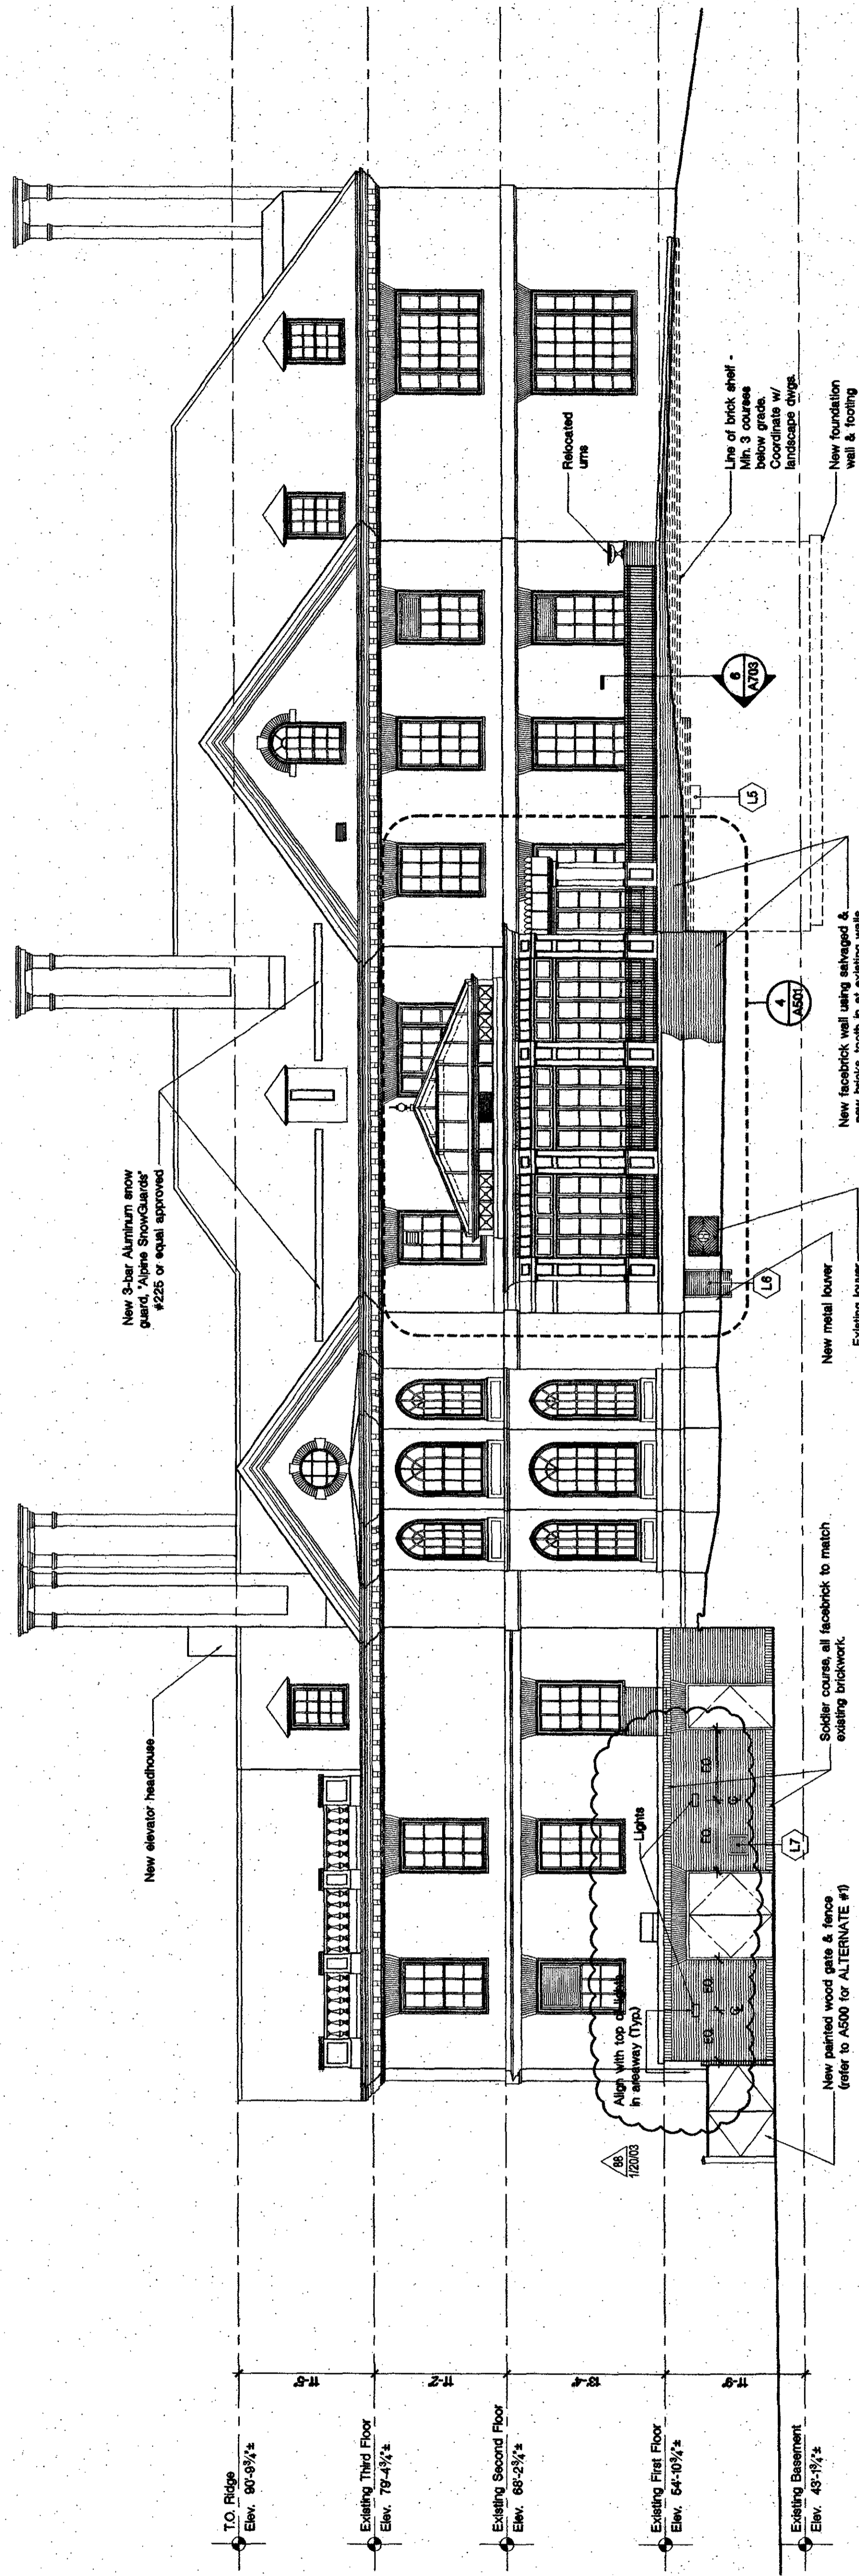

2
 ELEVATION: WEST
 1/8" = 1'-0"

