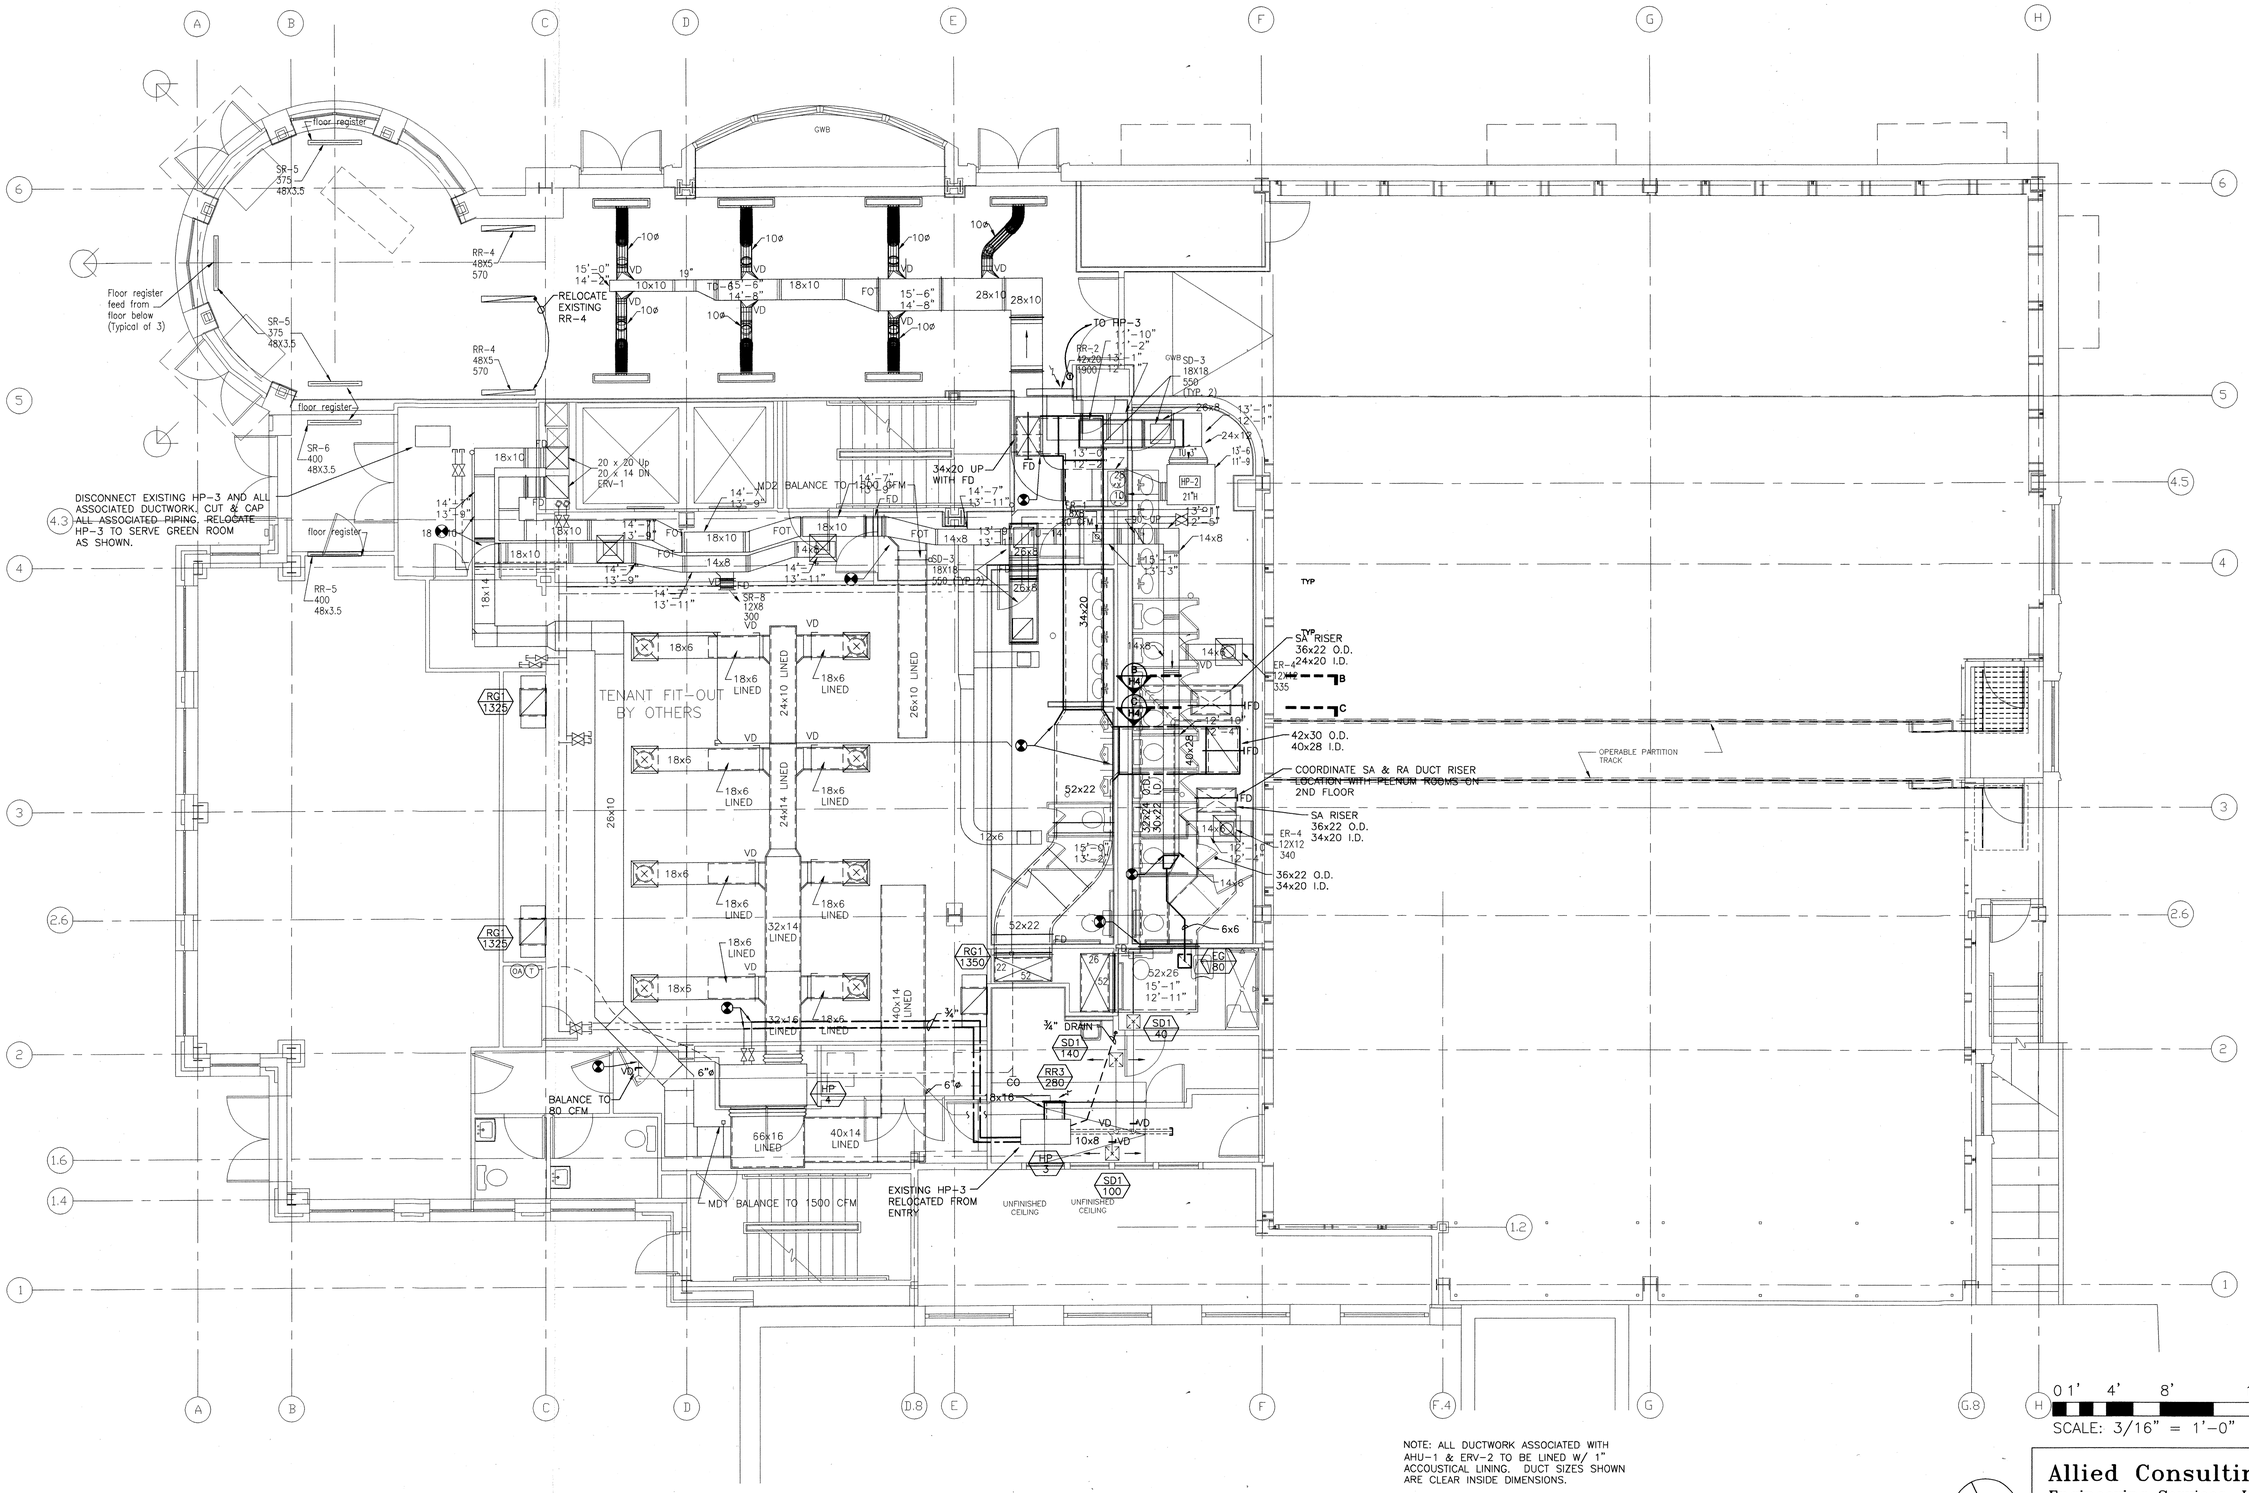

NOTE: ALL DUCTWORK ASSOCIATED WITH AHU-1 & ERV-2 TO BE LINED W/ 1" ACCOUSTICAL LINING. DUCT SIZES SHOWN ARE CLEAR INSIDE DIMENSIONS.

FIRST FLOOR PLAN / HVAC

SCALE: 3/16" = 1'-0"

N

Allied Consulting
Engineering Services, Inc.
215 Boston Post Road, Sudbury, MA
(978) 443-7888
FAX (978) 443-4636

A.R.T. BLACK BOX THEATRE AT 2-4 ARROW STREET, CAMBRIDGE MA

HARVARD REAL ESTATE SERVICES / AMERICAN REPERTORY THEATRE

ALLIED CONSULTANTS t: 978.443.7888
RICHMOND SO ENGINEERS t: 617.923.4800
SCHIRMER ENGINEERING t: 508.872.3033
COLLECTIVE WISDOM CORPORATION t: 781.647.7732

MARYANN THOMPSON ARCHITECTS
114 HILLSIDE AVENUE
CAMBRIDGE, MA 02140
T. 617.491.4444
F. 617.491.3844

©MARYANN THOMPSON ARCHITECTS

SET	DATE

CURRENT ISSUE:

SET	DATE
RECORD DRAWINGS	04.30.05

DRAWING TITLE:

FIRST FLOOR PLAN
HVAC

H2

F:\24030-39\24032\HVAC\24032-H1.dwg PLOTTED: May 09, 2005 - 3:20pm

06204_0038