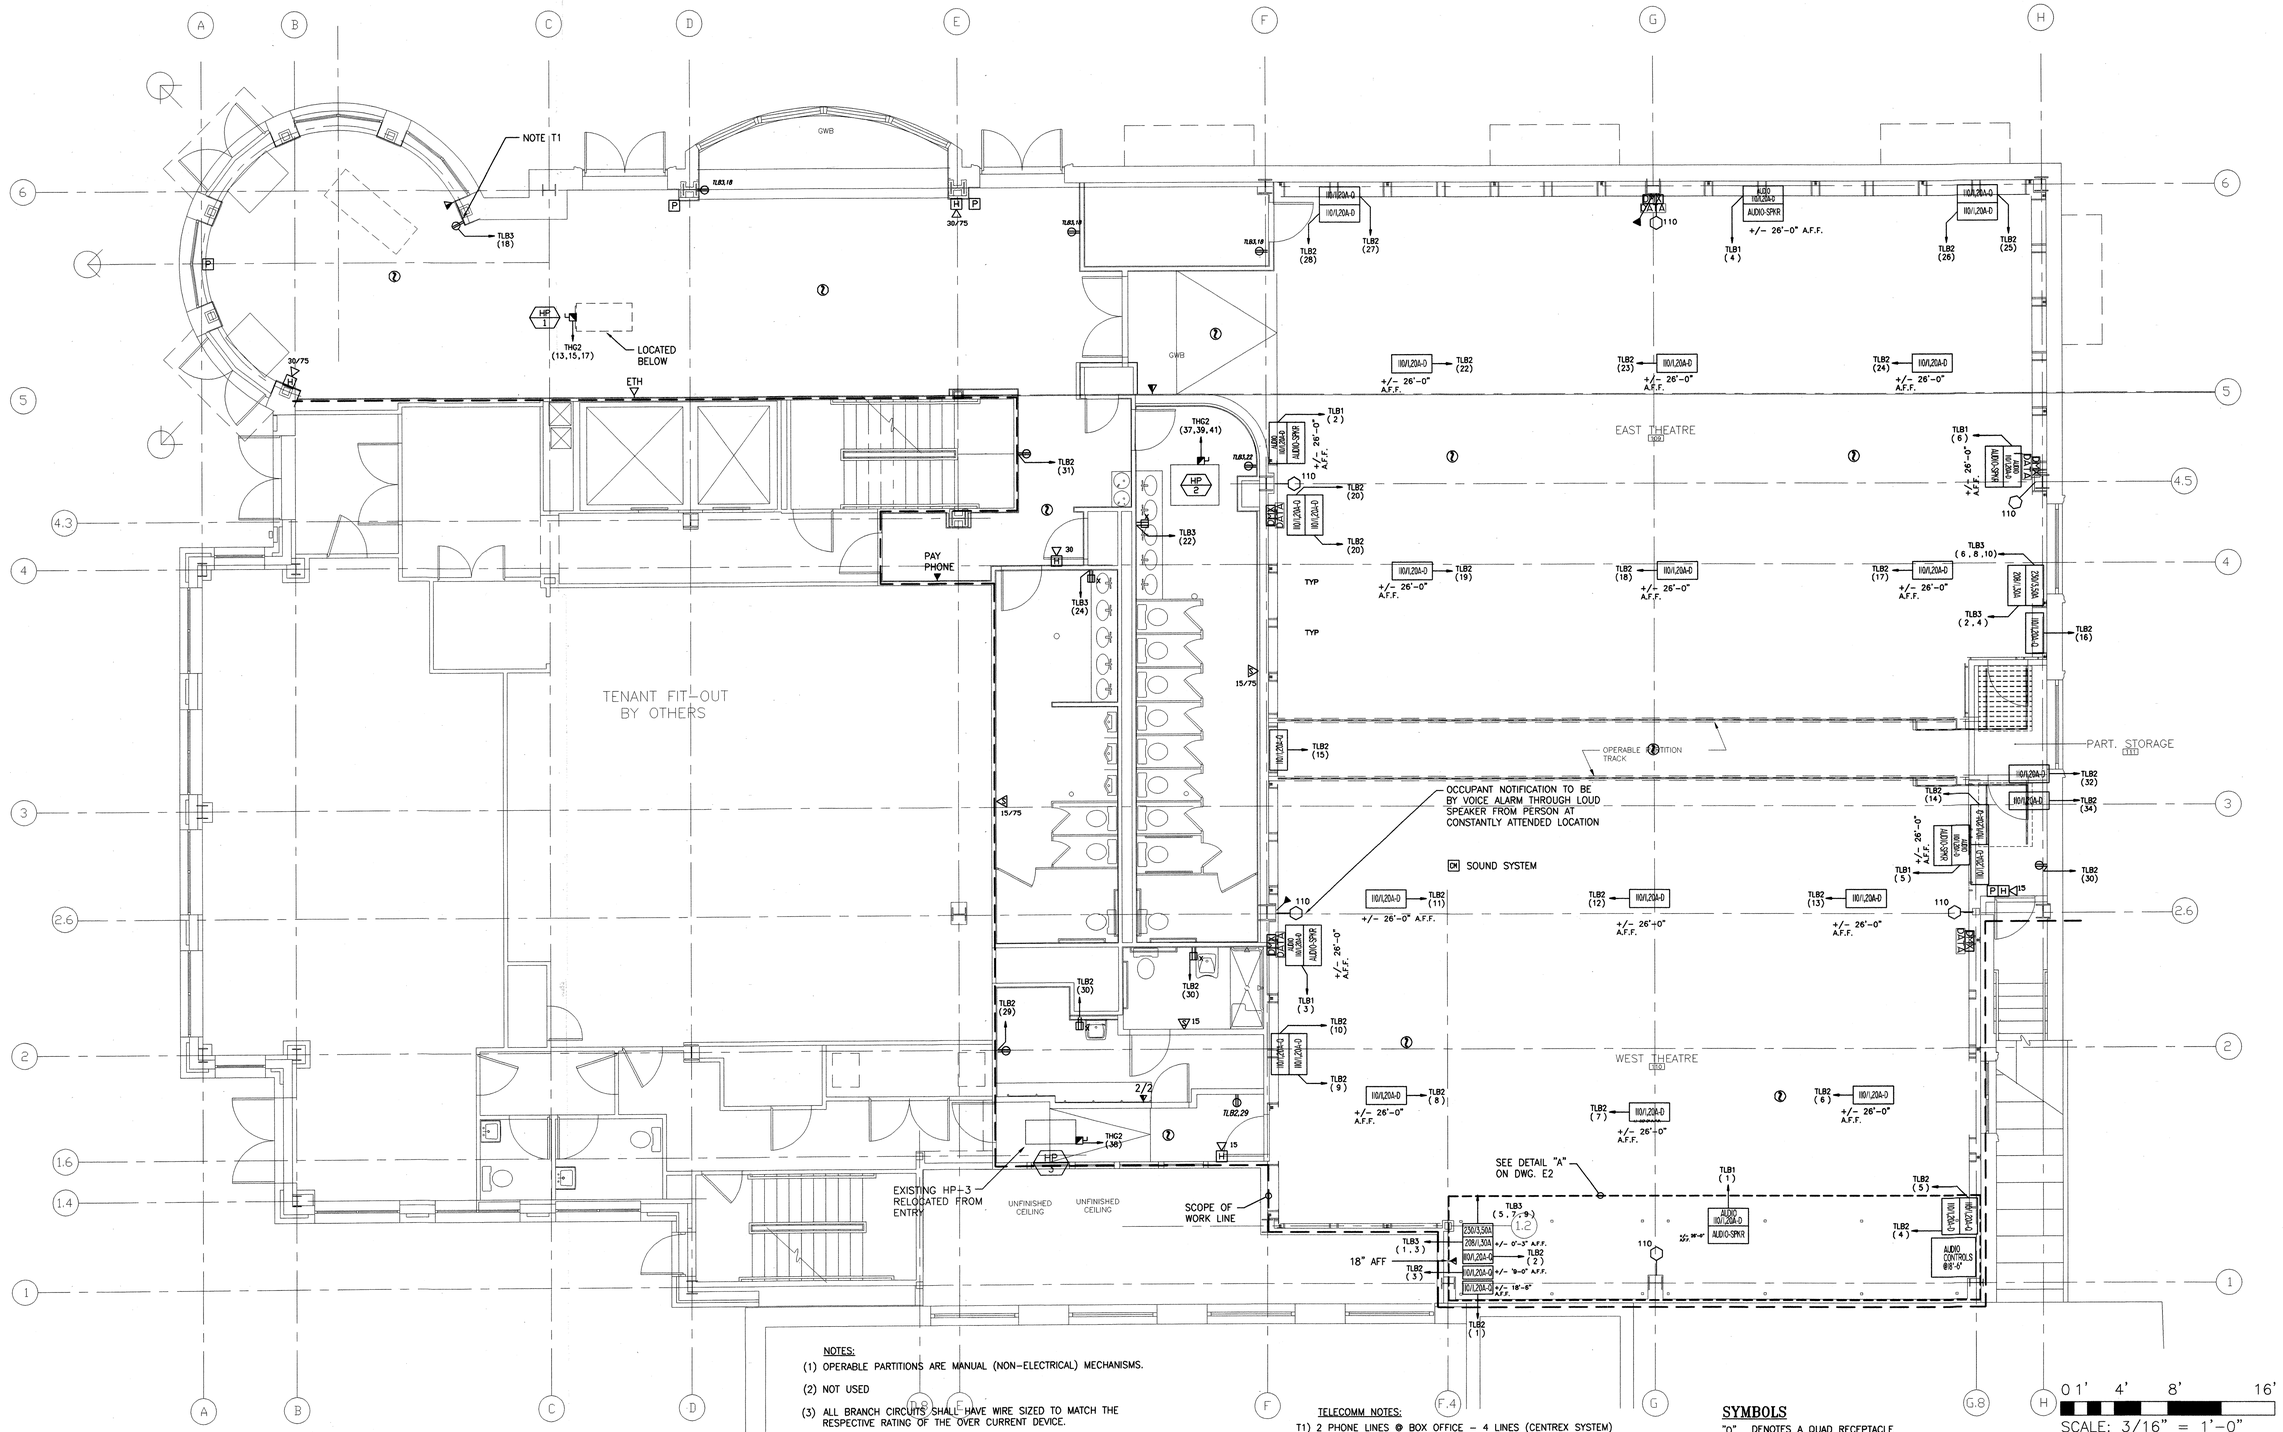

NOTES:

(1) OPERABLE PARTITIONS ARE MANUAL (NON-ELECTRICAL) MECHANISMS.

(2) NOT USED

(3) ALL BRANCH CIRCUITS SHALL HAVE WIRE SIZED TO MATCH THE RESPECTIVE RATING OF THE OVER CURRENT DEVICE.

(4) THE ELECTRICAL CONTRACTOR SHALL PROVIDE 4" STAND-OFFS FOR ALL ELECTRICAL OUTLETS, EMERGENCY BATTERY UNITS, FIRE ALARM DEVICES, TELEPHONE, DATA, SPEAKERS, ETC, THAT ARE LOCATED AROUND THE PERIMETER WALLS OF THE THEATRE AND 2" STAND-OFFS FOR THE INTERIOR THEATRE WALLS.

TELECOMM NOTES:

T1) 2 PHONE LINES @ BOX OFFICE – 4 LINES (CENTREX SYSTEM) WITH ADDED CAPACITY FOR INTERNAL TELECOM @ BACK PHONE JACK (CLEARCOM SYSTEM).

SYMBOLS

"Q" DENOTES A QUAD RECEPTACLE

"D" DENOTES A DUPLEX RECEPTACLE

(I) DENOTES AN INTERCOM OUTLET

SCALE: 3/16" = 1'-0"

SECOND FLOOR PLAN / POWER, FIRE ALARM

SCALE: 3/16" = 1'-0"

Allied Consulting Engineering Services, Inc.
215 Boston Post Road, Sudbury, MA
(978) 443-7888
FAX (978) 443-4636

A.R.T. BLACK BOX THEATRE AT 2-4 ARROW STREET, CAMBRIDGE MA

HARVARD REAL ESTATE SERVICES / AMERICAN REPERTORY THEATRE

MARYANN THOMPSON ARCHITECTS
14 HILLSIDE AVENUE
CAMBRIDGE, MA 02140
T. 617.491.4144
F. 617.491.3844

© MARYANN THOMPSON ARCHITECTS

ALLIED CONSULTANTS t 978.443.7888
RICHMOND SO ENGINEERS t 617.923.4800
SCHIRMER ENGINEERING t 508.872.3033
COLLECTIVE WISDOM CORPORATION t 781.647.7732

SET	DATE

CURRENT ISSUE:	
SET	DATE
RECORD DRAWINGS	04.30.05

DRAWING TITLE:

FIRST FLOOR PLAN
POWER & FIRE ALARM
ELECTRICAL

E3

F:\24030-39\24032\ELEC\24032-E3.dwg PLOTTED: May 09, 2005 - 2:59pm

06204_0047