


# GERMANIC MUSEUM FOR HARVARD UNIVERSITY

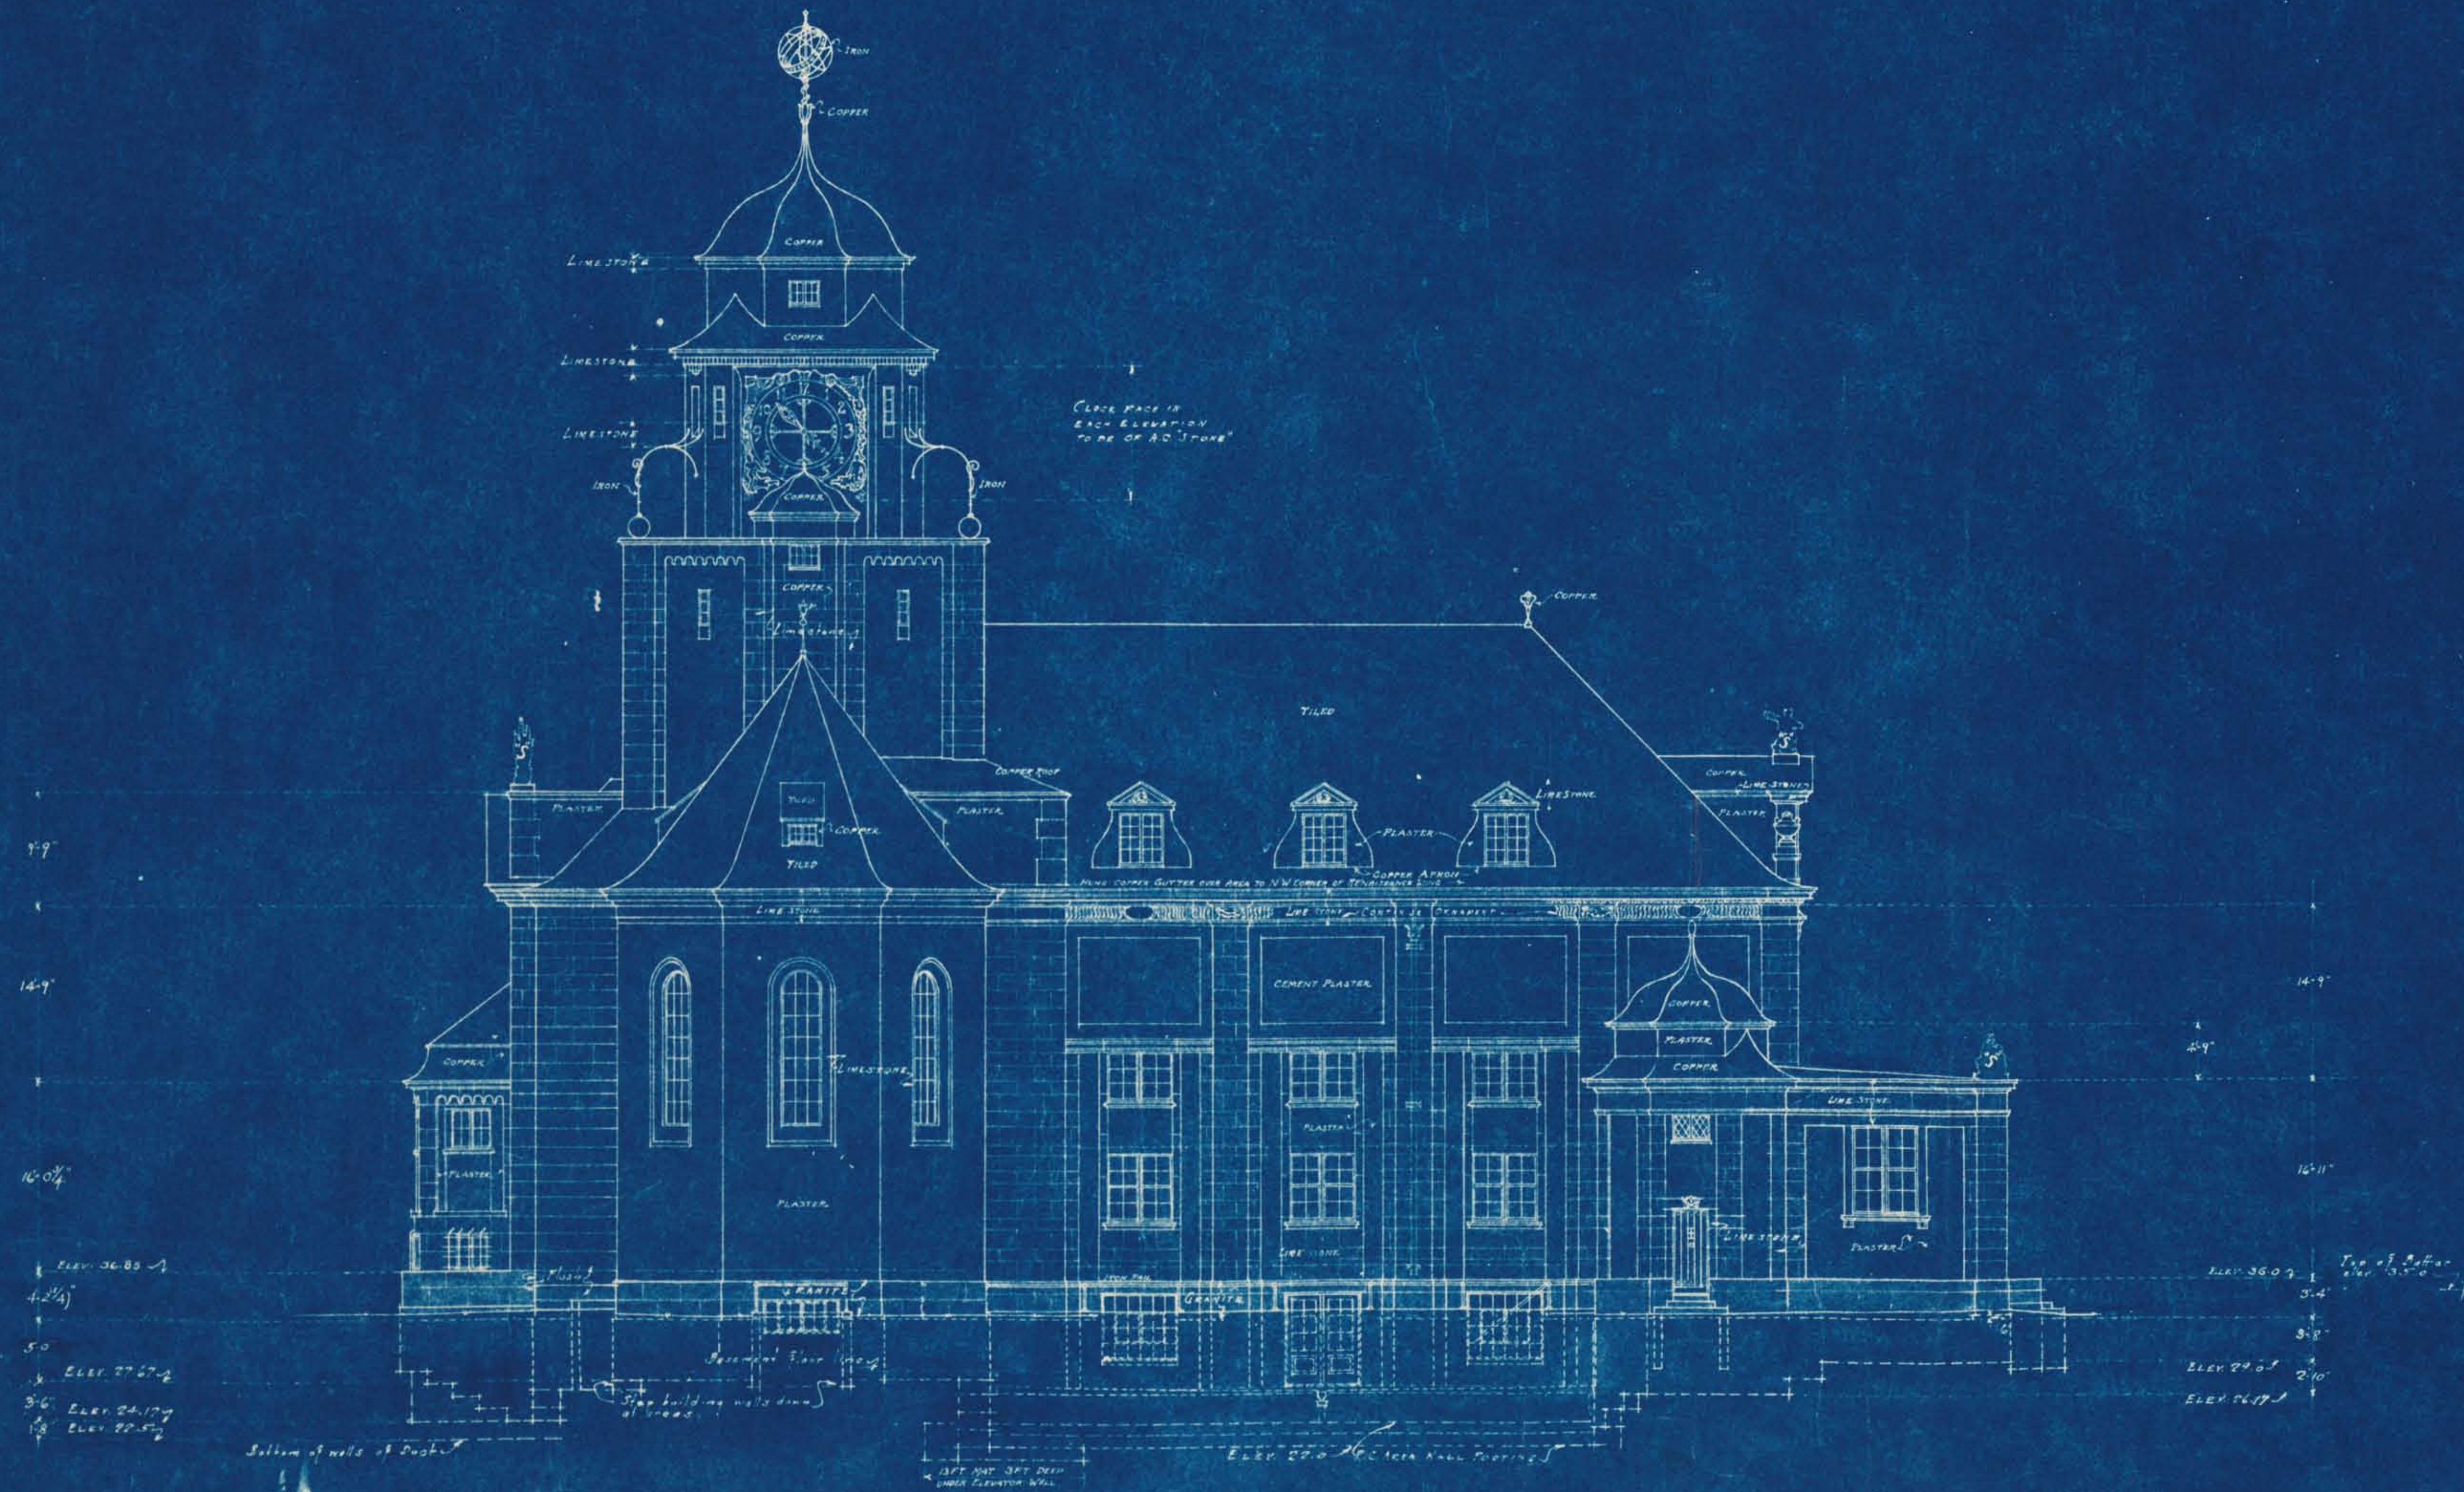

ALL STONES SHALL BE ARRANGED TO BOND WITH THE BRICK WORK AND SHALL BE LEWISED WHERE NECESSARY.

NORTH ELEVATION

SCALE 1/8" = 1'-0"  
THIS DRAWING HAS BEEN REVISED TO ACCORD WITH THE ARCHITECTS' ORDER NO. 1476 DATED AUG. 27, 1914.

DR. GERMAN BESTELMEYER,  
DRESDEN

ASSOCIATED  
ARCHITECTS

DRAWING NO. 4460

WARKEN & SMITH  
BOSTON

REPORT TO THE ARCHITECTS FOR ADJUSTMENT ANY APPARENT DISCREPANCIES OR ERRORS BEFORE EXECUTING THE WORK. SUB-CONTRACTORS AND OTHERS WHOSE WORK IS DEPENDENT UPON THAT PREVIOUSLY EXECUTED SHALL RESPECTFULLY OBTAIN AND VERIFY ALL MEASUREMENTS.

475-#14